

S.S. "EUSTON"

DETAILS OF PROPOSED OIL FUEL SETTLING TANKS

SERVICE HEAD AT TOP OF TANK - MIL.

9" B.A. stiffener

EXISTING BULKHEADS - SEAMS AND BUTTS TO BE WELDED.

NEW BULKHEADS - OF ALL-WELDED CONSTRUCTION.


WELDING TO COMPLY WITH LLOYD'S REQUIREMENTS.

EXISTING DECK PLATING FORMING CROWN OF

TANK TO BE INCREASED IN THICKNESS TO

RULE REQUIREMENTS IF FOUND NECESSARY.

Rule 27 SP 34" x 27" SP

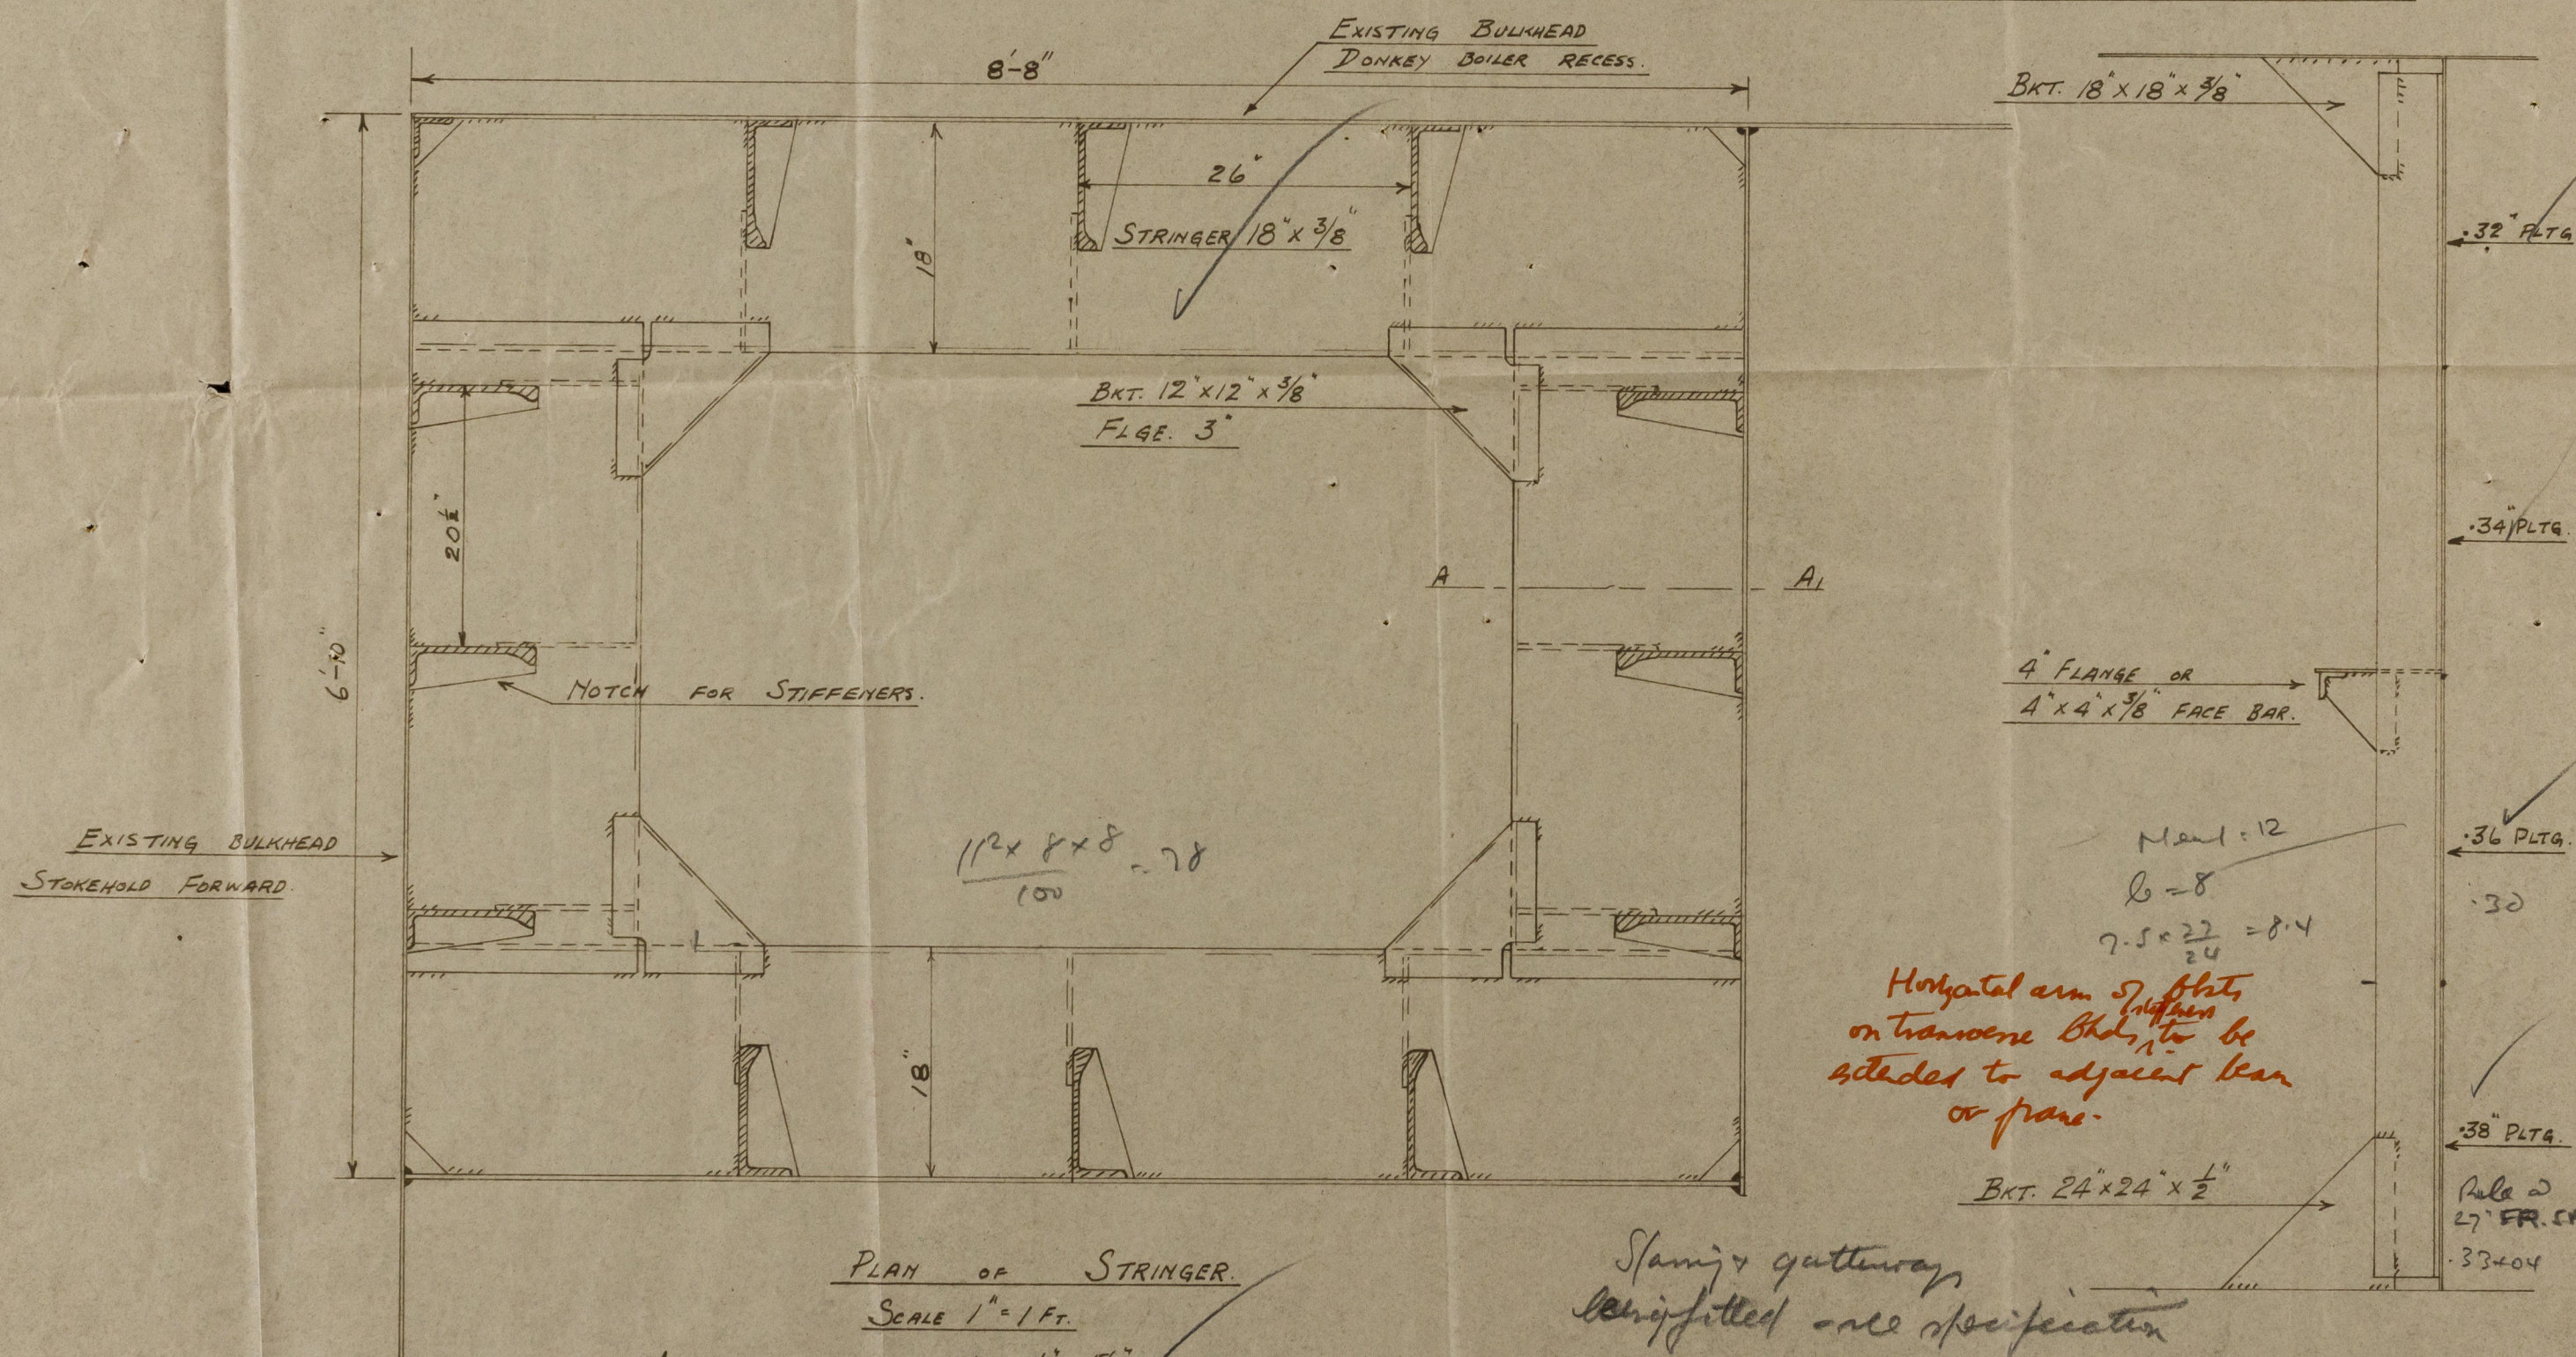

ALL STIFFENERS 10" x 3 1/2" x 3/8" B.A. BRACKETED TOP & BTM.

MISSING ALTERNATE BEAMS TO BE FITTED IN WAY TANK.


EXISTING BEAMS TO BE CROPPED IN WAY NEW LONGITUDINAL

BULKHEAD AND BRACKETED EACH SIDE.

REFERENCE DRAWINGS - S63, S64, S65, S66.



F. B. GILL	
CONSULTING NAVAL ARCHITECT	
AND MARINE ENGINEER	
Drawing No.	S87
Date:	6-53.
Drawn:	F.B.G.
Checked:	
Traced:	F.B.G.

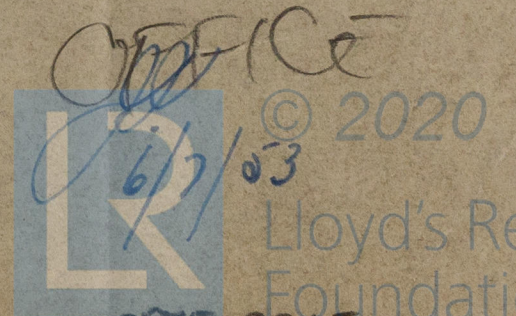

002870-002875-0065

EU STON
OF. SETTLING
THANKS

OFFICE



© 2020

Lloyd's Register
Foundation

002870-002875-0065