


SCALE 1-100

TO CLASS LLOYDS  100.A1. CARRYING PETROLEUM IN BULK

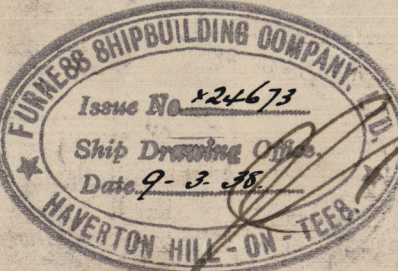

FURNESS SB C<sup>3</sup>

N<sup>o</sup> 277 + 278

PROFILE + DECK

PLANS AS BUILT.

S.S. "REBECA"

MDB. RPT. No. 16275

4



© 2020

Lloyd's Register  
Foundation

002870-002875-0160