

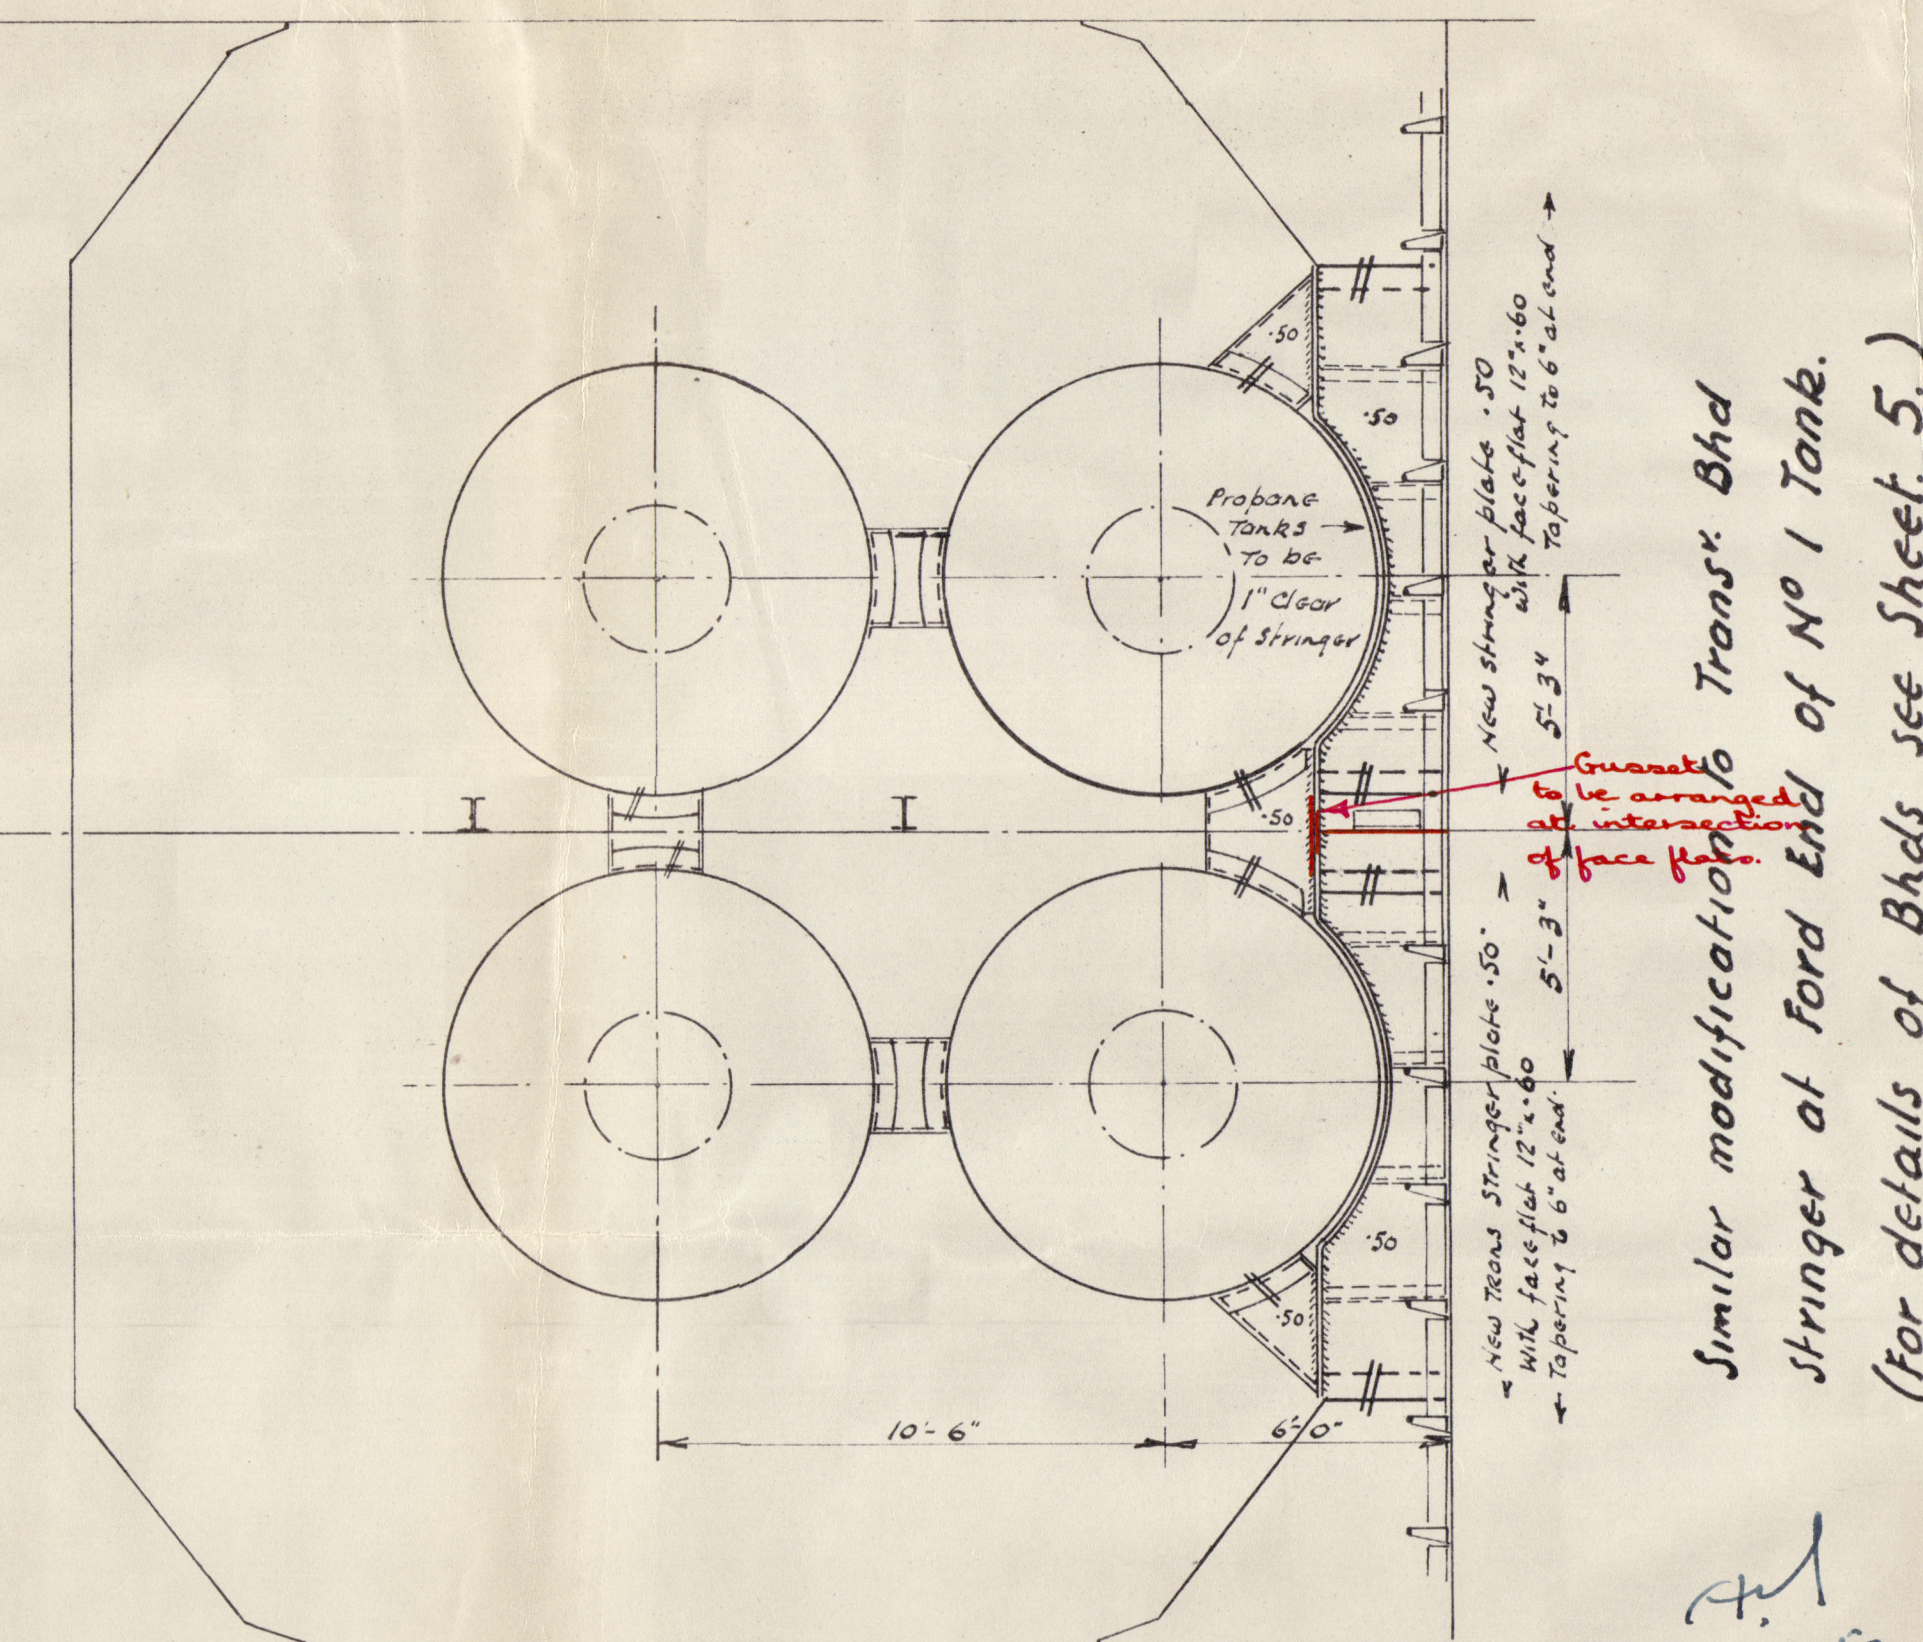
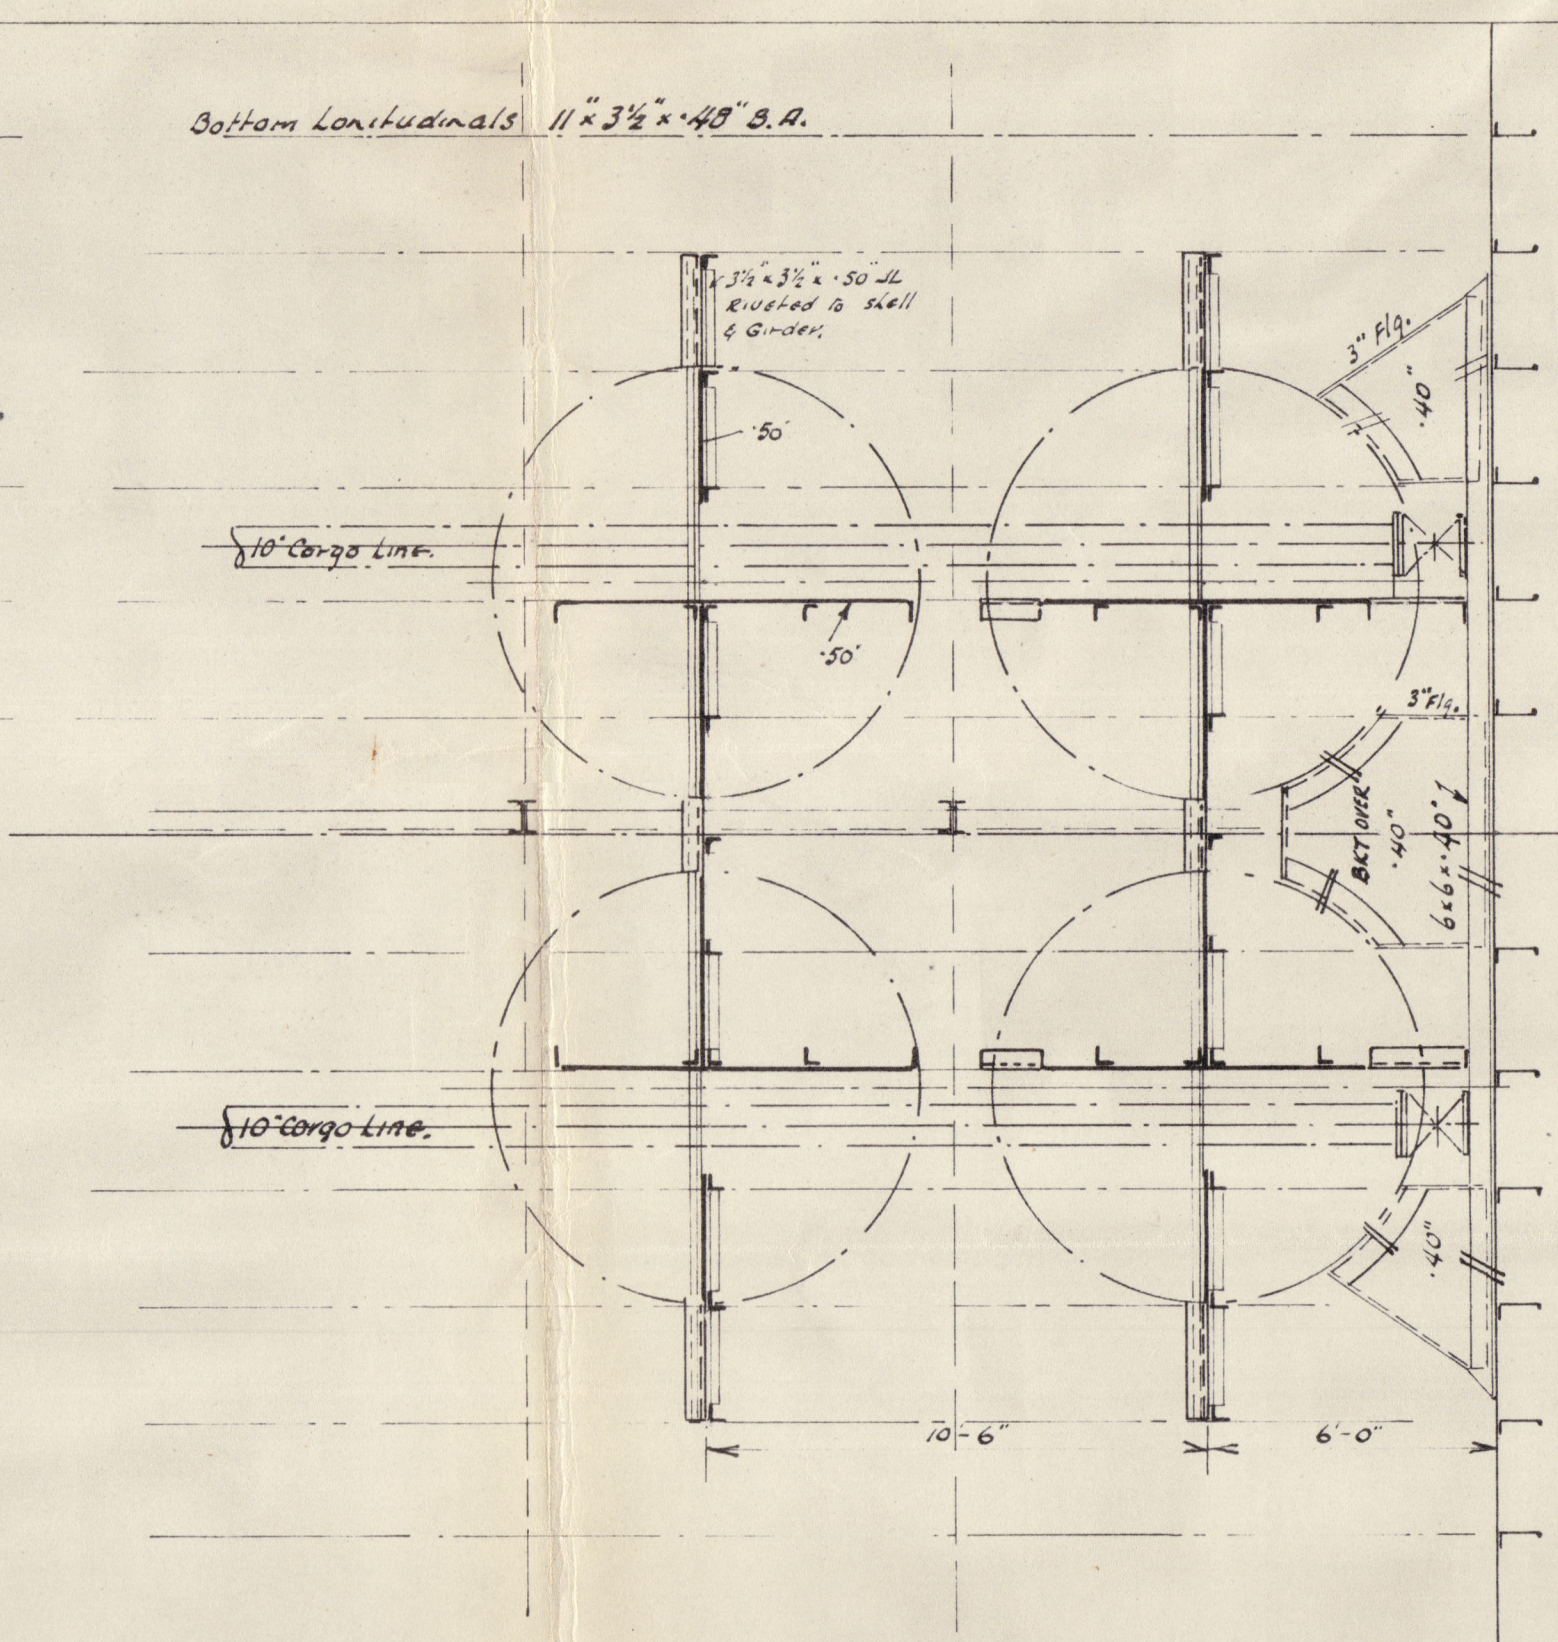


REFERENCE DRAWINGS FOR PROPANE CONVERSION SCHEME.

SHEET N°	
-do-	2 Propane containers.
-do-	3 Midship Section.
-do-	4 Trunk Deck Plating etc.
-do-	5 Transverse O.T. Bulkheads.

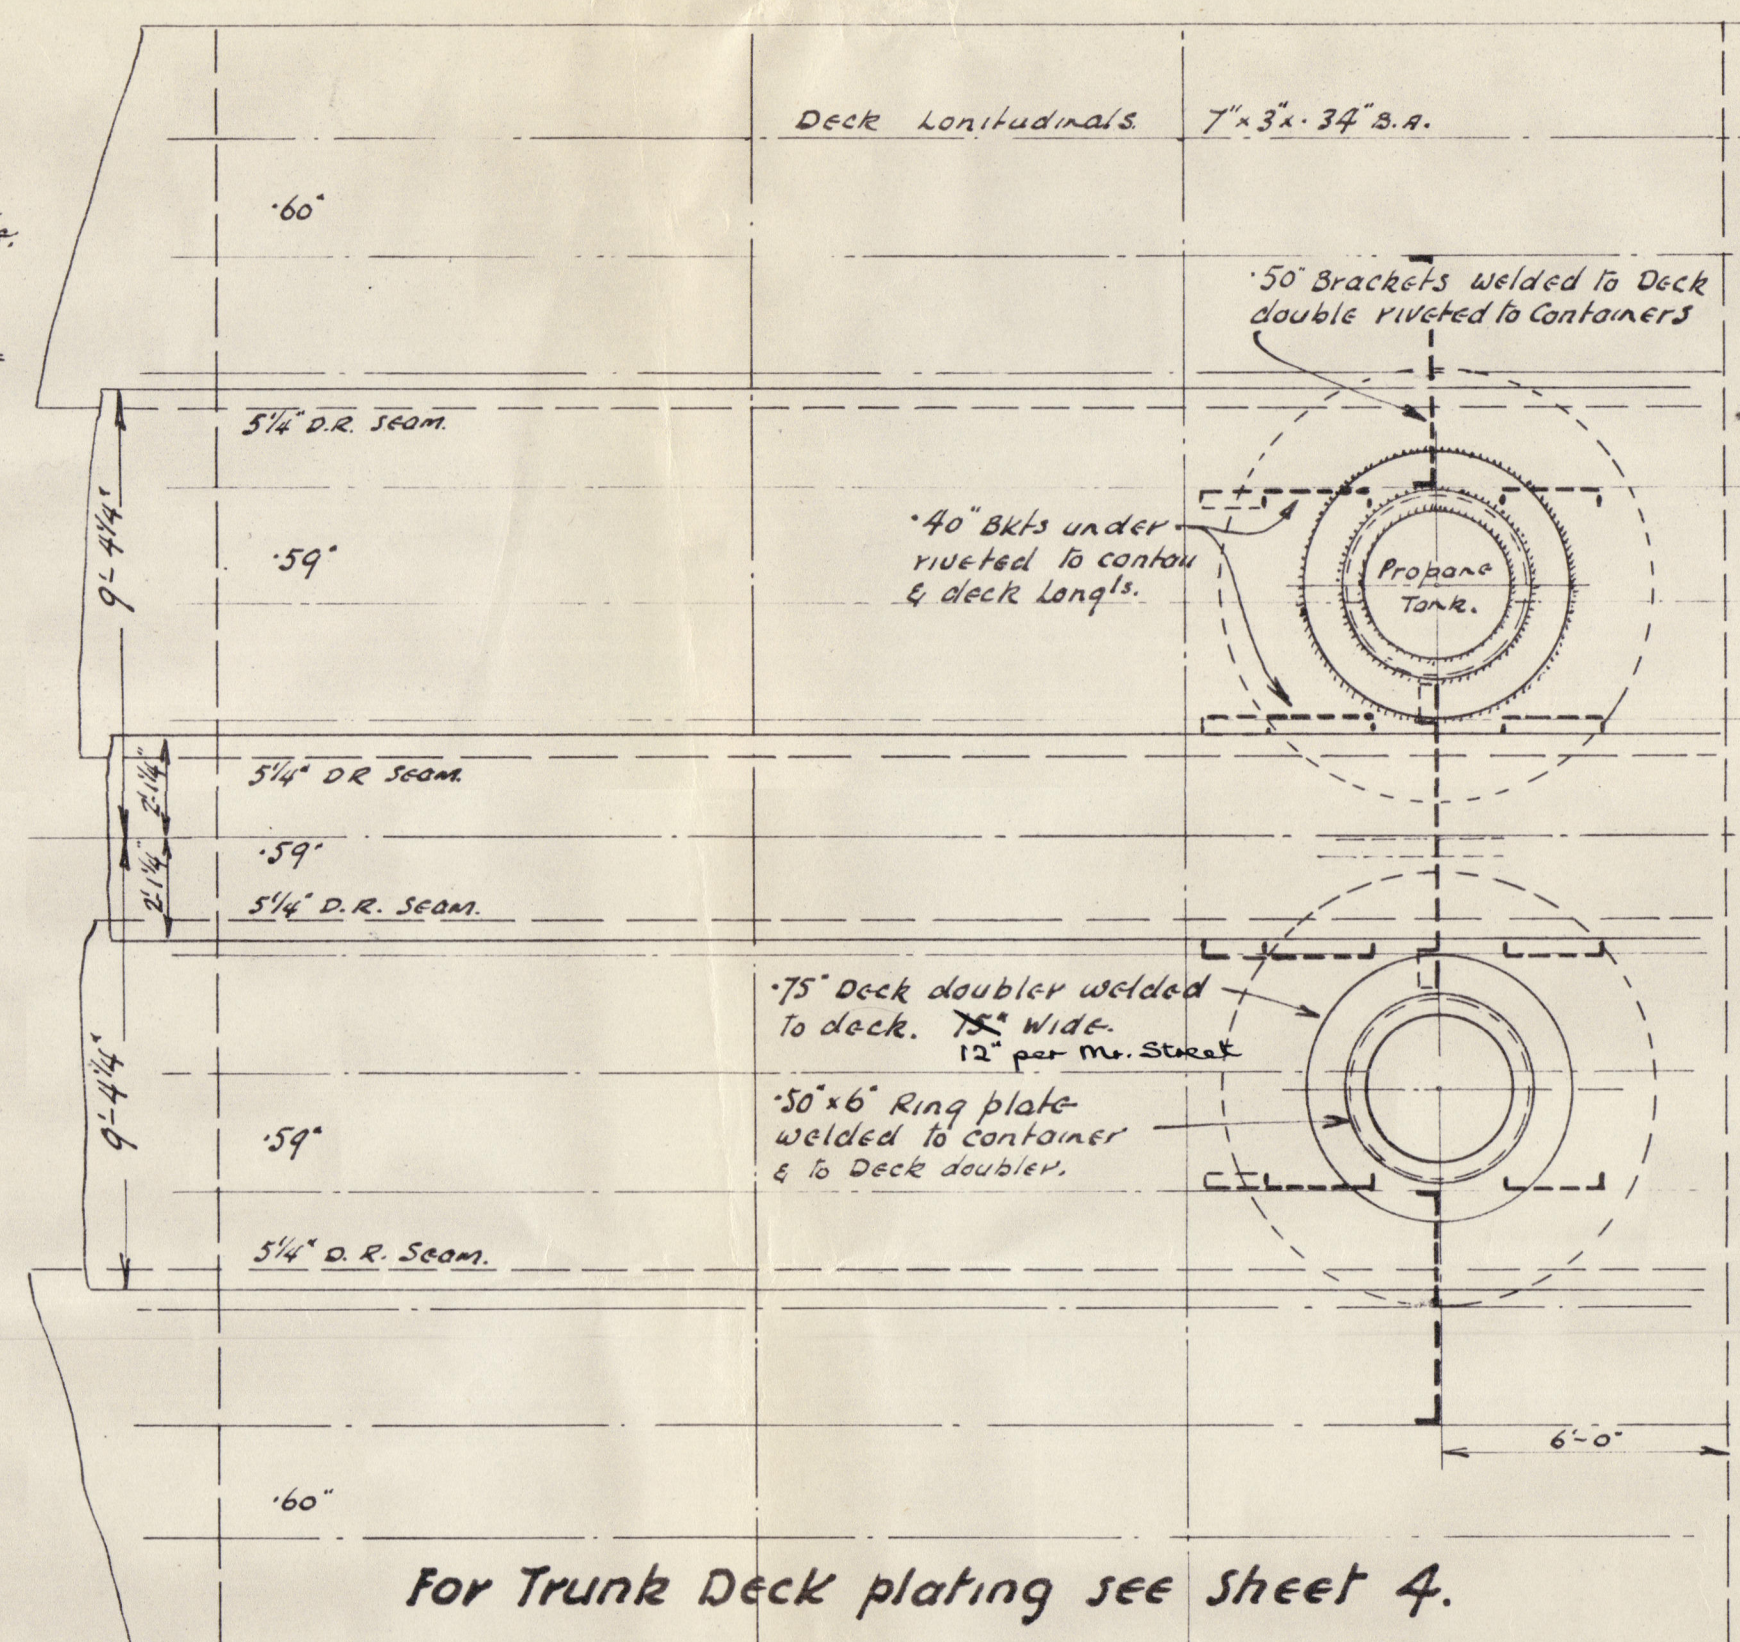

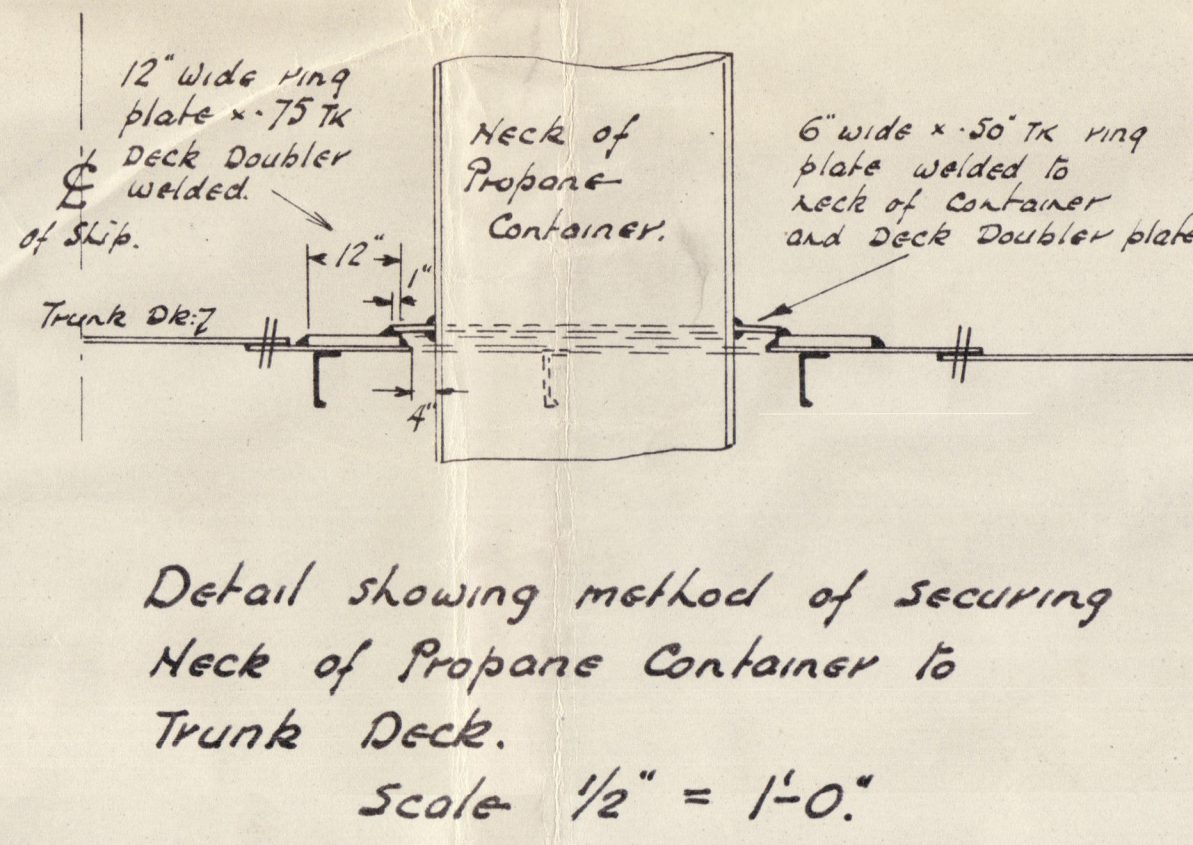

Arrog. of Turk sentings etc. (Sheet 1)

"Rebera."

002870-002875-0163



© 2020

Lloyd's Register  
Foundation