

19.3.20

PROFILE FOR SHIP NOS 3 4-16-18-19-22-23. TWIN SCREW MOTORSHIPS.

DIMENSIONS

LENGTH BETWEEN PERPENDICULARS 445' 0"
BREADTH MOULDED 60' 0"
DEPTH MOULDED TO UPPER DECK 33' 3"

SCALE 1/8" = 1' 0" SKETCH 1/4" = 1' 0" S. M.H.

TO CLASS LLOYD'S 100 A 17 (ALLOWED WITH HULLS)

DOUBLE BOTTOM ARRANGED TO CARRY OIL FUEL OF FLASH POINT ABOVE 150° FAH.

SCANTLING NUMBERS

B + D = 60 - 33.33 = 26.67 TRANSVERSE NUMBER

L (B + D) = 445 x 26.67 = 11850 LONGITUDINAL NUMBER



1/19.4

PROPORTIONS

L 445' 0" 60' 0" 7417

L 445' 0" 60' 0" 10.34

NOTE: TUBES OF WELDED MATERIAL HAVING
A TENSILE STRENGTH OF 22-27 TONS PER SQUARE

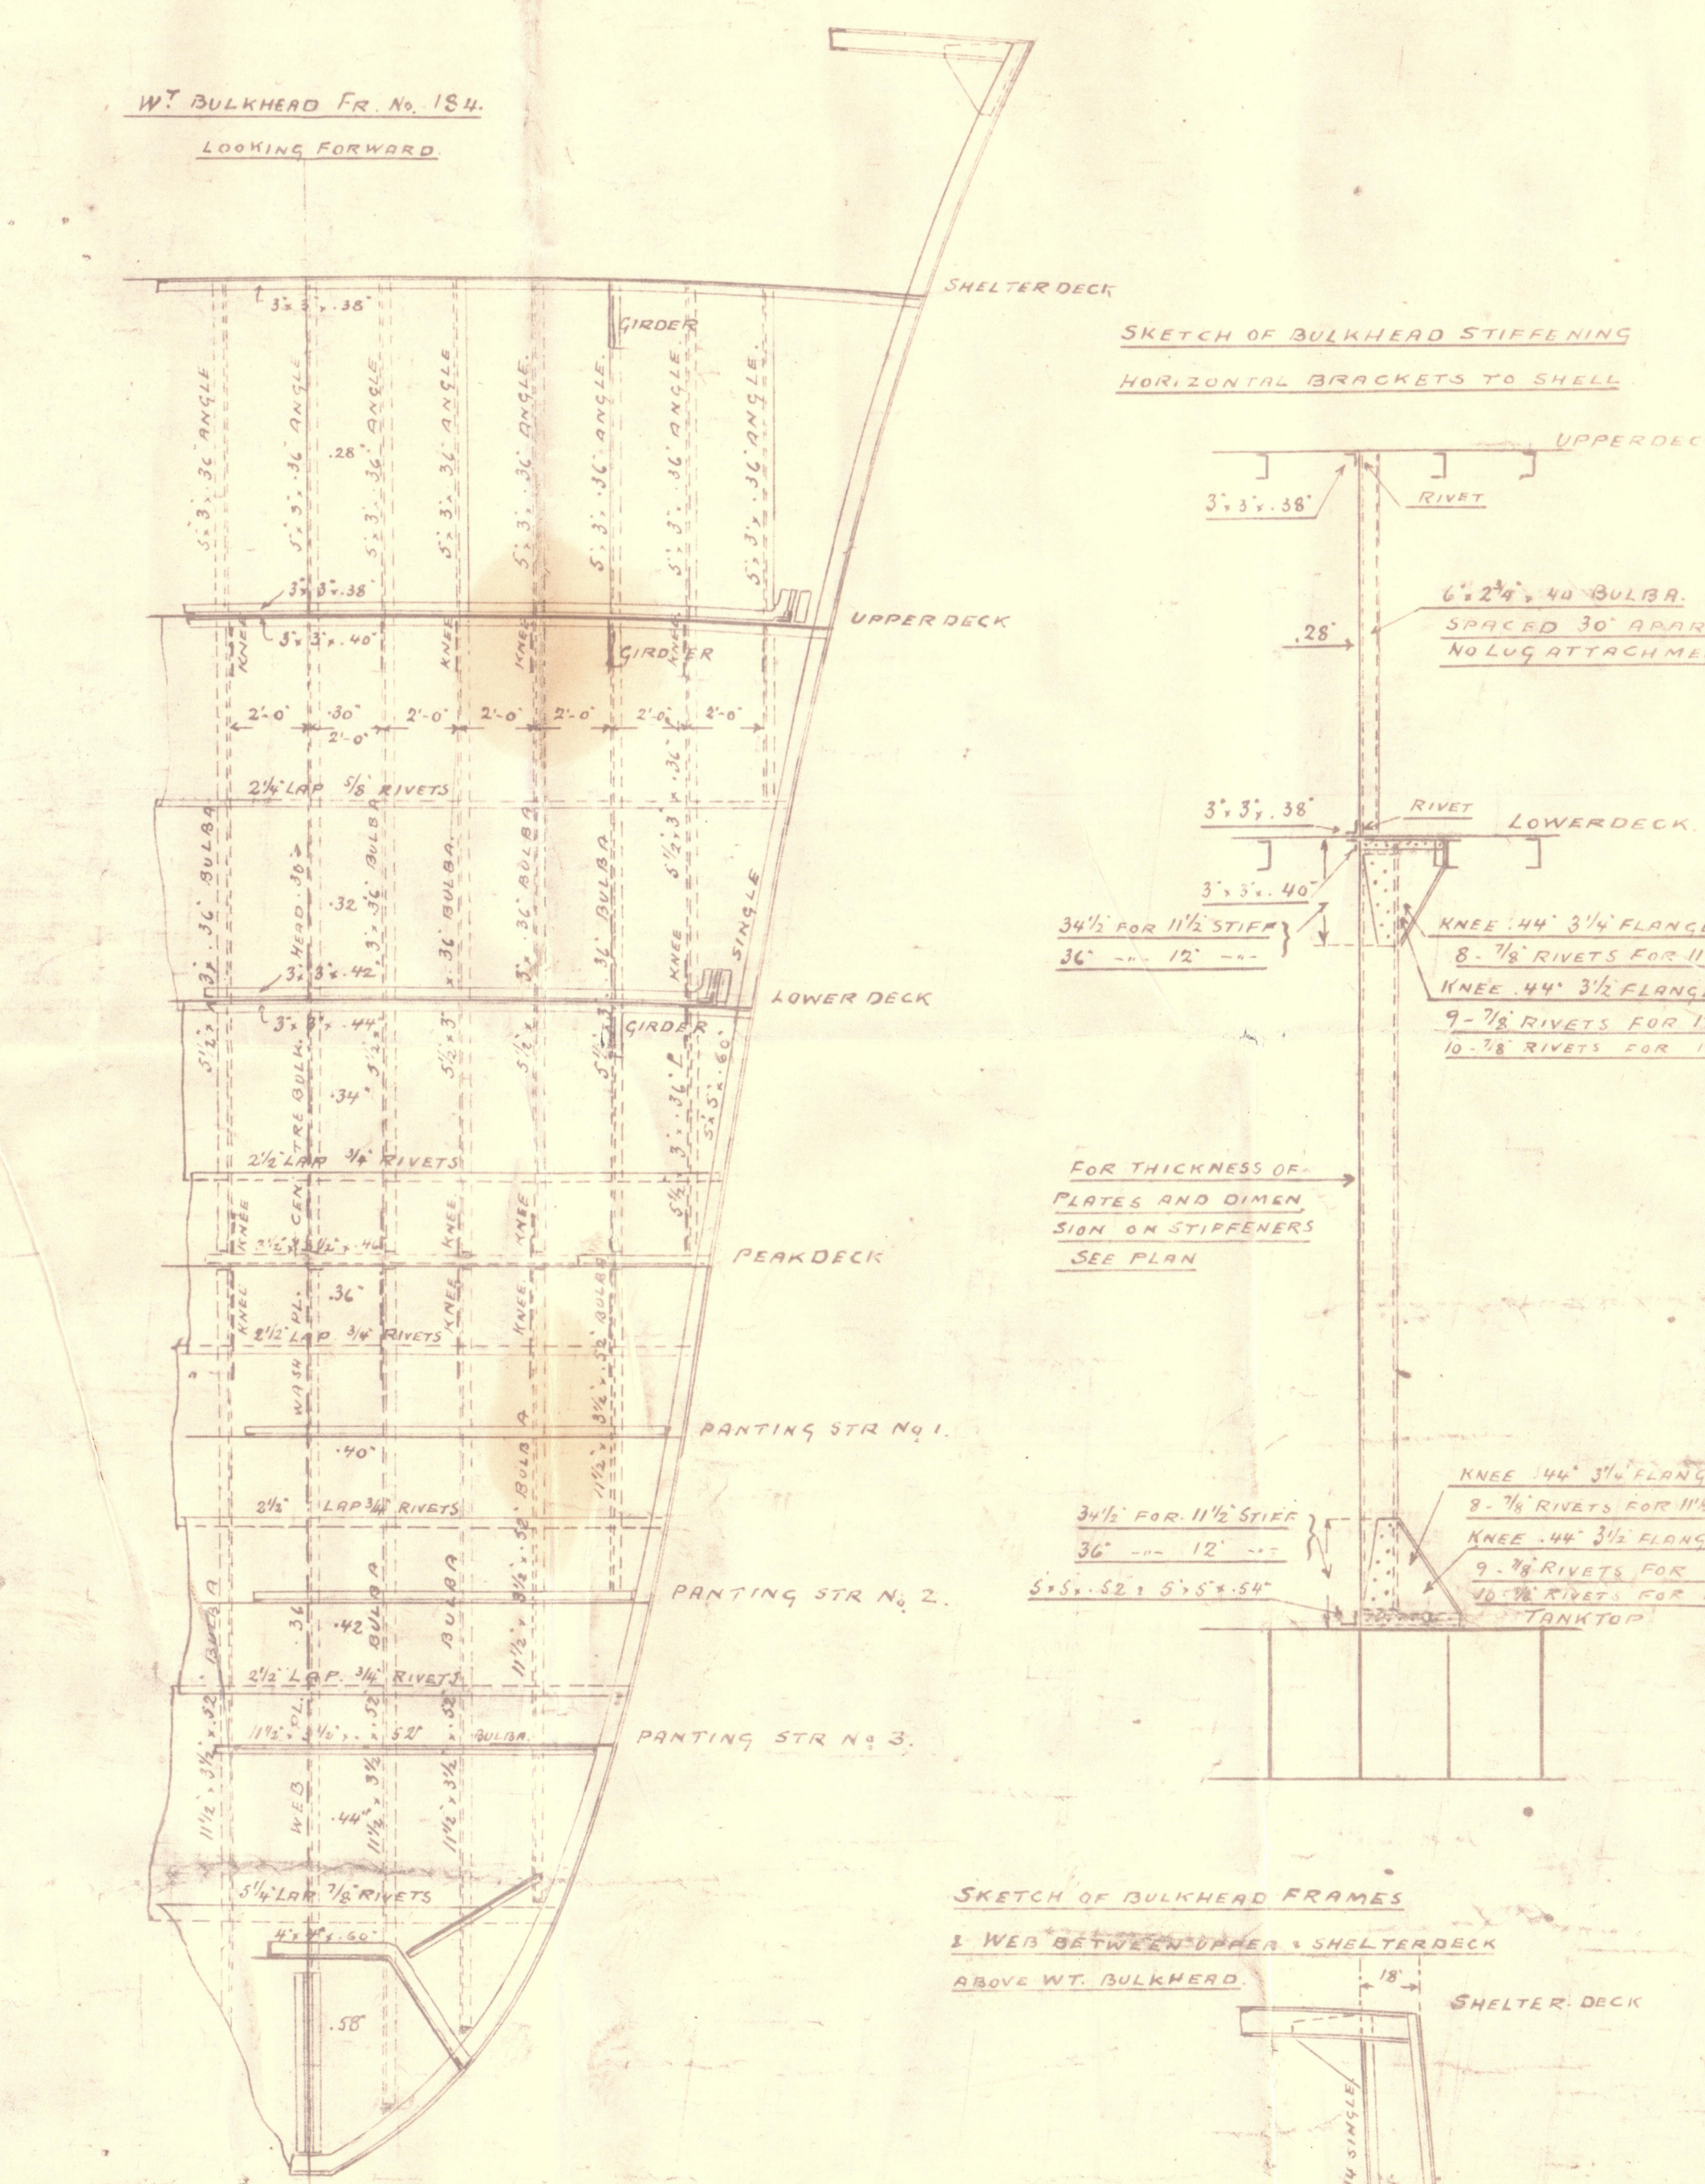
 


Nakken Skibsværft


Nº3

Profile + Deck Plans.

Duplierte

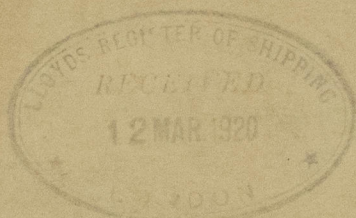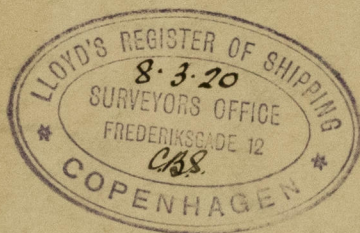

m/s Java, Gen. Rpt. No. 6217.

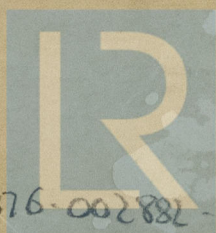

© 2020

Lloyd's Register
Foundation

002876-002882-0288