

T.S.S. "COBARCO."

MIDSHIP SECTION.

SCALE 1/2 INCH = 1 FOOT.



CLASS BRITISH CORPORATION B.S.*

MOULDED DIMENSIONS:- 190'-0" x 34'-4" x 11'-6" TO UPPER DECK.
15'-6" TO R.Q. DECK.

	1/2 L. &	ENDS.	REMARKS.
KEEL STRAKE	TREBLE STRAPS	DOUBLE STRAPS	TREBLE STRAPS ALL F & A
CENTRE GIRDER	DOUBLE LAPS	DOUBLE LAPS	WHERE NOT EXCEEDING 42
FOUNDATION PLATE			WHERE NOT EXCEEDING 42
SHELL PLATING ON BOTTOM			TREBLE STRAPS ON FLAT OF BOTTOM ALL F & A
UPPER DECK SHEERSTRAKE	TREBLE LAPS		
QUARTER	DOUBLE LAPS		
TOPSIDE PLATING			
BULWARK	SINGLE LAPS	SINGLE LAPS	
SHELL PLATING ELSEWHERE	DOUBLE LAPS	DOUBLE LAPS	
UPPER DECK STRINGER PLATE	TREBLE LAPS		
QUARTER	DOUBLE LAPS		
UPPER DECK PLATING			
QUARTER			
FORECASTLE DECK STRINGER	SINGLE LAPS	SINGLE LAPS	
BRIDGE	DOUBLE LAPS		
W.T. FLAT AFT		DOUBLE LAPS	
FORECASTLE DECK PLATING	SINGLE LAPS	SINGLE LAPS	
BRIDGE			
W.T. FLAT AFT DECK PLATING		SINGLE LAPS	
EDGE RIVETING			
SHEERSTRAKES	DOUBLE LAPS	DOUBLE LAPS	
PLATING BELOW UPPER TURN			
ABOVE			
DECK STRINGERS	SINGLE LAPS	SINGLE LAPS	
DECK PLATING			

EQUIPMENT TONNAGE		
TONNAGE UNDER FREEBOARD DECK	190 x 34.33 x 11.5 x 75	503
RAISED QUARTER DECK	111 x 34.33 x 4 x 75	77
FORECASTLE DECK	34 x 34.33 x 7.25 x 75	42
BRIDGE DECK	64 x 34.33 x 7.25 x 75	60
	200	682

EQUIPMENT C = 20.
2 BOWERS EACH 16 CENTS. STOCK LESS.
1 BOWER 13 1/2 x
1 STREAM ANCHOR 5 1/2 x Ex STOCK.
1 KEDGE 2 1/2 x
210 FATHOMS 1 1/2" STUD LINK CHAIN CABLE.
60 3" STEEL WIRE.
75 2 1/2 x 1/2" STEEL WIRE TOWLINE.
1 OFF 90 FATHOMS 1 1/2" MANILLA WARP.
1 OFF 90 4 1/2" x

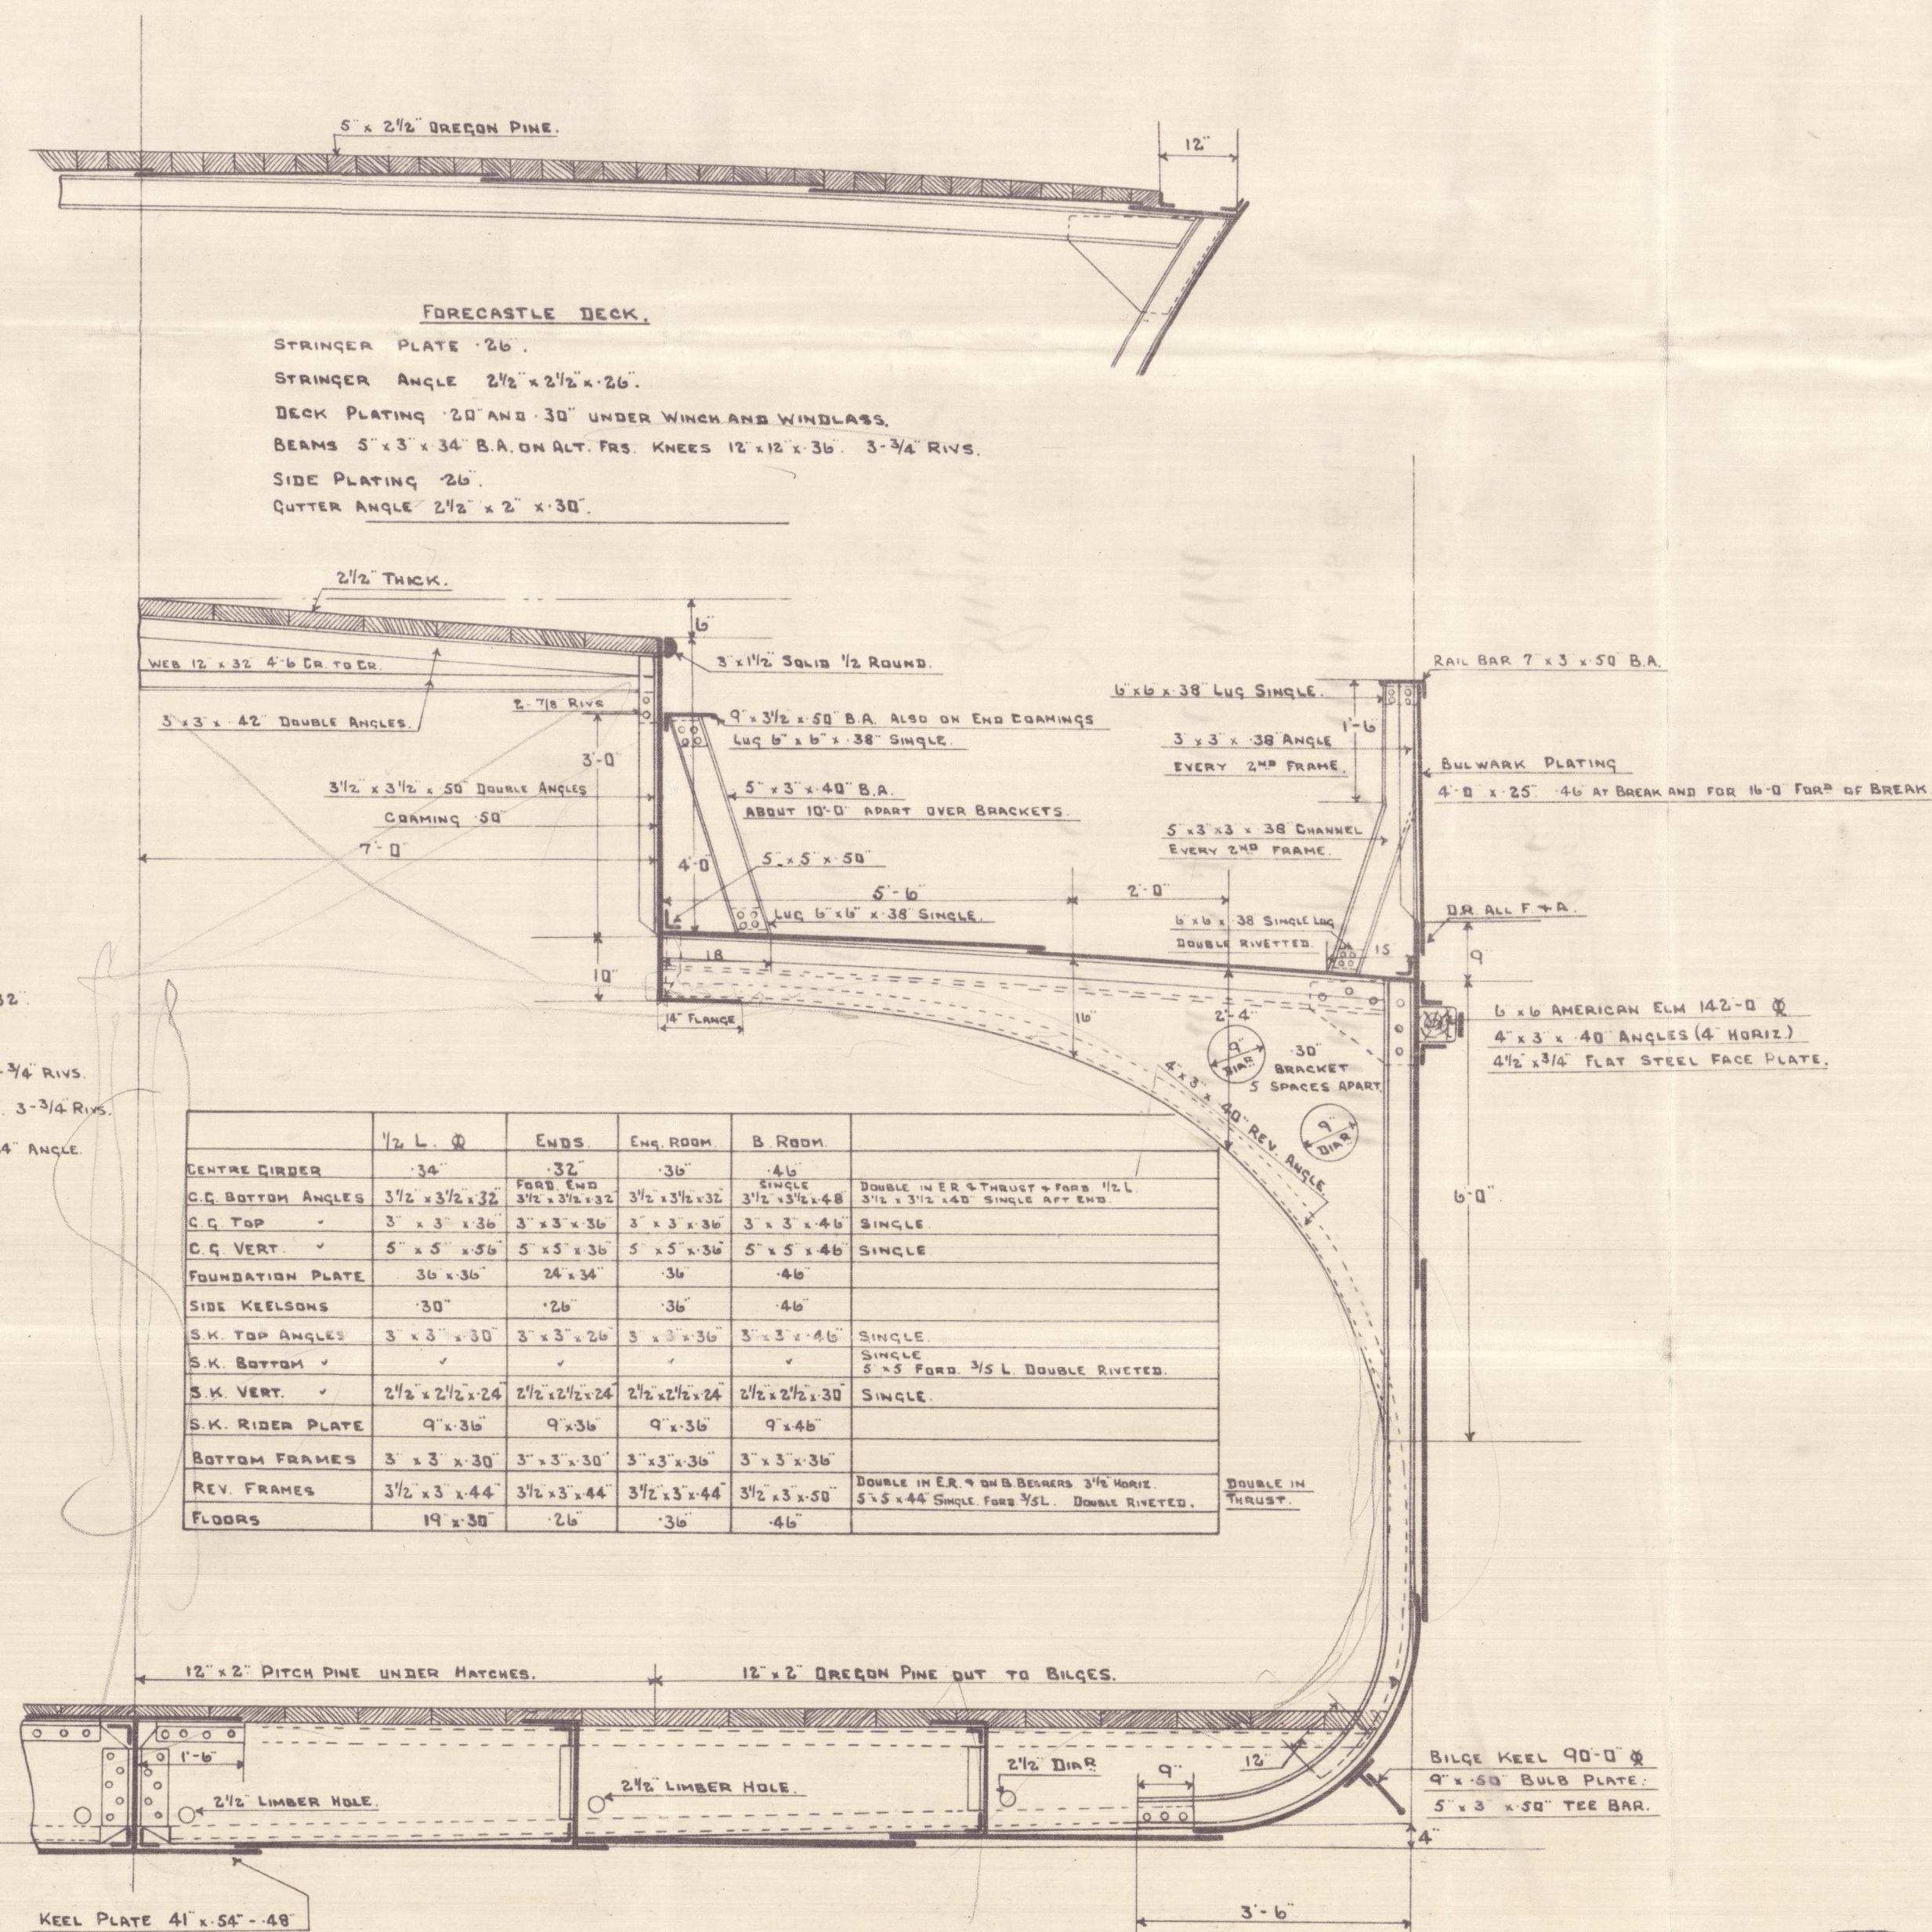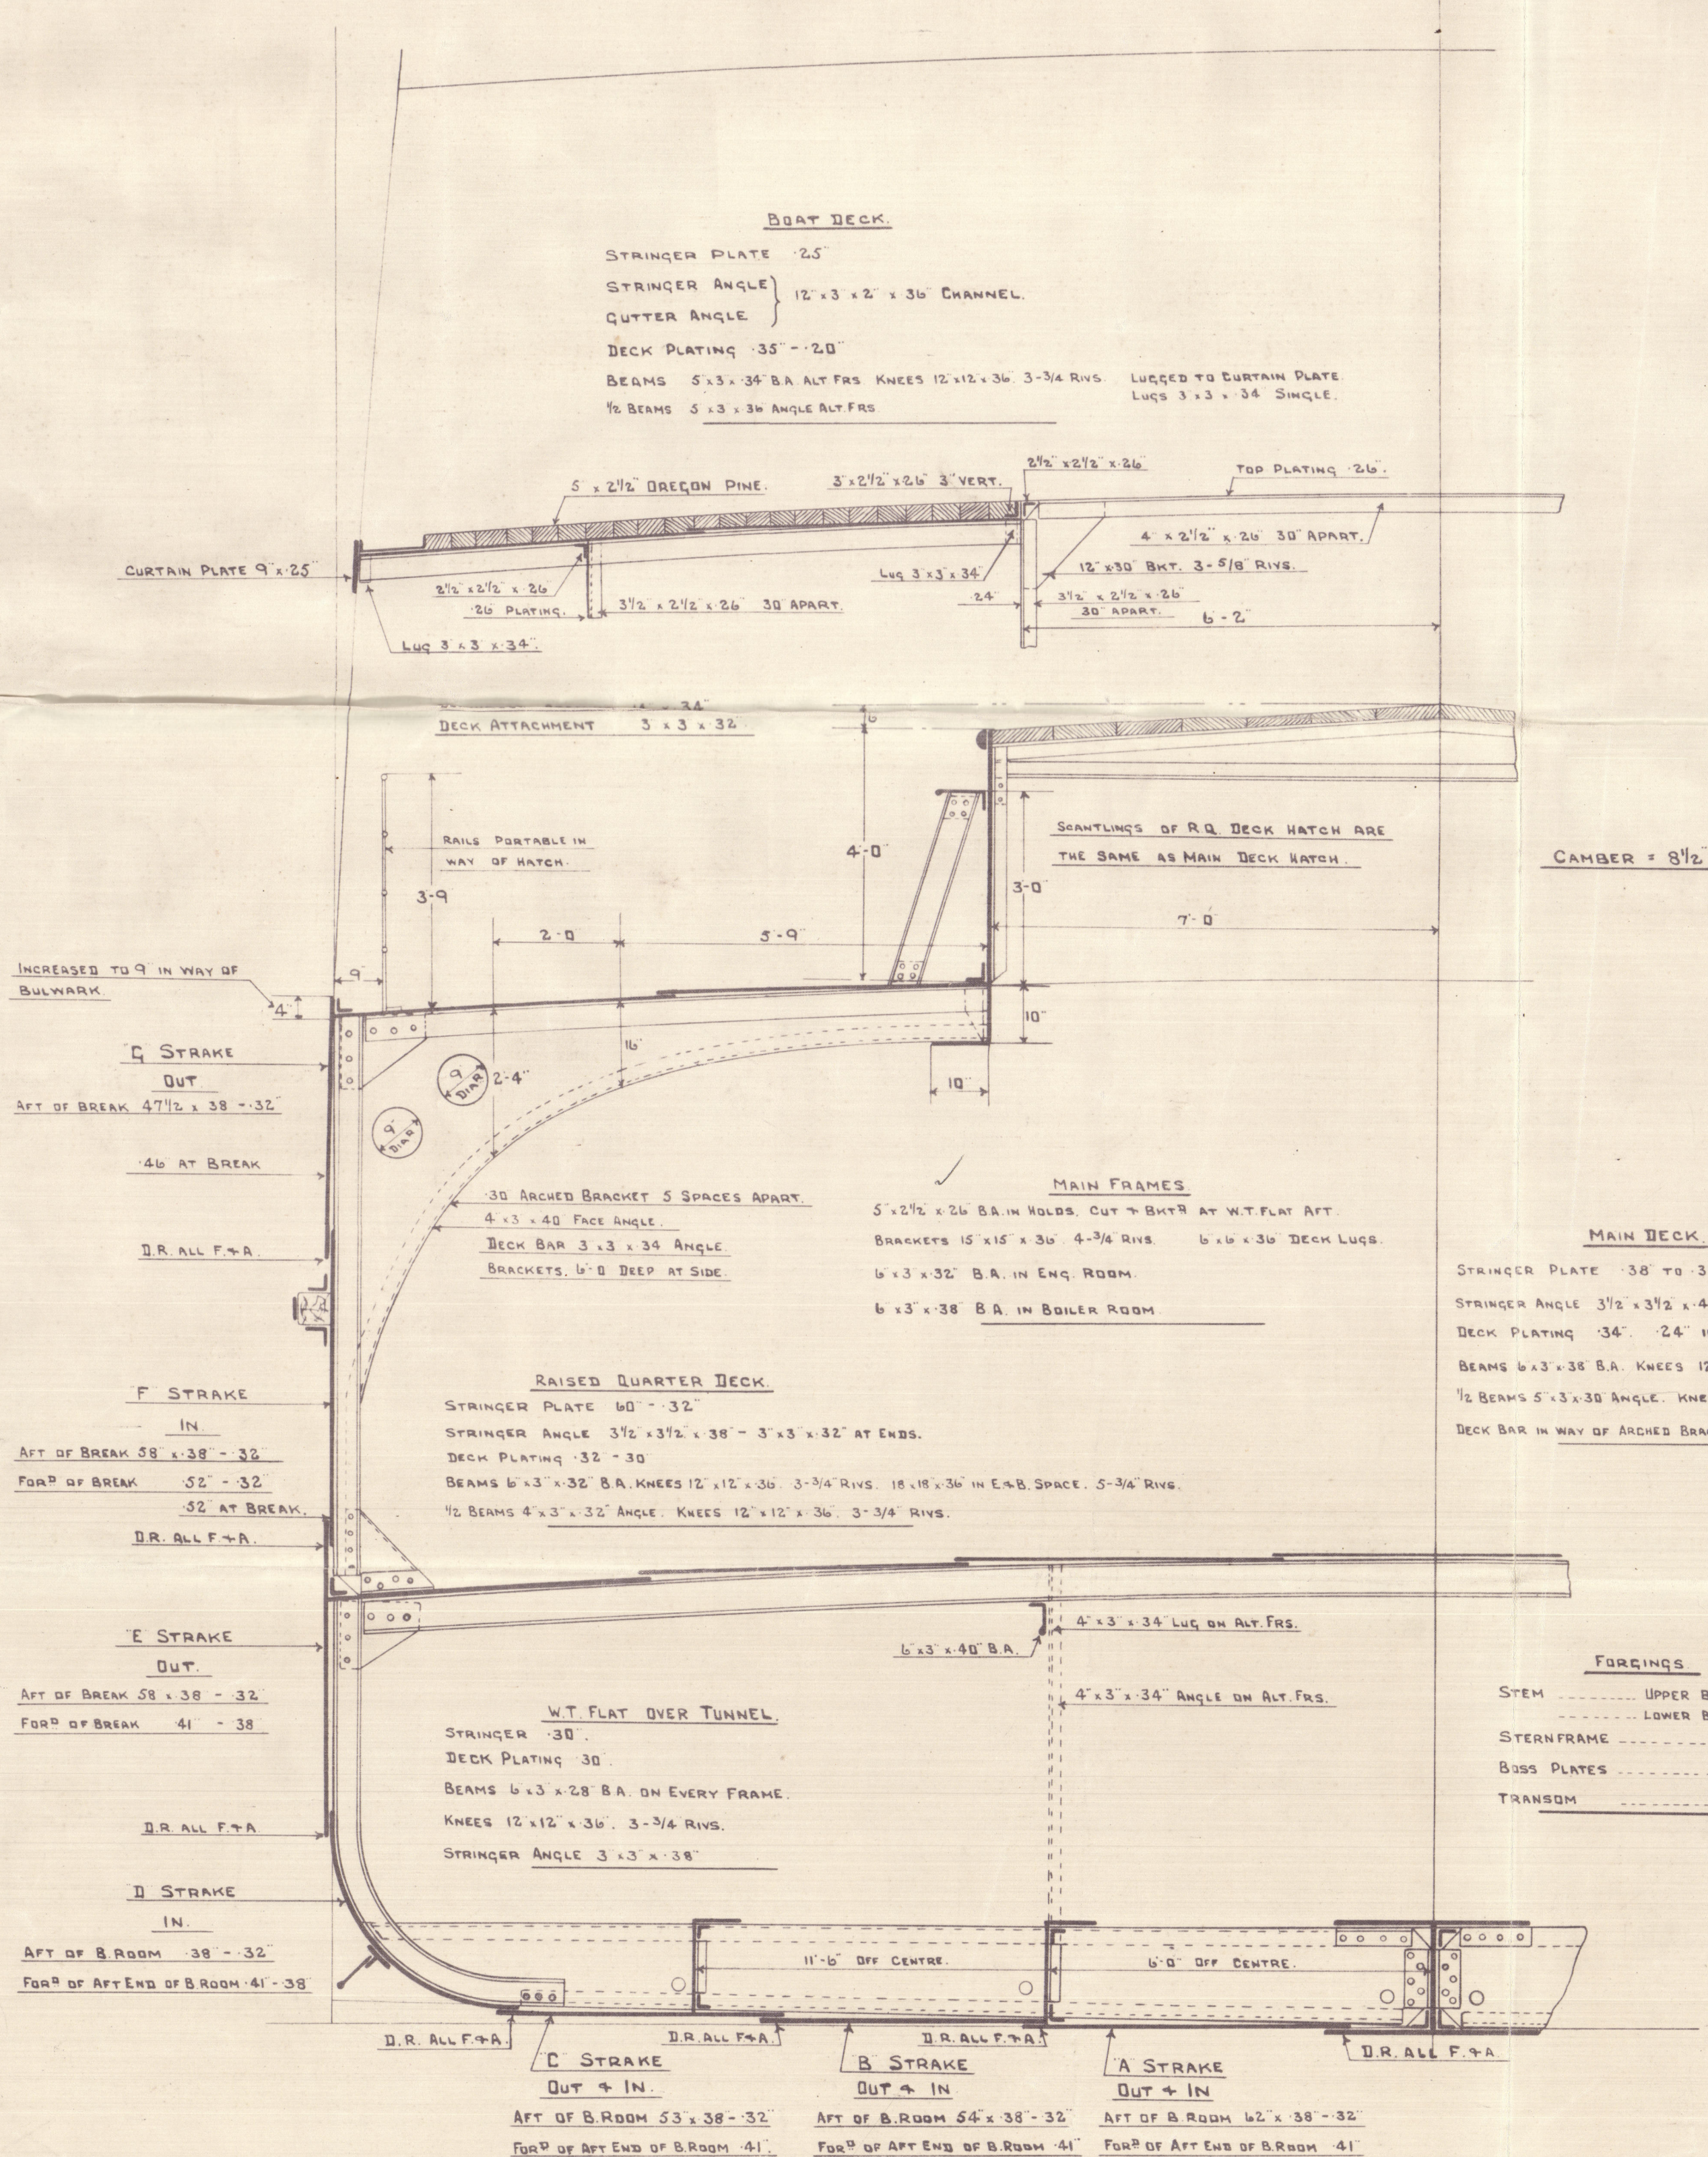

	1/2 L. &	ENDS.	ENG. ROOM	B. ROOM
CENTRE GIRDER	.34	.32	.30	.46
C.G. BOTTOM ANGLES	3 1/2 x 3 1/2 x 32	3 1/2 x 3 1/2 x 32	3 1/2 x 3 1/2 x 32	3 1/2 x 3 1/2 x 48
C.G. TOP	3 x 3 x 36	3 x 3 x 36	3 x 3 x 36	3 x 3 x 46
C.G. VERT.	5 x 5 x 36	5 x 5 x 36	5 x 5 x 36	5 x 5 x 46
FOUNDATION PLATE	36 x 36	24 x 34	36	46
SIDE KEELSONS	.30	.26	.36	.46
S.K. TOP ANGLES	3 x 3 x 30	3 x 3 x 26	3 x 3 x 36	3 x 3 x 46
S.K. BOTTOM				SINGLE
S.K. VERT.	2 1/2 x 2 1/2 x 24	2 1/2 x 2 1/2 x 24	2 1/2 x 2 1/2 x 24	2 1/2 x 2 1/2 x 30
S.K. RIDER PLATE	9 x 36	9 x 36	9 x 36	9 x 46
BOTTOM FRAMES	3 x 3 x 30	3 x 3 x 30	3 x 3 x 36	3 x 3 x 36
REV. FRAMES	3 1/2 x 3 x 44	3 1/2 x 3 x 44	3 1/2 x 3 x 44	3 1/2 x 3 x 50
FLOORS	19 x 30	.26	.36	.46



Ailsa No 410

Mid Sect. As given

Plan No. Bag 22.

002883-002890-0098



© 2020

Lloyd's Register
Foundation

22

Midship Section. [AS BUILT.]

Ailsa S.B. Co. Ltd.

No. 410.

Reference

"Cobargo"



© 2020

Lloyd's Register
Foundation

002883-002890-0098