


S.S. "JOHN CHARRINGTON"


PROPOSED MODIFICATIONS TO ACCOMMODATION.

SCALE: 1/4" = 1 FOOT.


FIREMENS ACCOMMODATION ON RAISED QUARTER DECK.

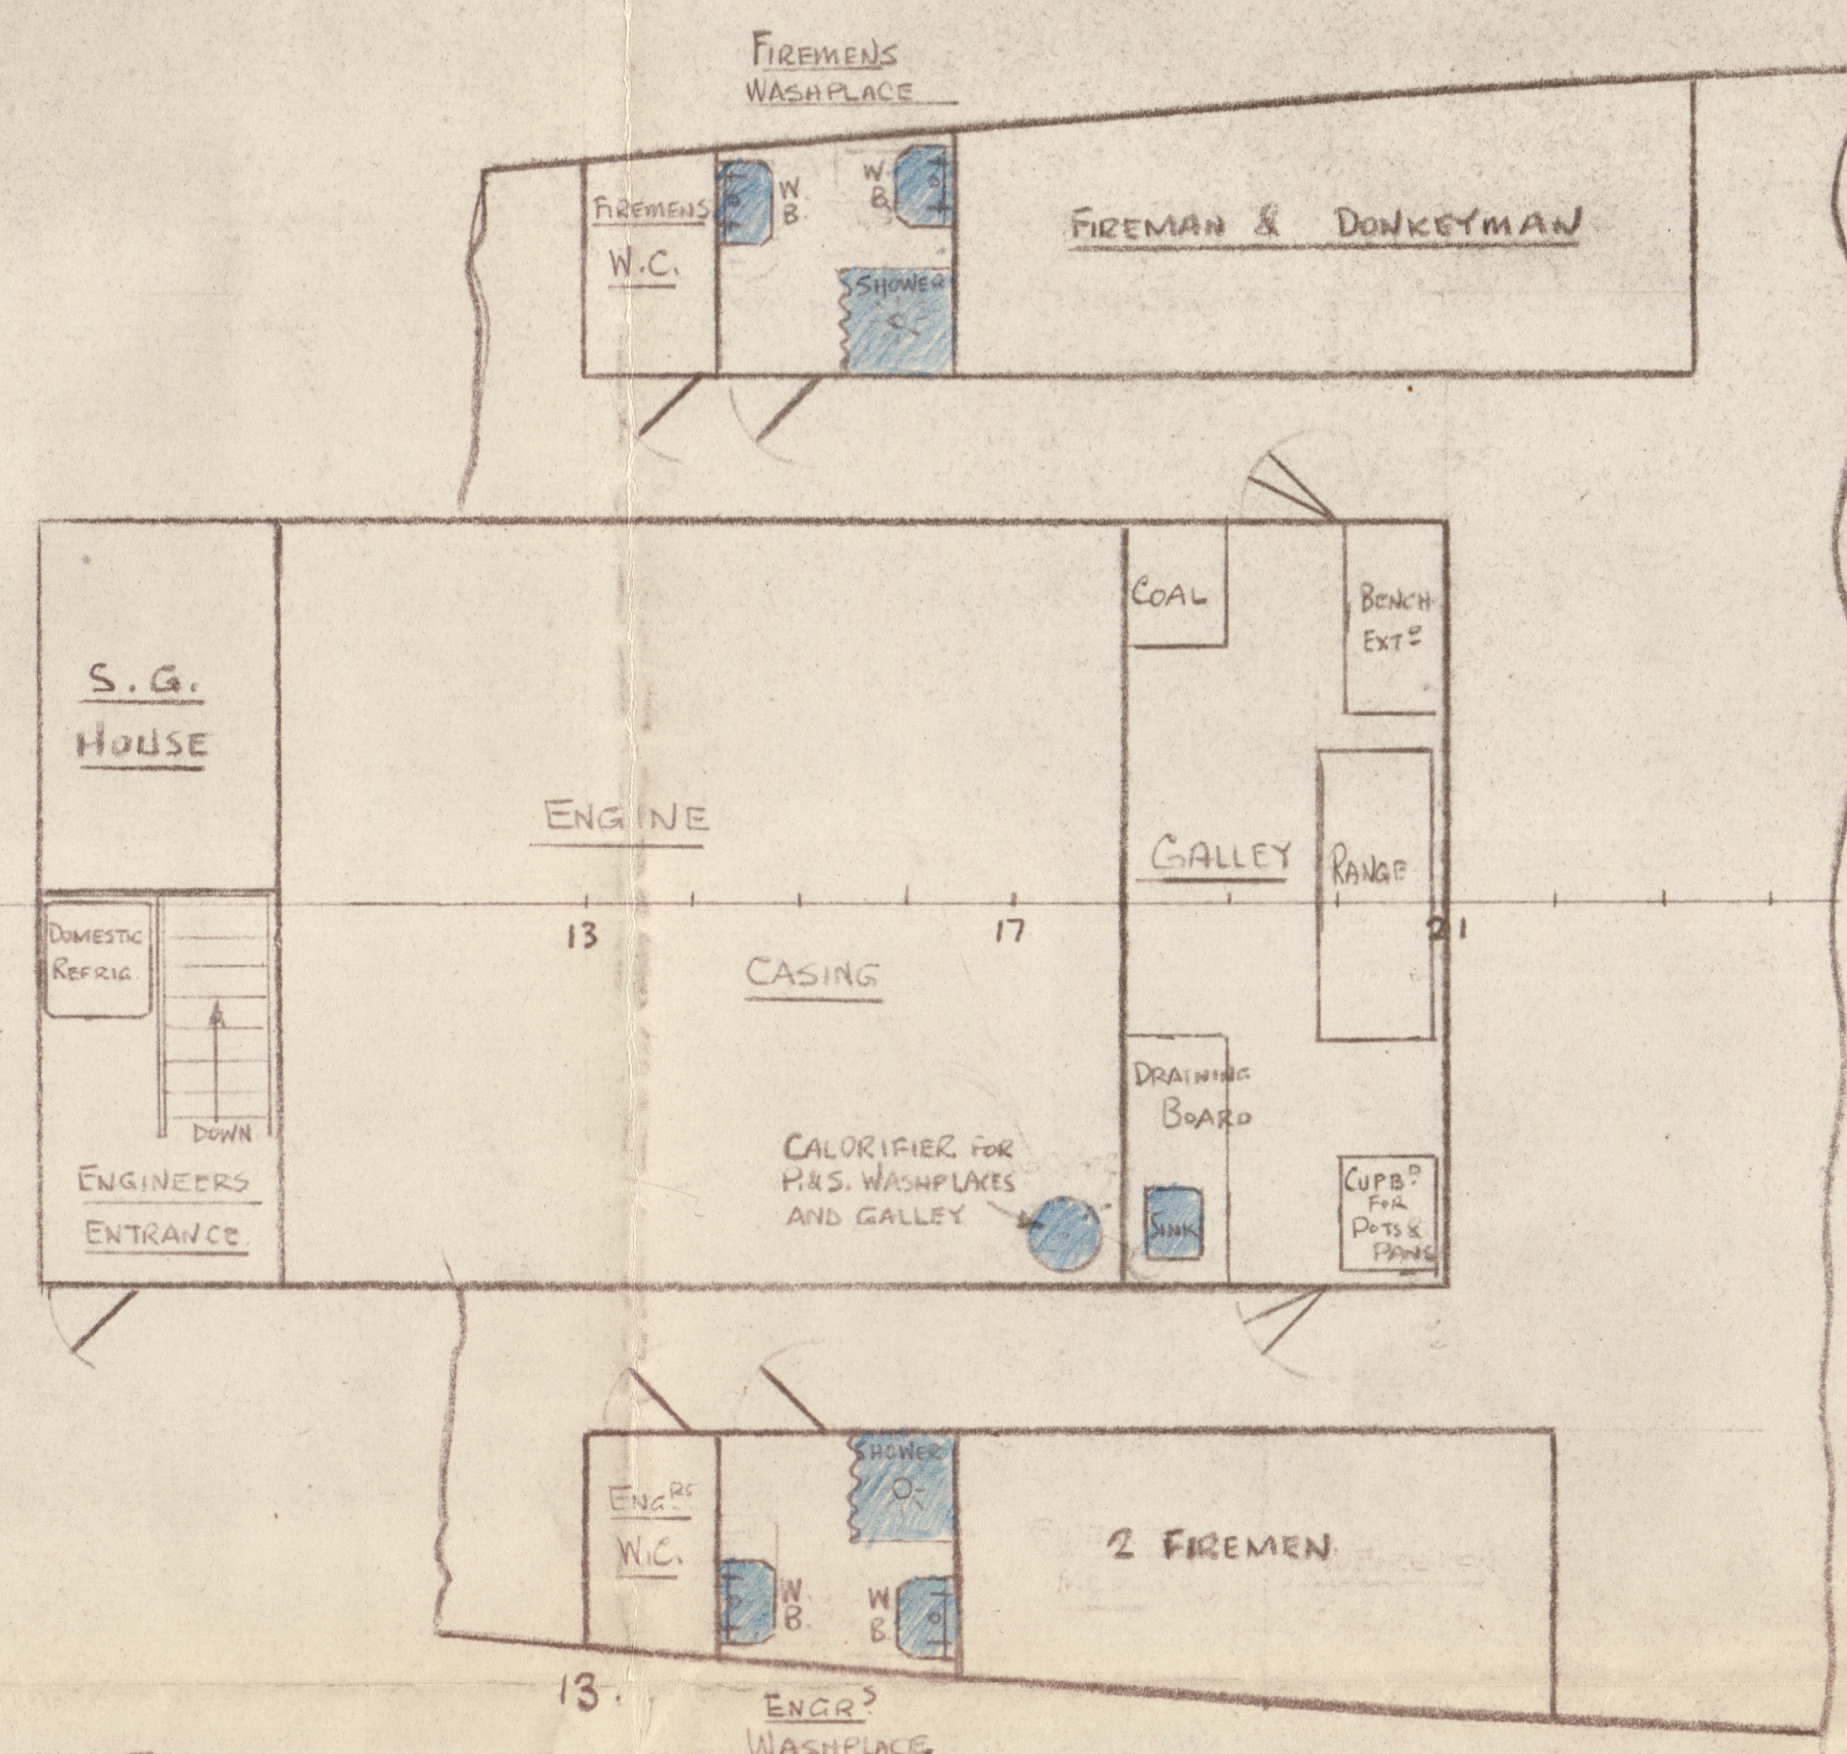


ENGINEERS FLAT

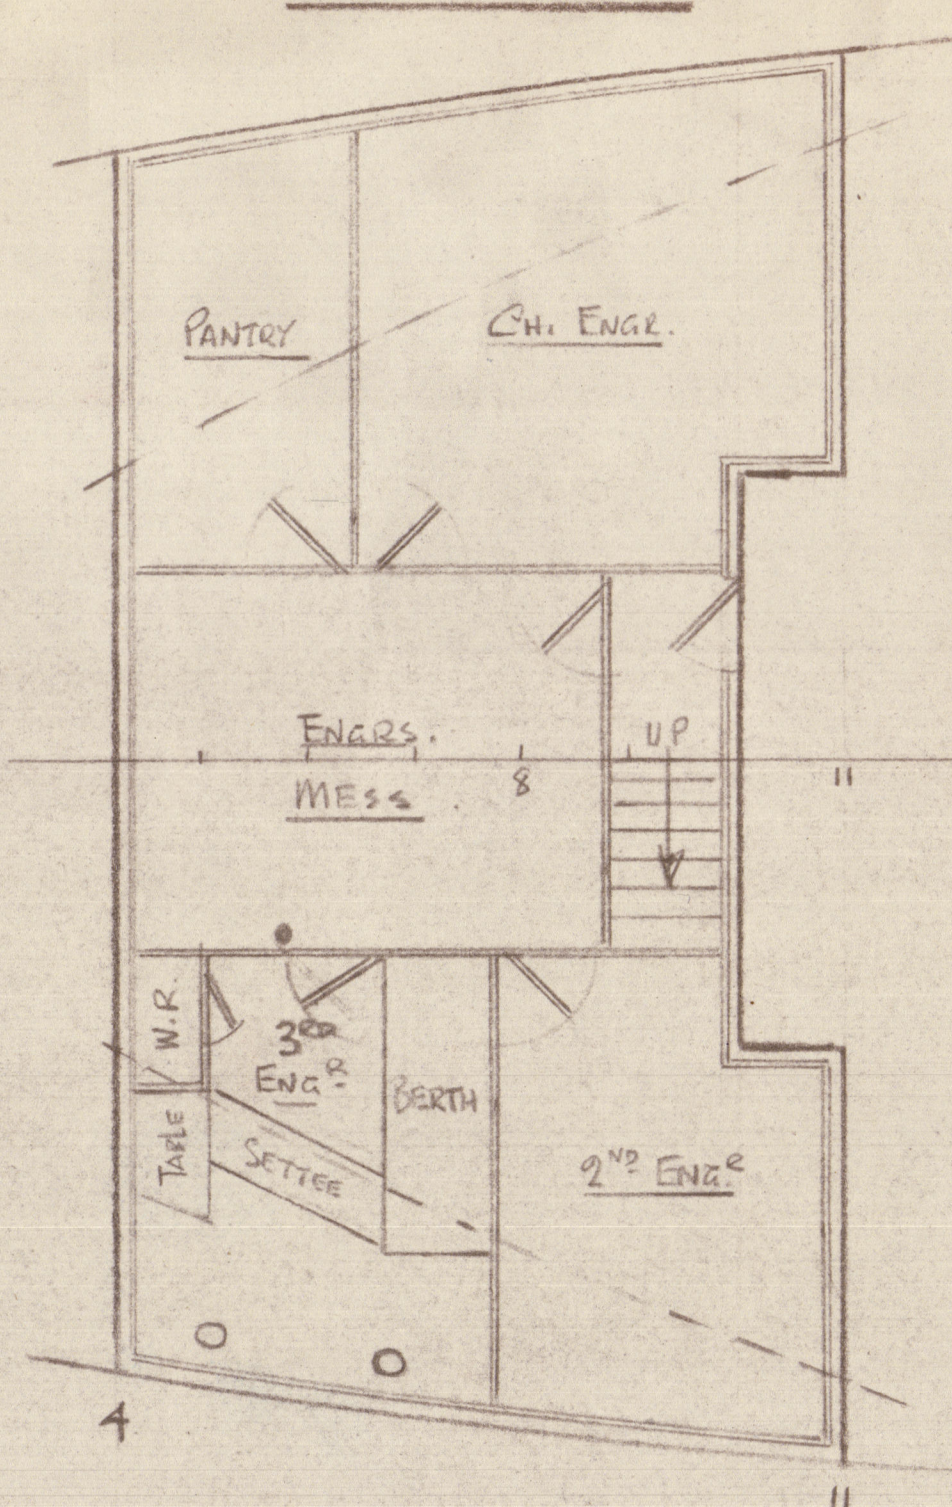


WHEELHOUSE TOP

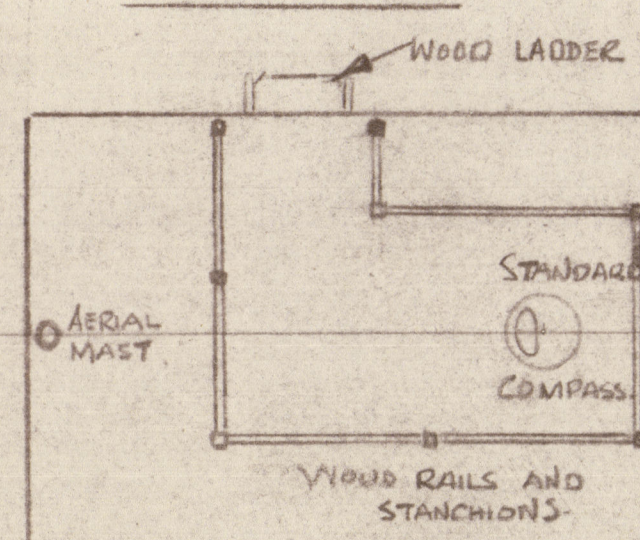


WHEELHOUSE

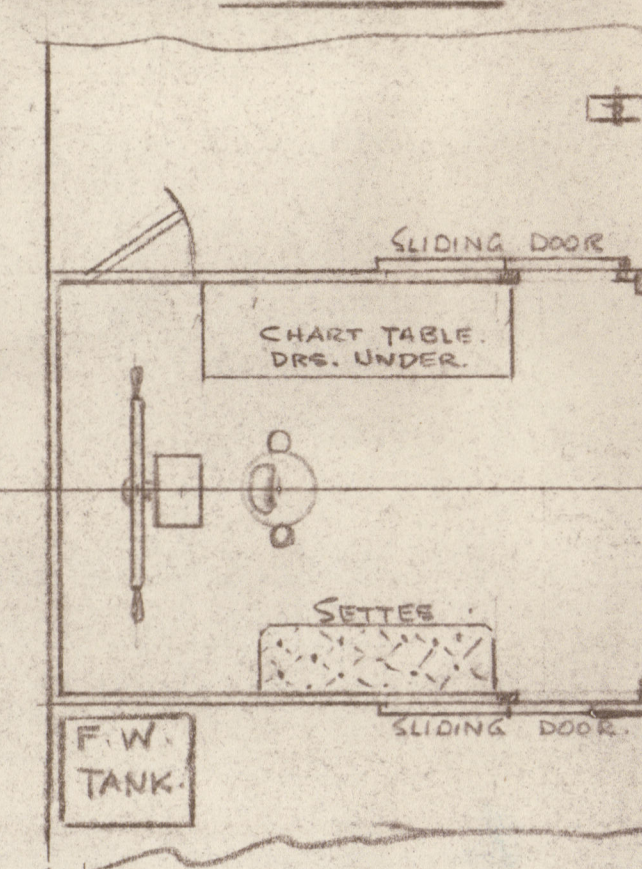



OFFICERS HOUSE

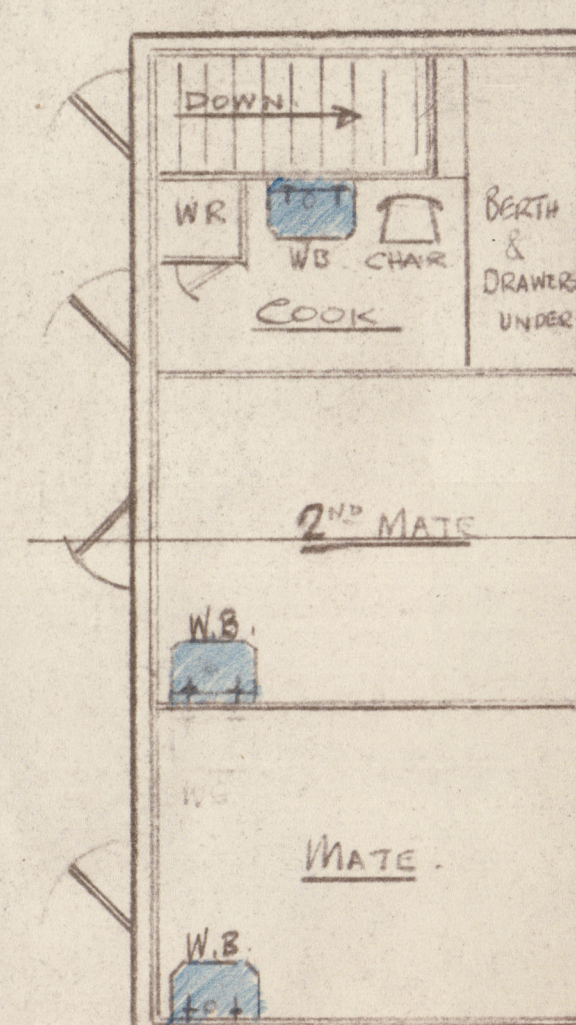

CAPTAINS HOUSE

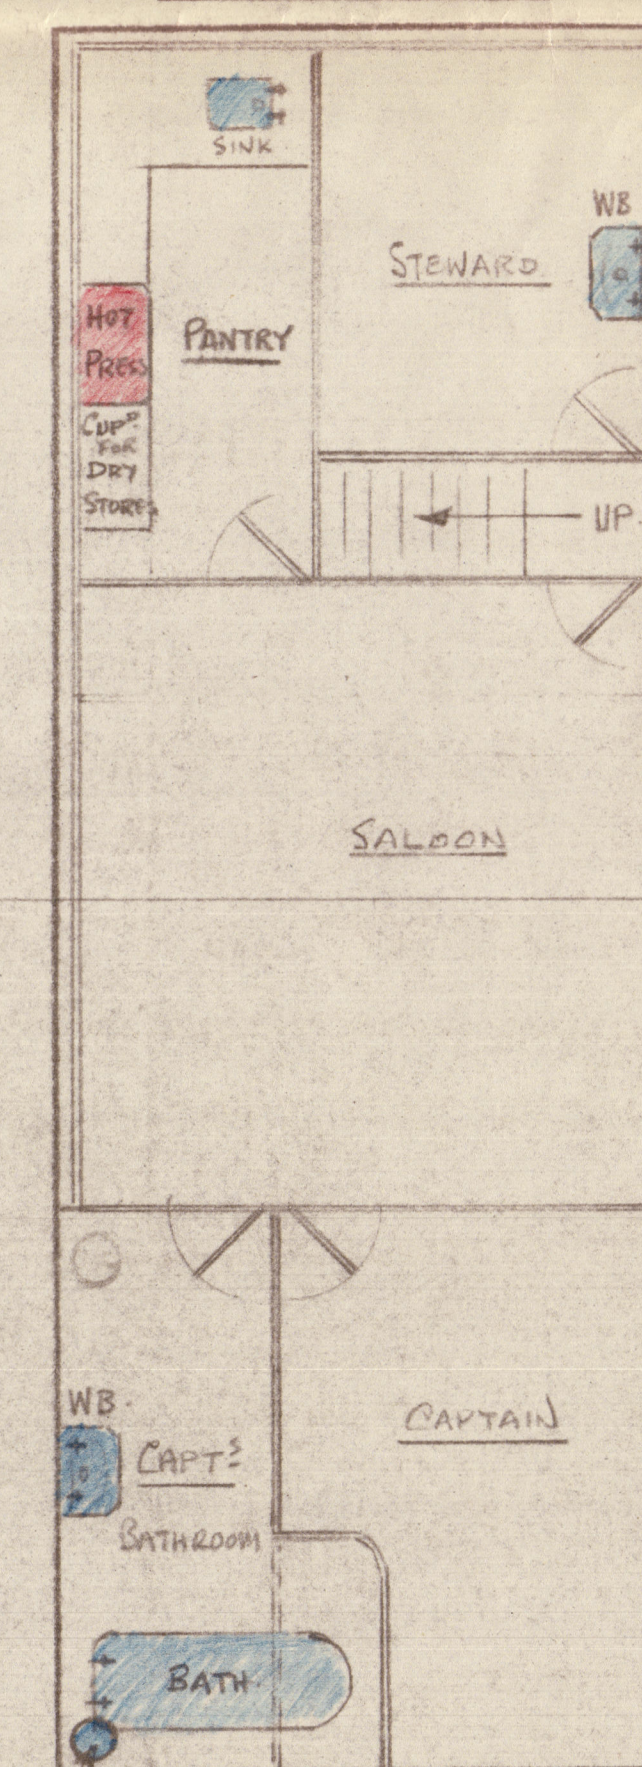

CALORIFIER FOR CAPT. & OFFICERS HOUSES

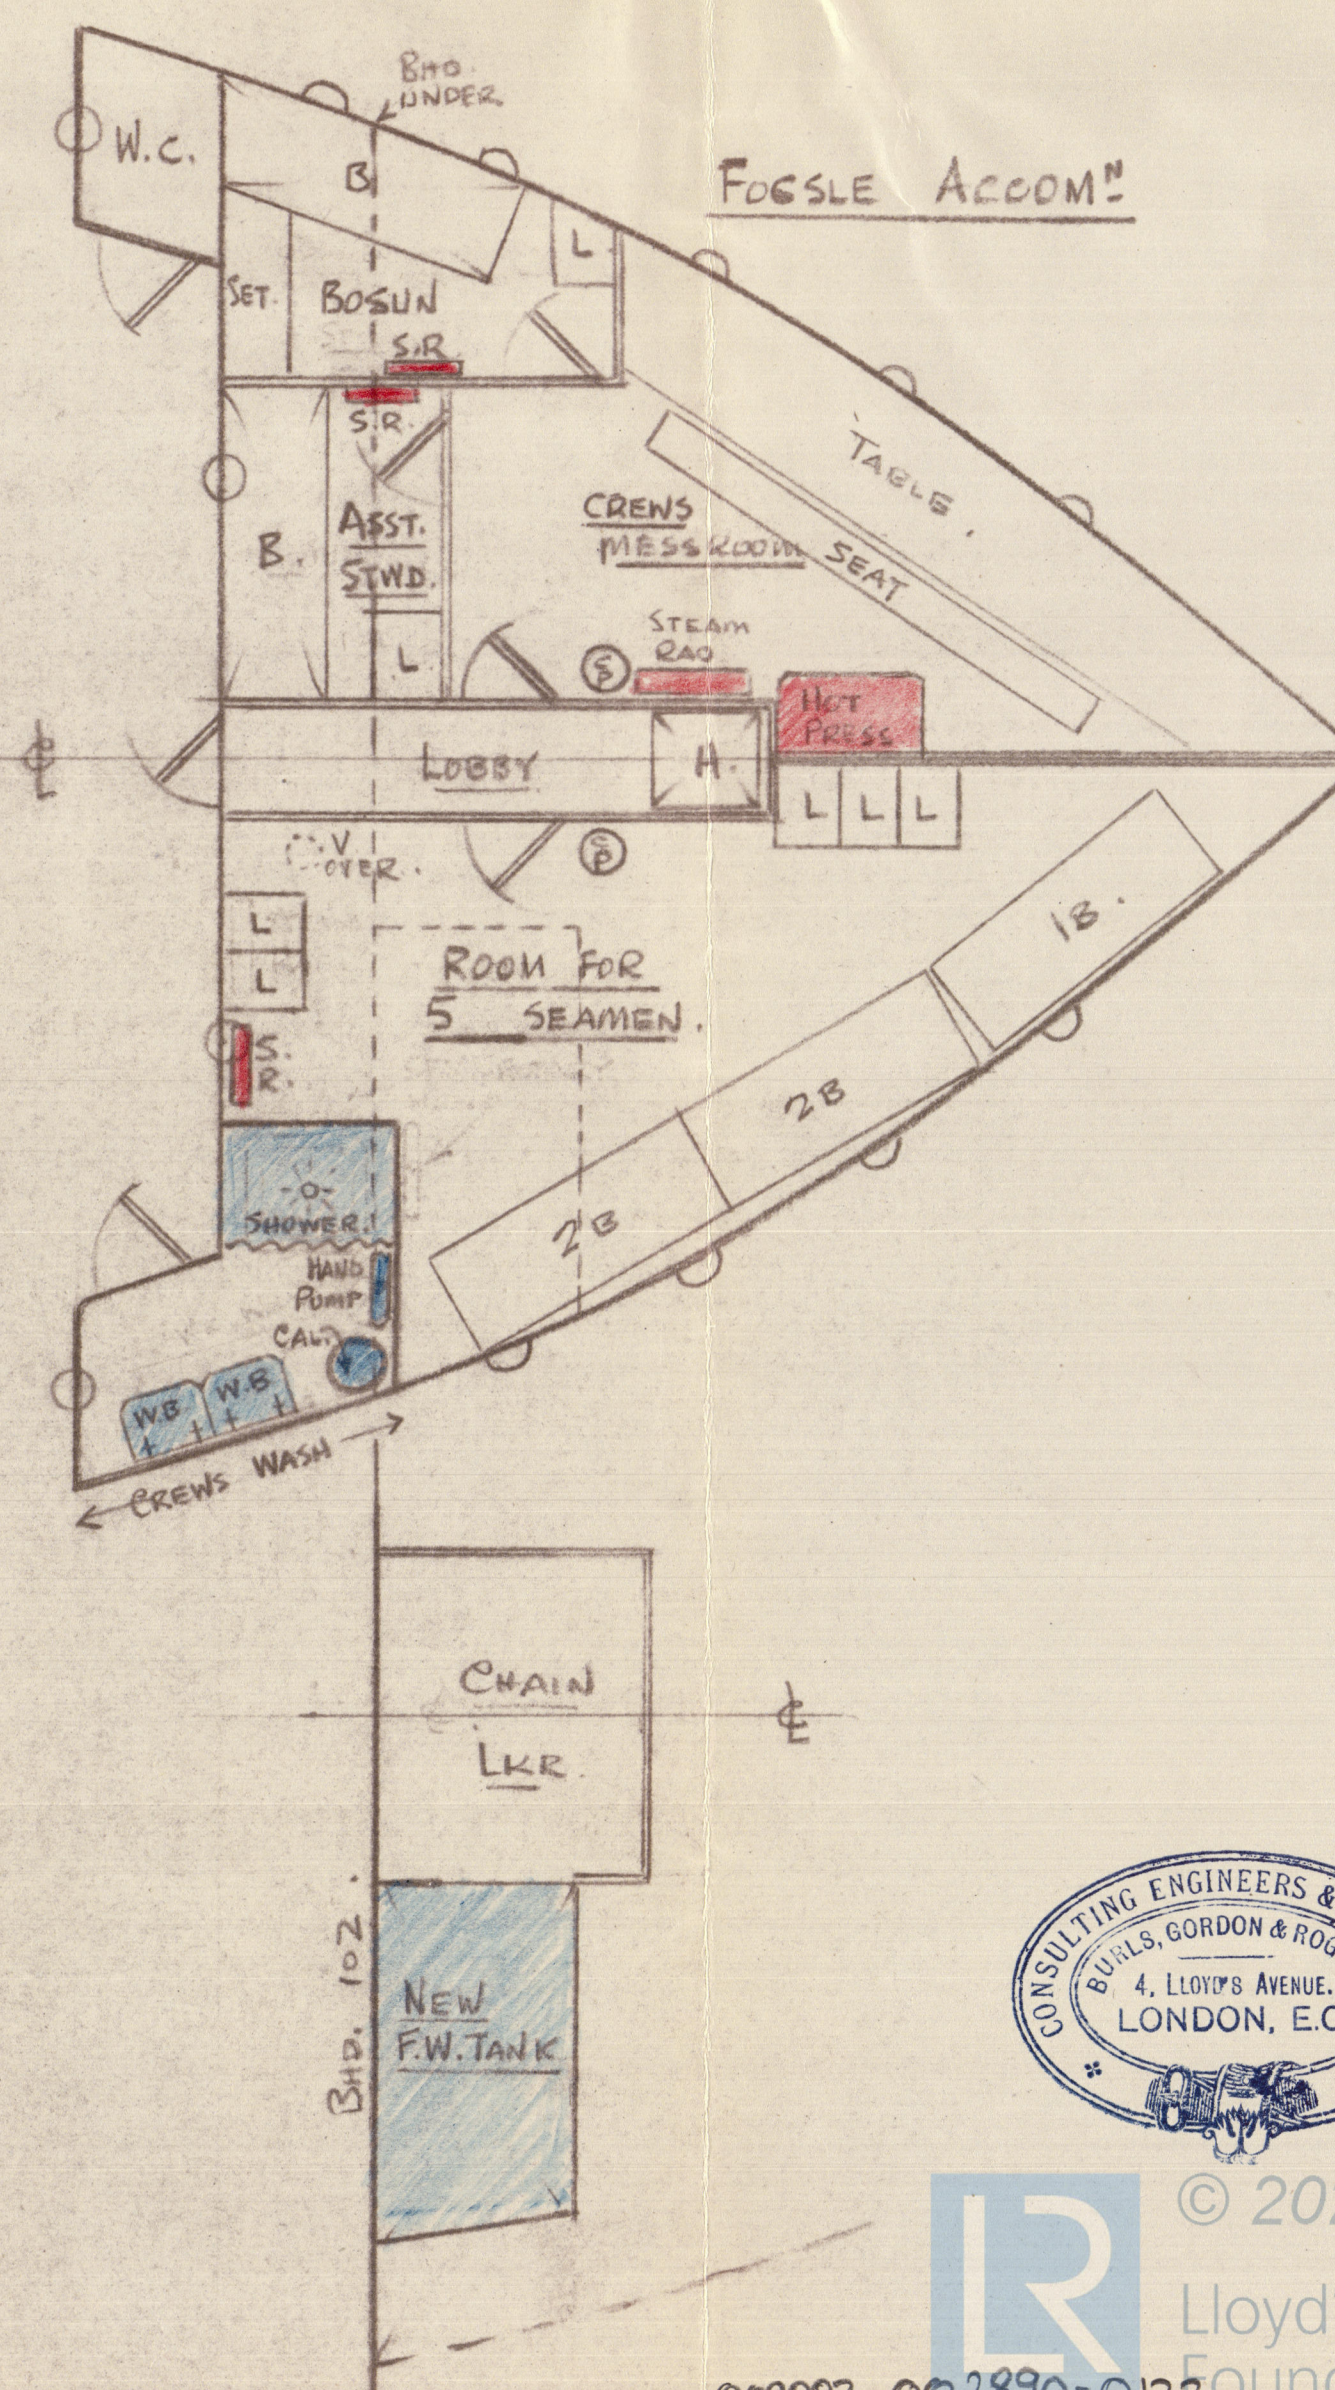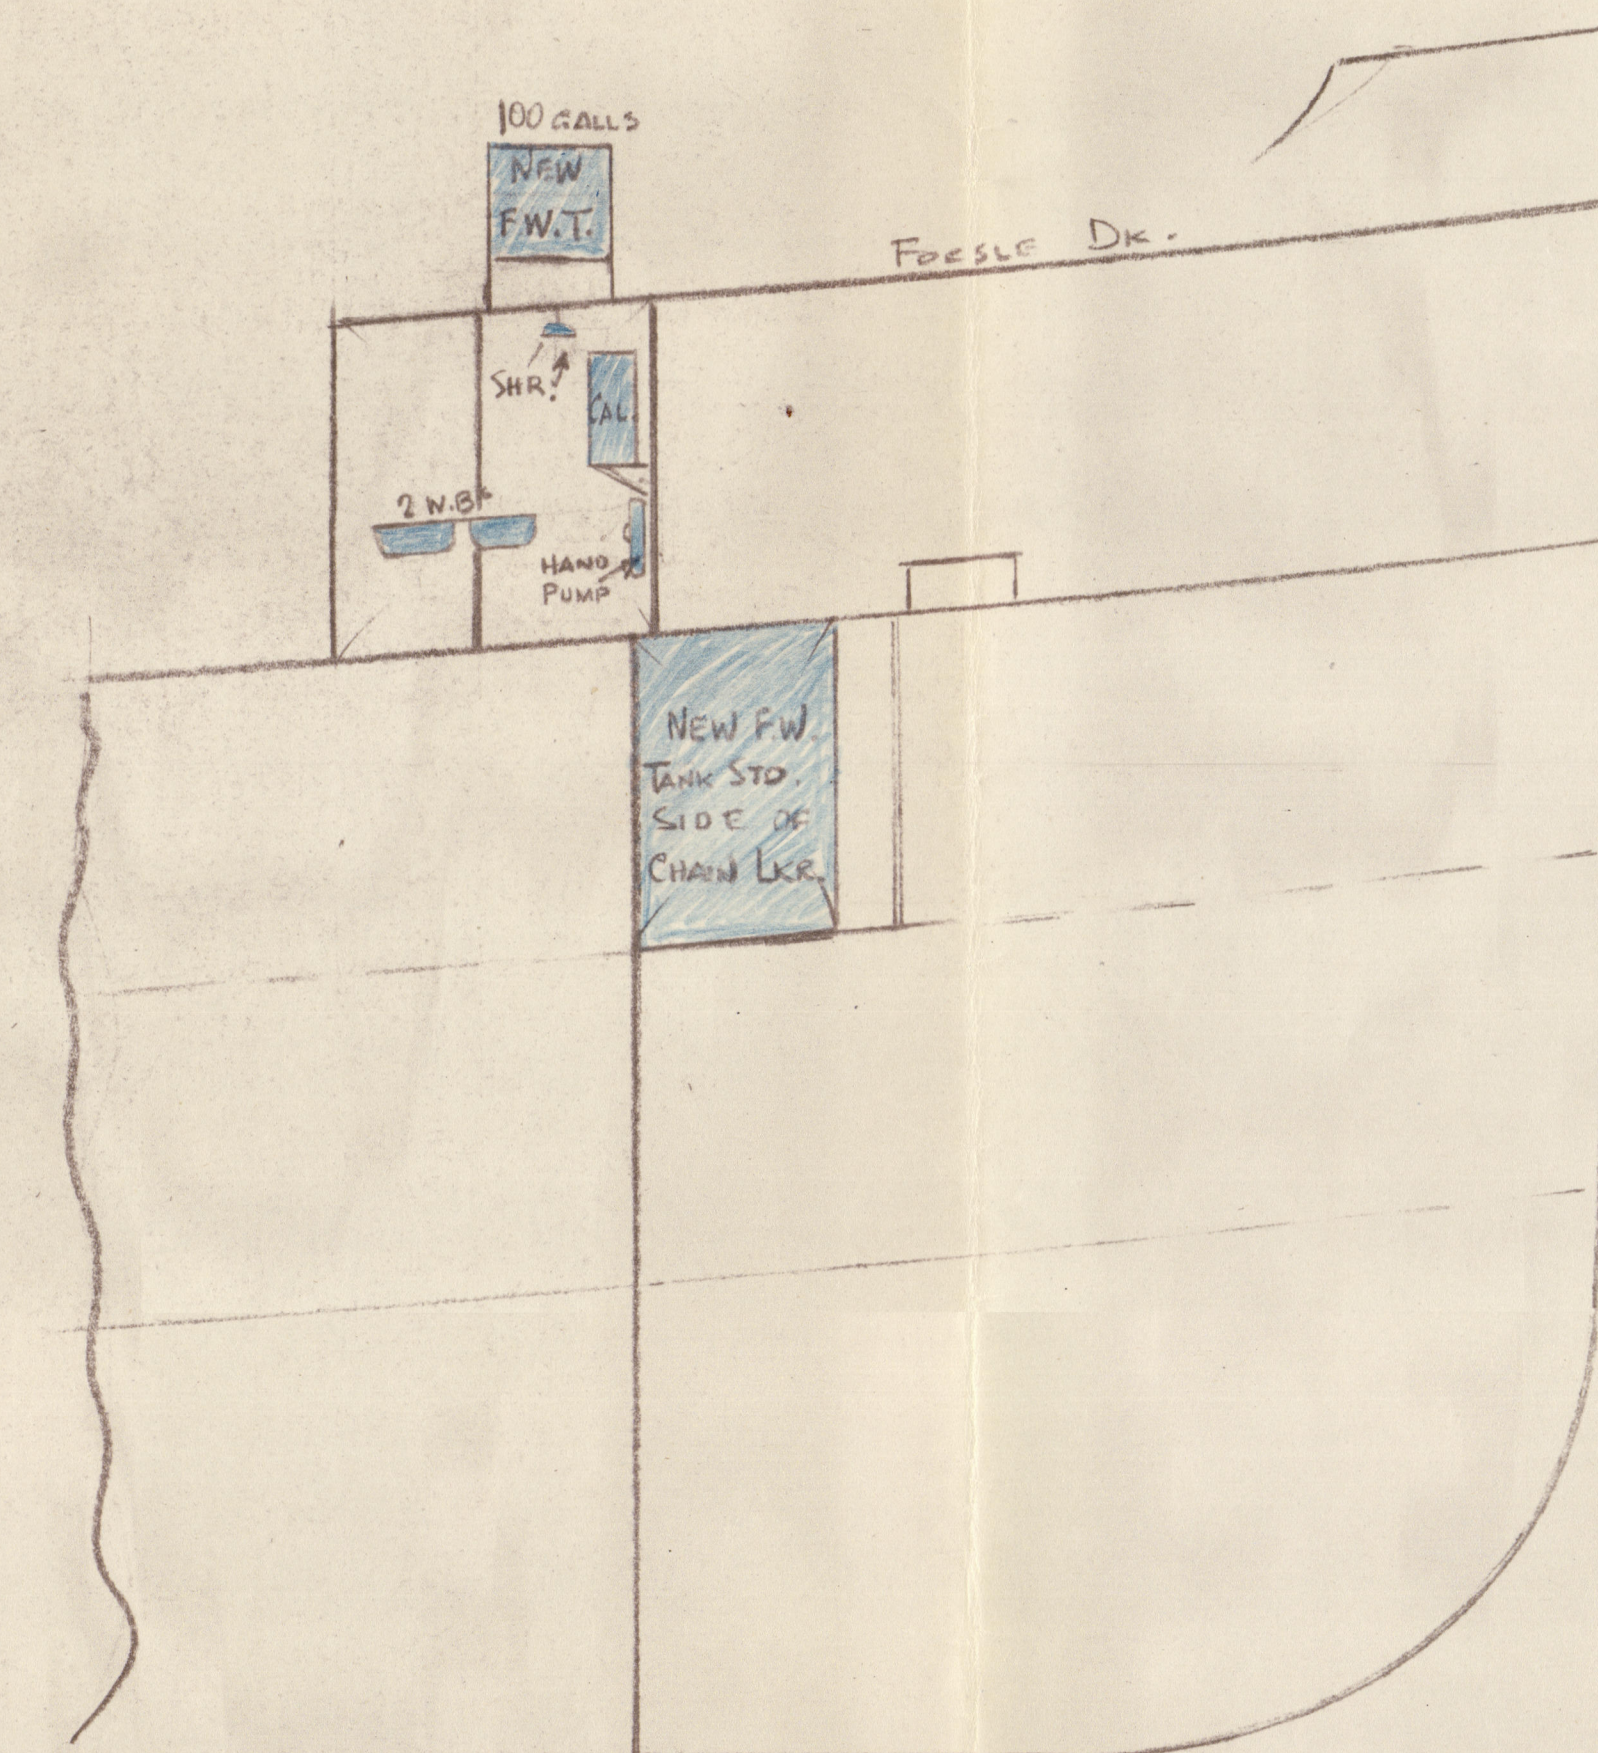

ACCOM

1950

