


FULL SCANTLING VESSEL

	Feet.	Marks
LENGTH AT SUMMER LOAD W.L.	295.0	24.92
BREADTH MOULDED.	43.6	13.25
DEPTH MOULDED TO UPPERDECK.	20.4	6.198
DEPTH MOULDED TO BRIDGEDECK	27.7	8.407

№114 CLASS 1
S.S. "SONJA" **PLAN №190**
AS BUILT

 


EX 85 'SONJA'

X

Profile & Deck plan
as built

CANELOS

D.S 576

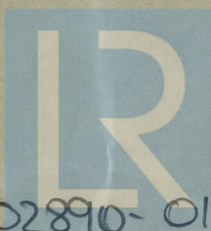

© 2020

Lloyd's Register
Foundation

002883- 002890- 0152