



AFTER MAST STAYS.

FORE MAST STAYS.


FORE AND AFTER

MAST STAYS



Scale 1/100TH OF FULL SIZE.

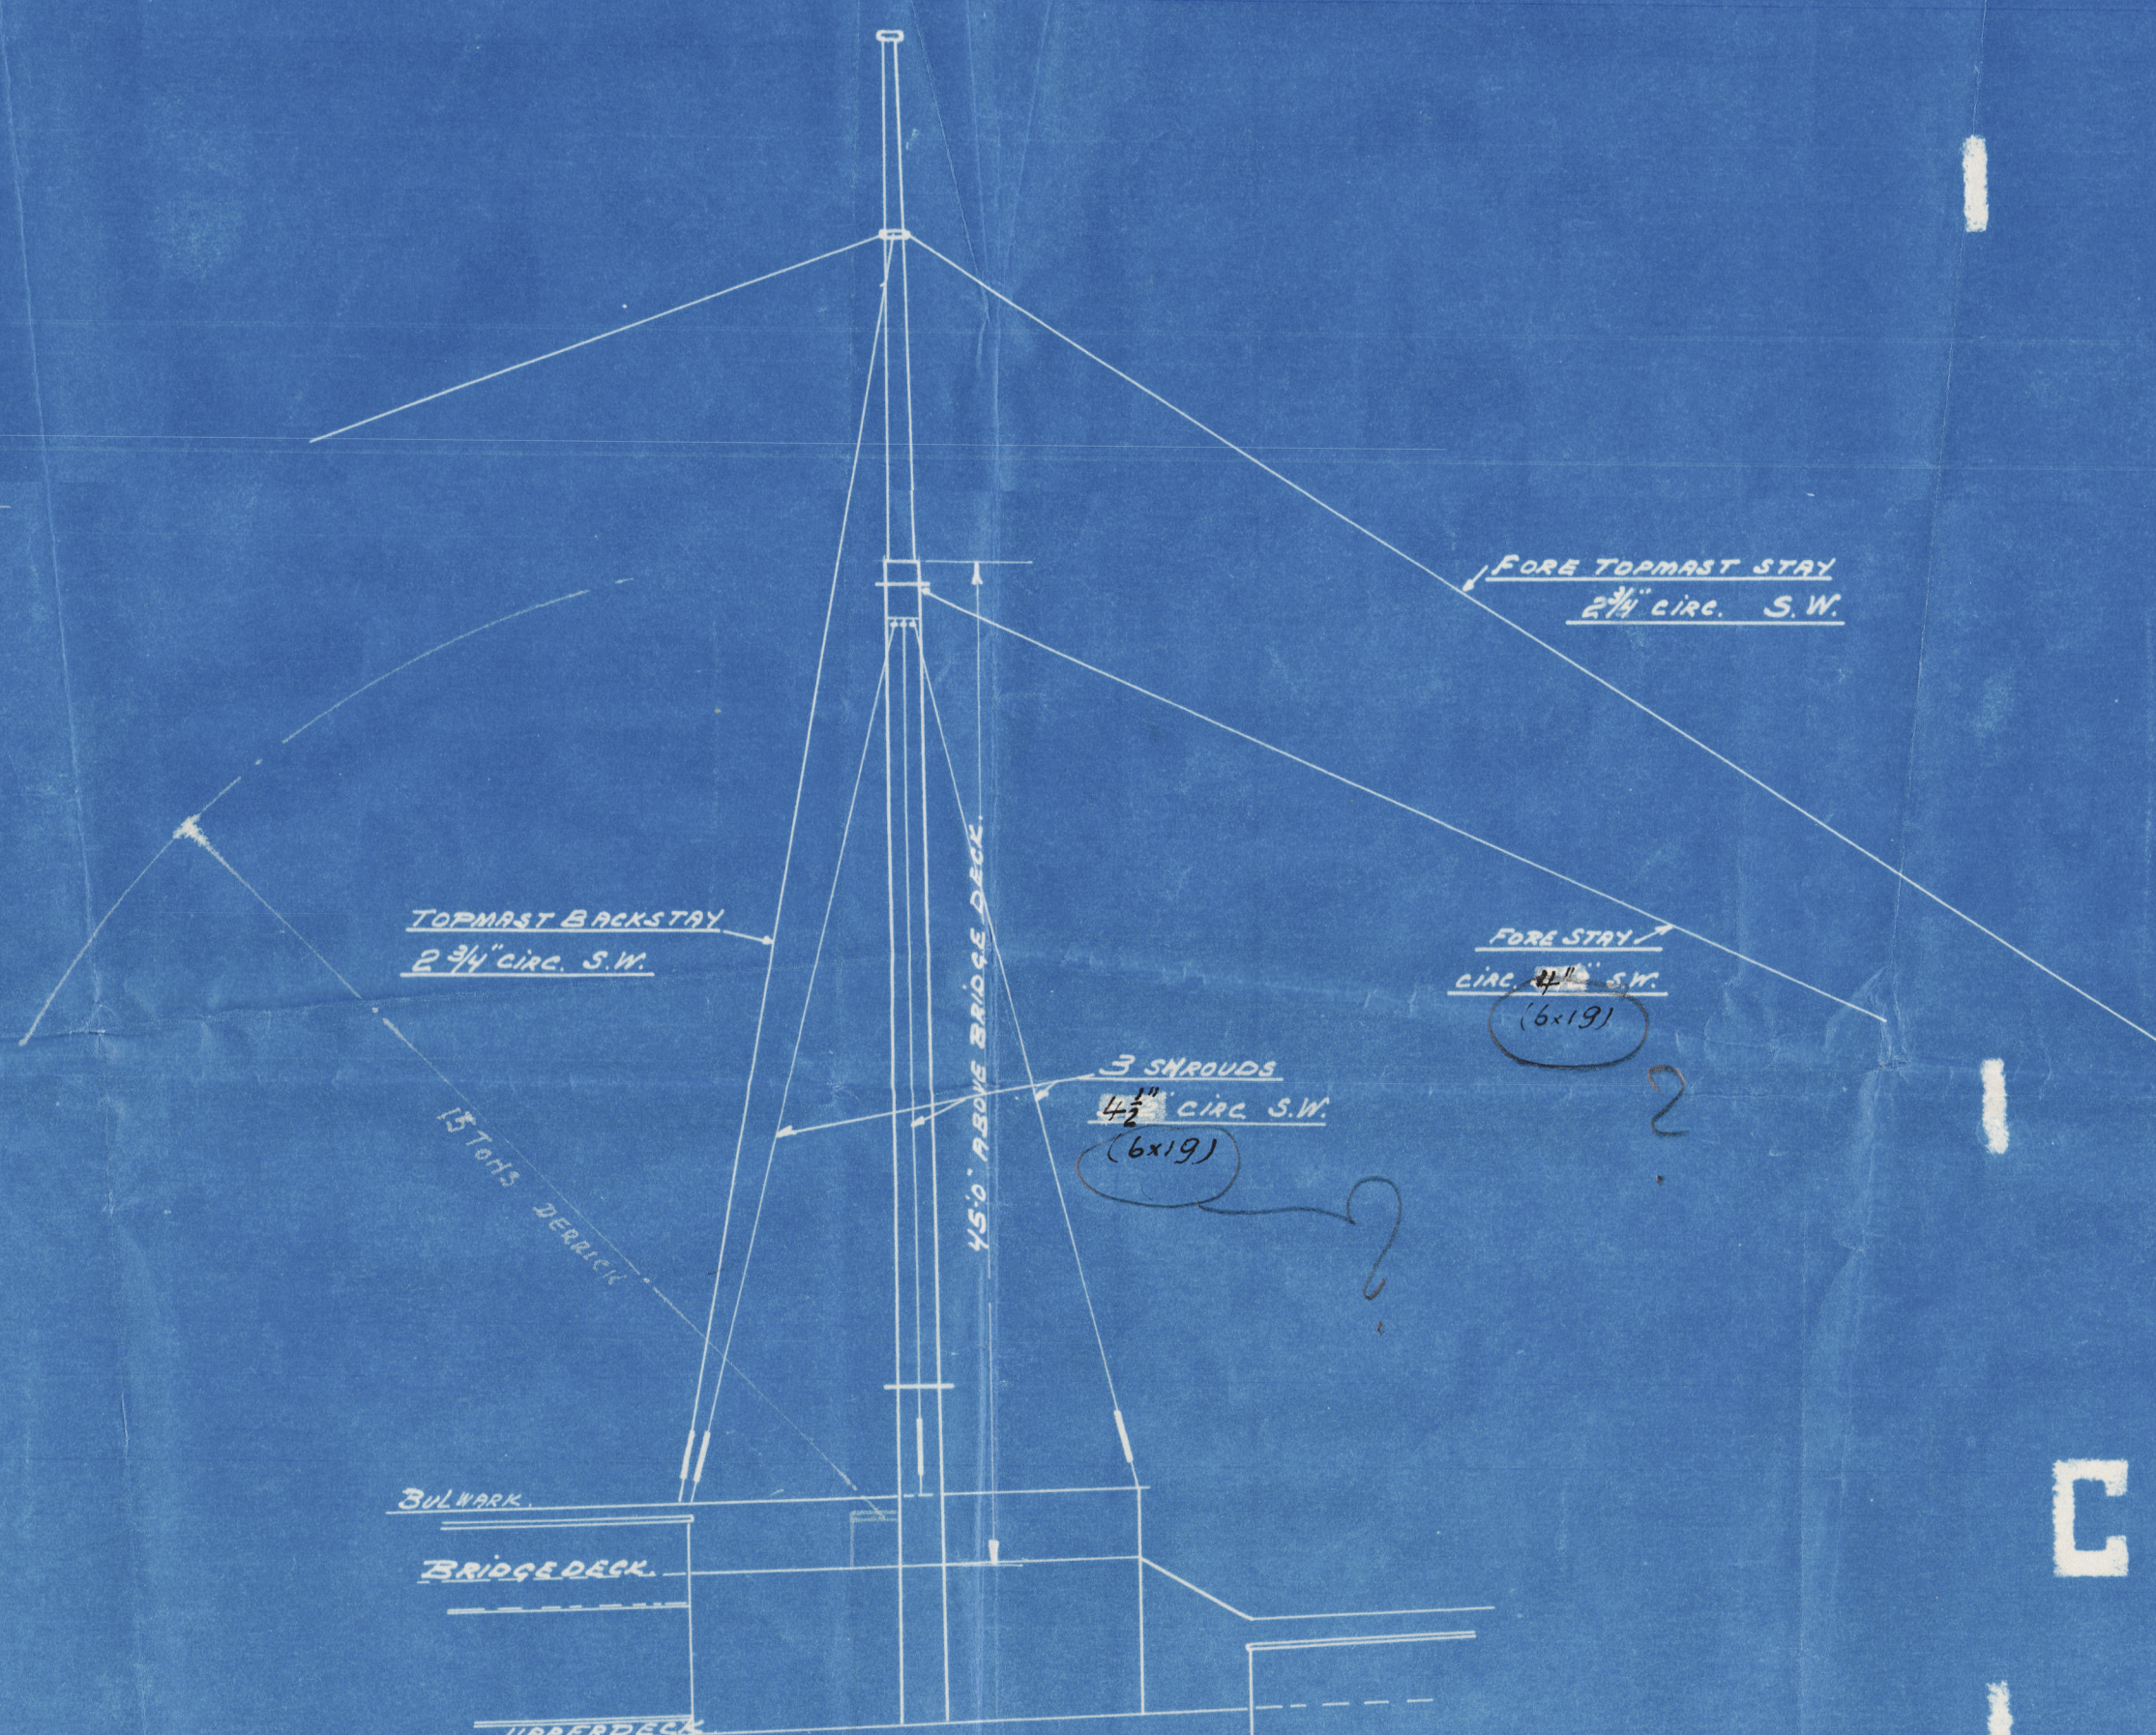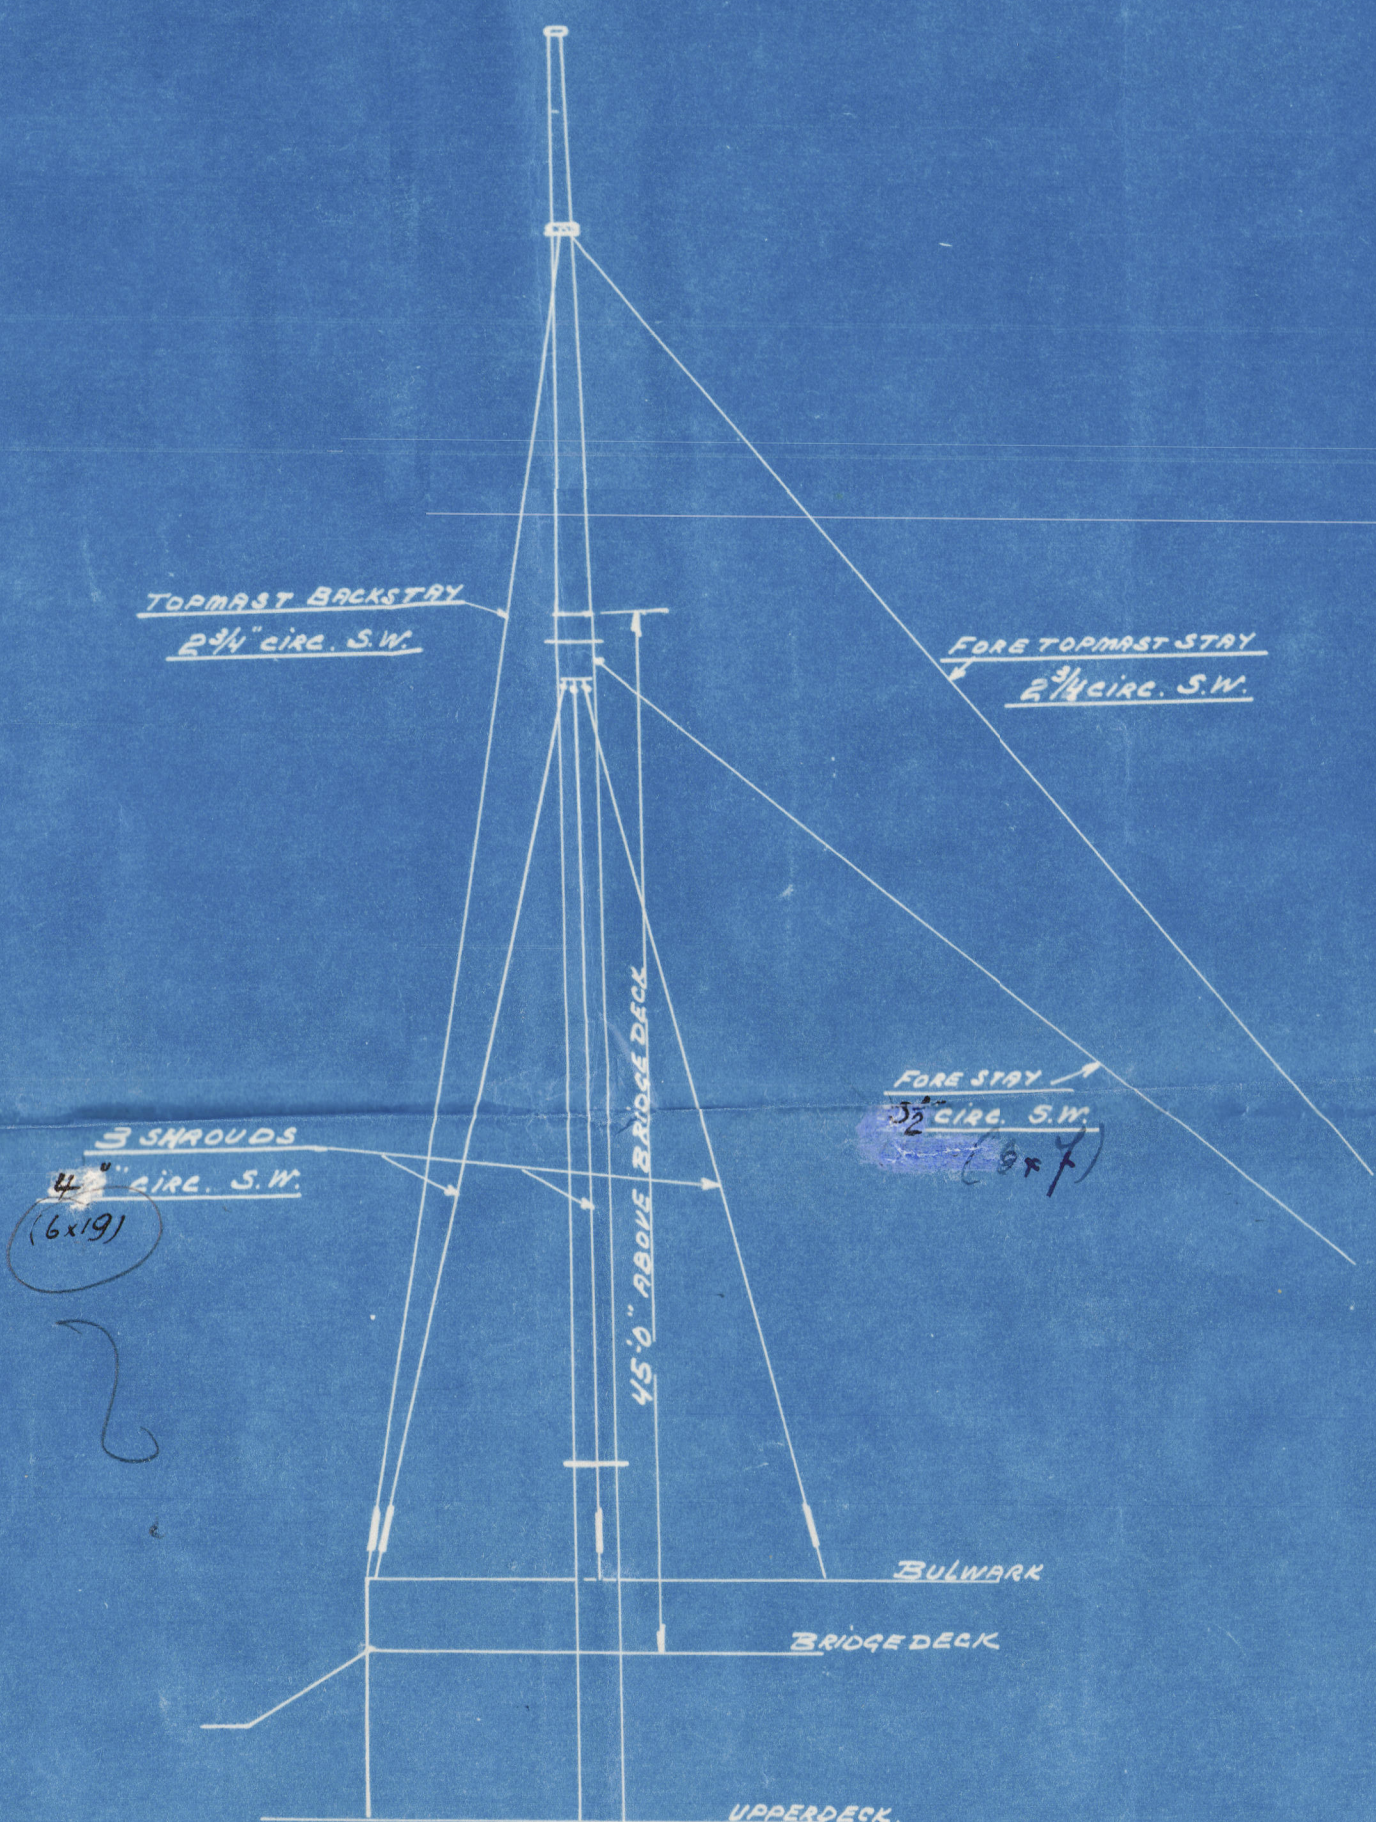


ALL THE SHROUDS ARE MADE OF GALVANISED
CABLE FOR STANDING RIGGING.

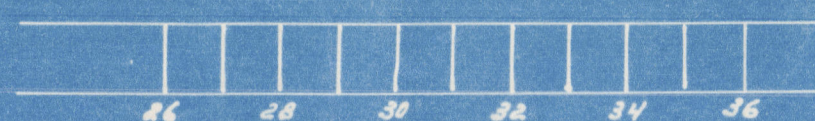

VIEW ON BRIDGE DECK

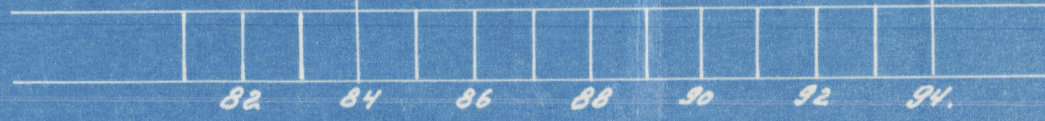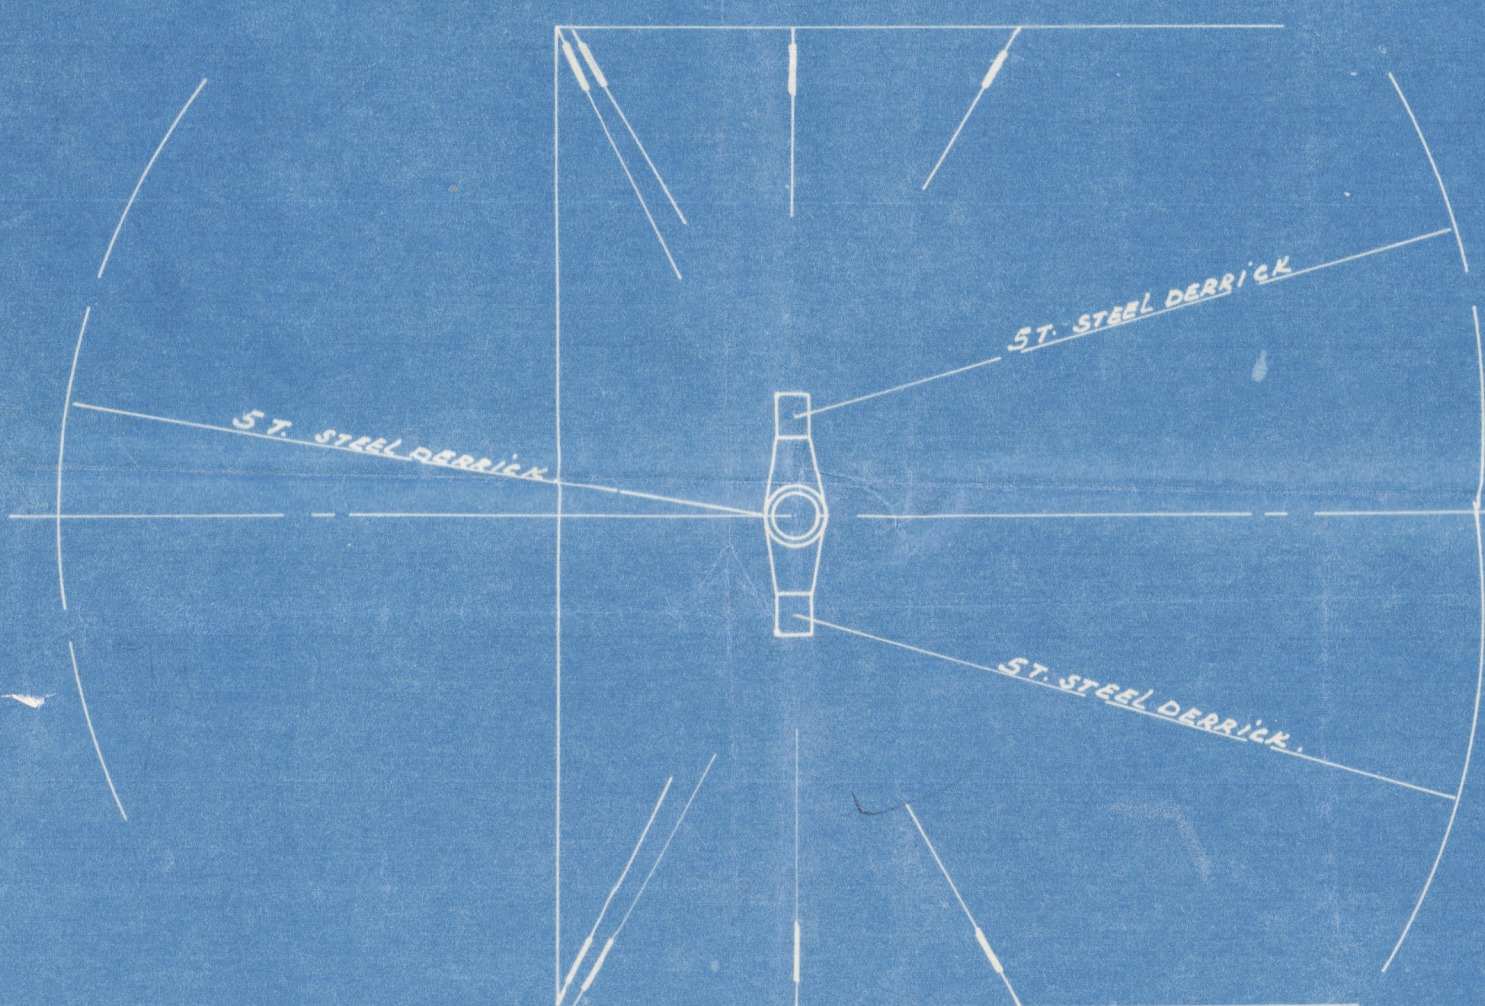

VIEW ON BRIDGE DECK.

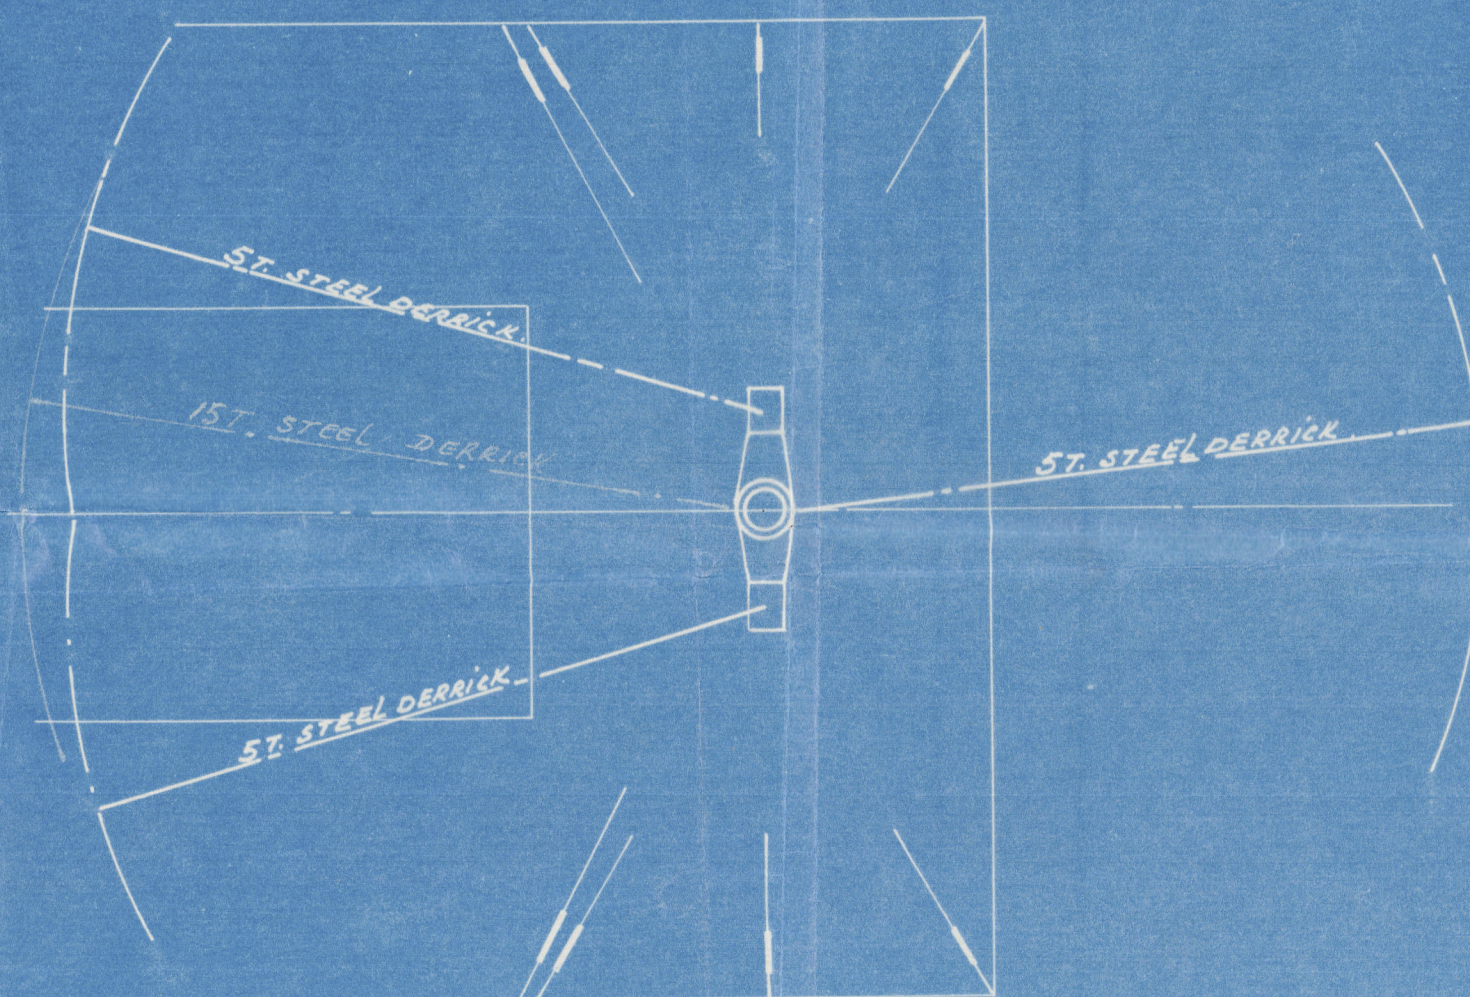

C N° 114 CLASS 16
115 PLANN° 164

W.J.

3.7.30

Autunup
The Autunup Ing. Co. N.S.

Hoboken.

114 - 115

Rigging

GEN. BOX NO 823

P.O. "Sonja"



© 2020

Lloyd's Register
Foundation

002883-002890-0154