

# No 949. MIDSHIP SECTION.


DIMENSIONS 248'-0" PP x 42'-10" MLD x 25'-0" MLD

TO CLASS 100A1 LLOYDS FOR SERVICE ON THE GREAT LAKES & ST LAWRENCE RIVER WITH FREEBOARD.

SCALE 1/2" = 1 FOOT.

MOULDED DRAFT = 19'-4"

NUMERALS	
LENGTH	248'-0"
BREADTH	42'-63
DEPTH	25'-0
L x D	6200
L x (B+D)	16821
L ÷ D	9.9
"d" FOR FRAMING	22.16

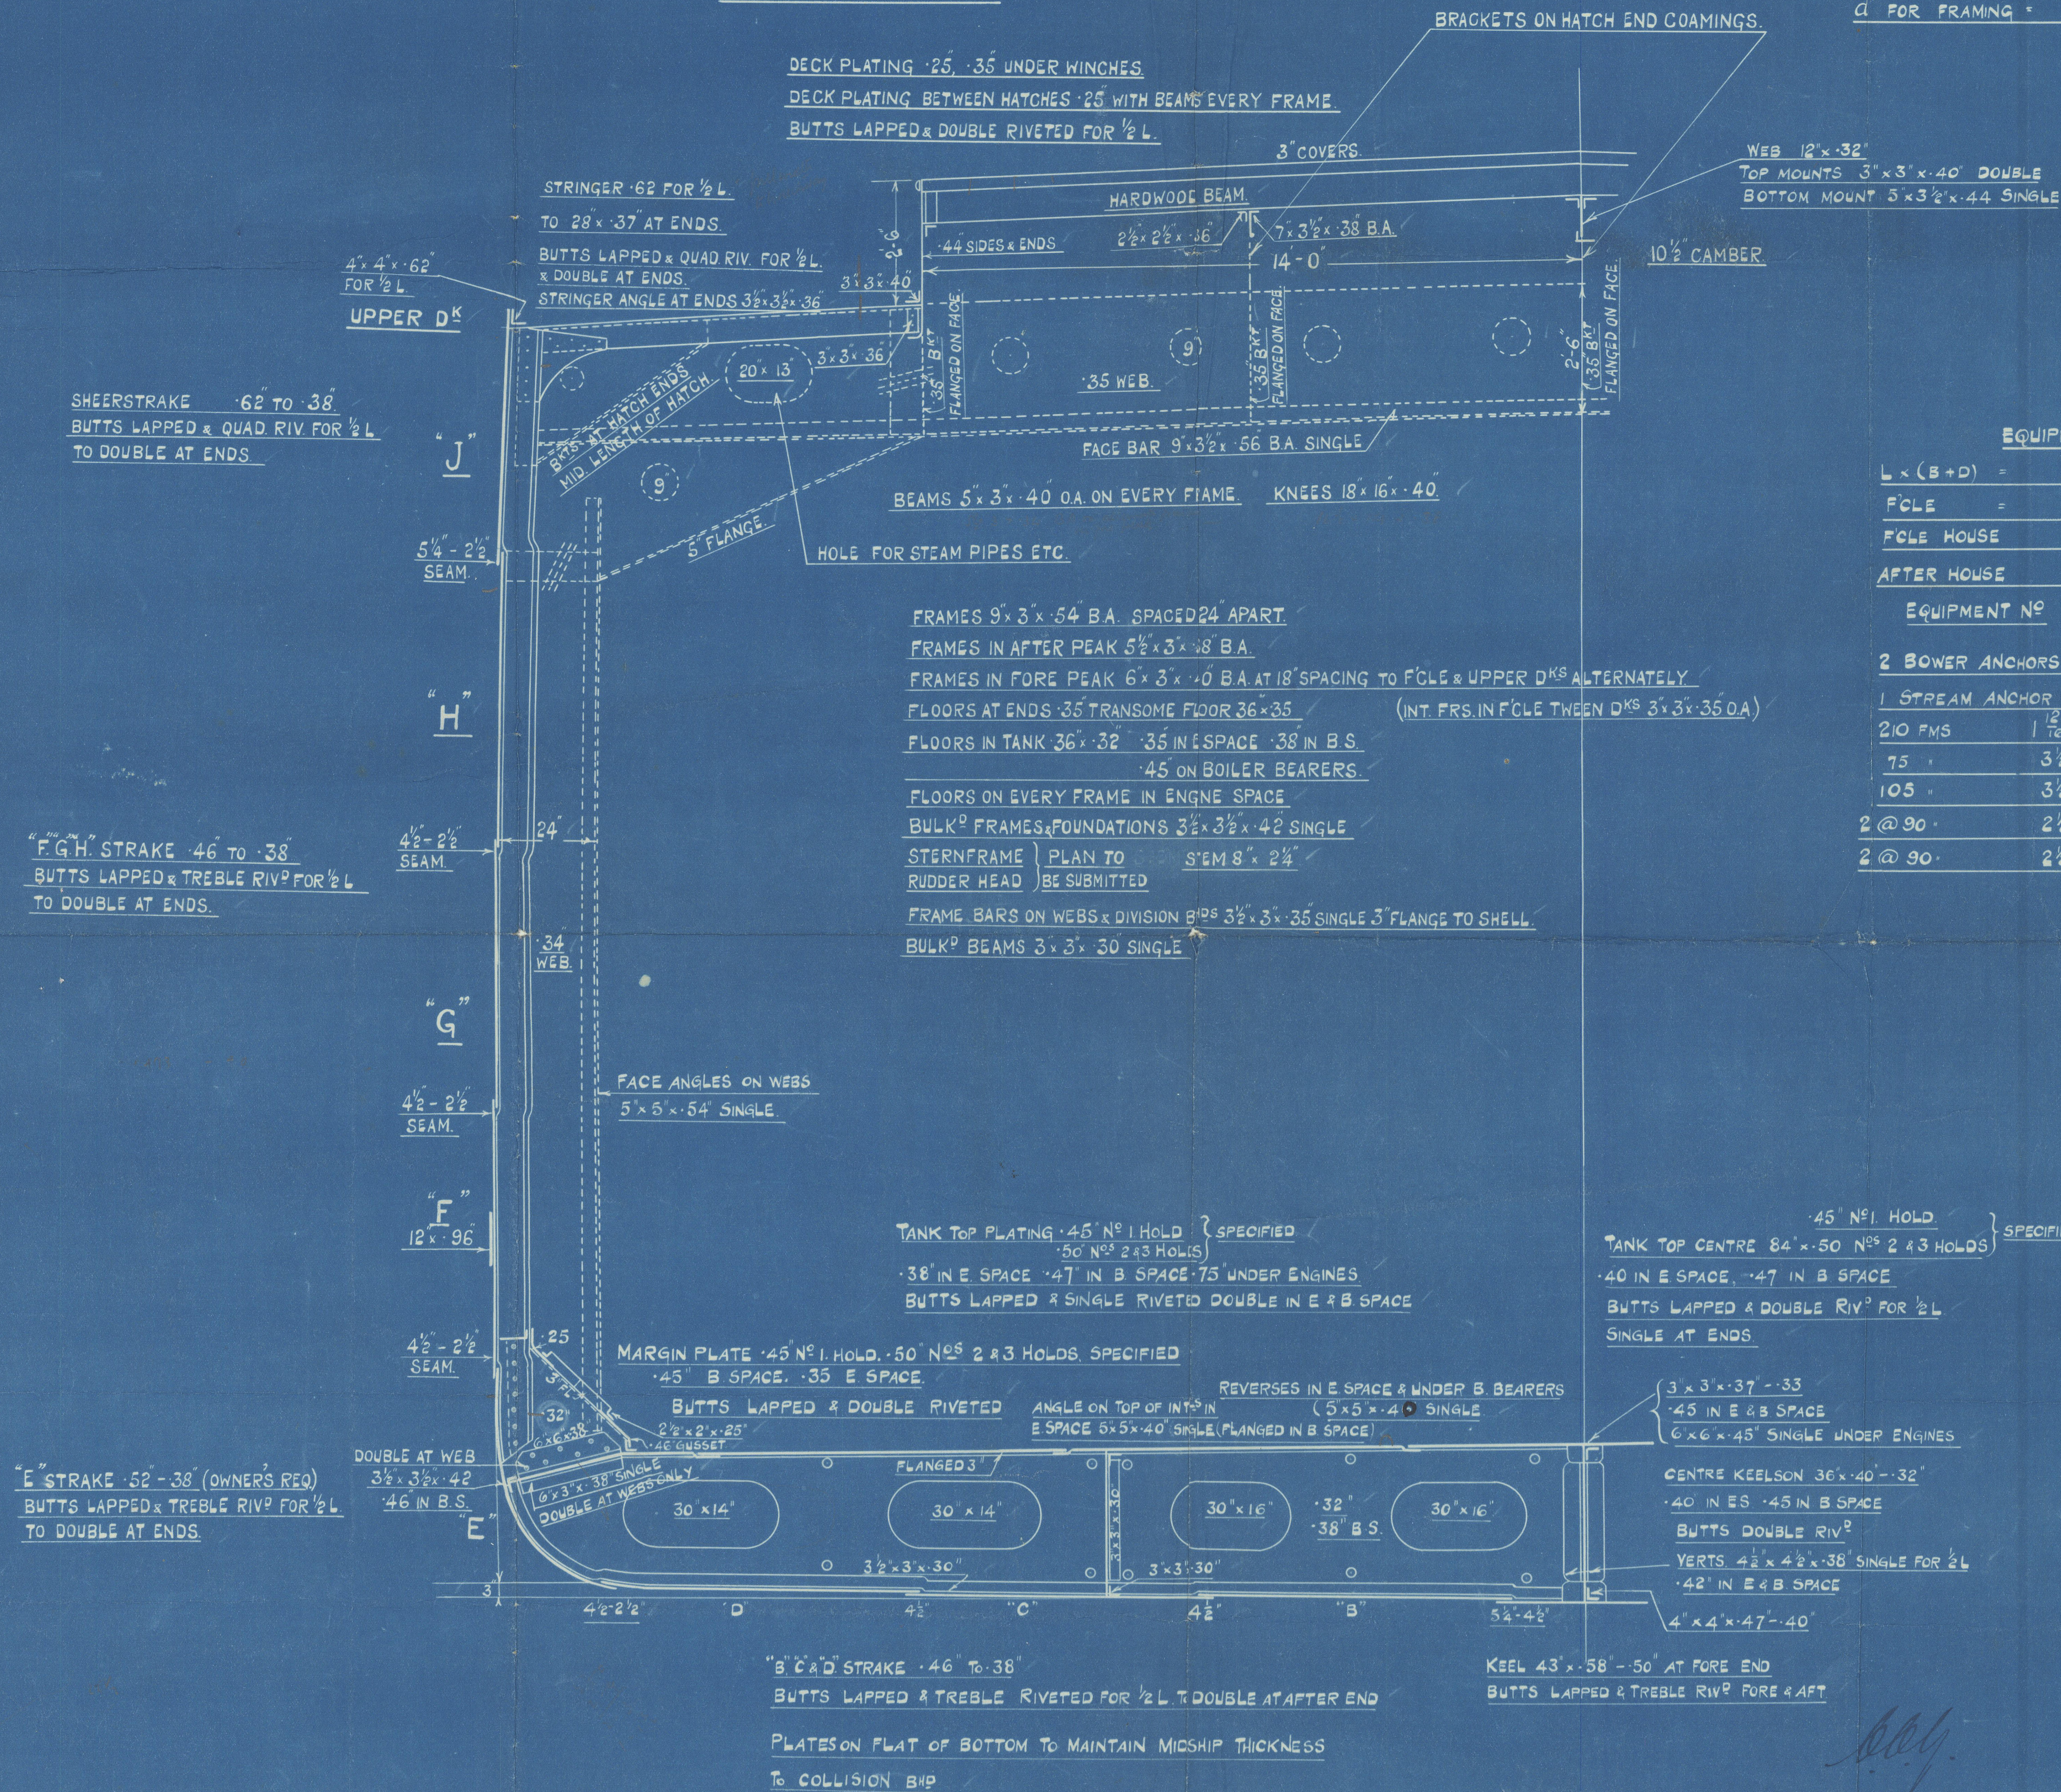

EQUIPMENT N°	
L x (B+D)	16821
FOLE	228
FOLE HOUSE	70
AFTER HOUSE	188
EQUIPMENT N°	17307

2 BOWER ANCHORS, STOCKLESS @ 35 1/2 CWTs.	
1 STREAM ANCHOR STOCKLESS	12 CWTs.
210 FMS	1 1/2" STD CHAIN CABLE
75 "	3 1/2" STEEL WIRE STREAM
105 "	3 1/2" " " TOWLINE
2 @ 90 "	2 1/2" " " HAWSERS
2 @ 90 "	2 1/2" " " WARPS

OR ALTERNATIVE ARRANGEMENT OF BRACKET FLOORS

FRAME 8"x3"x40 B.A.	} WITH CENTRE & WING BRACKETS
REV. FRAME 7 1/2"x3"x40 B.A.	
.44 B.S.	} BUT WITH 7 1/2"x3"x40 B.A. STRUT AT SIDE GIRDER ONLY
.44 B.S.	



Nº 2

Palmers

Lake Steamer N° 949.

Midship Section

Outarde  
Ex

S. S. "BRUKIN"

NEWCASTLE ON TYNE.

Report No. 78236.

Outarde



© 2020

Lloyd's Register  
Foundation

002891-002896-0001