

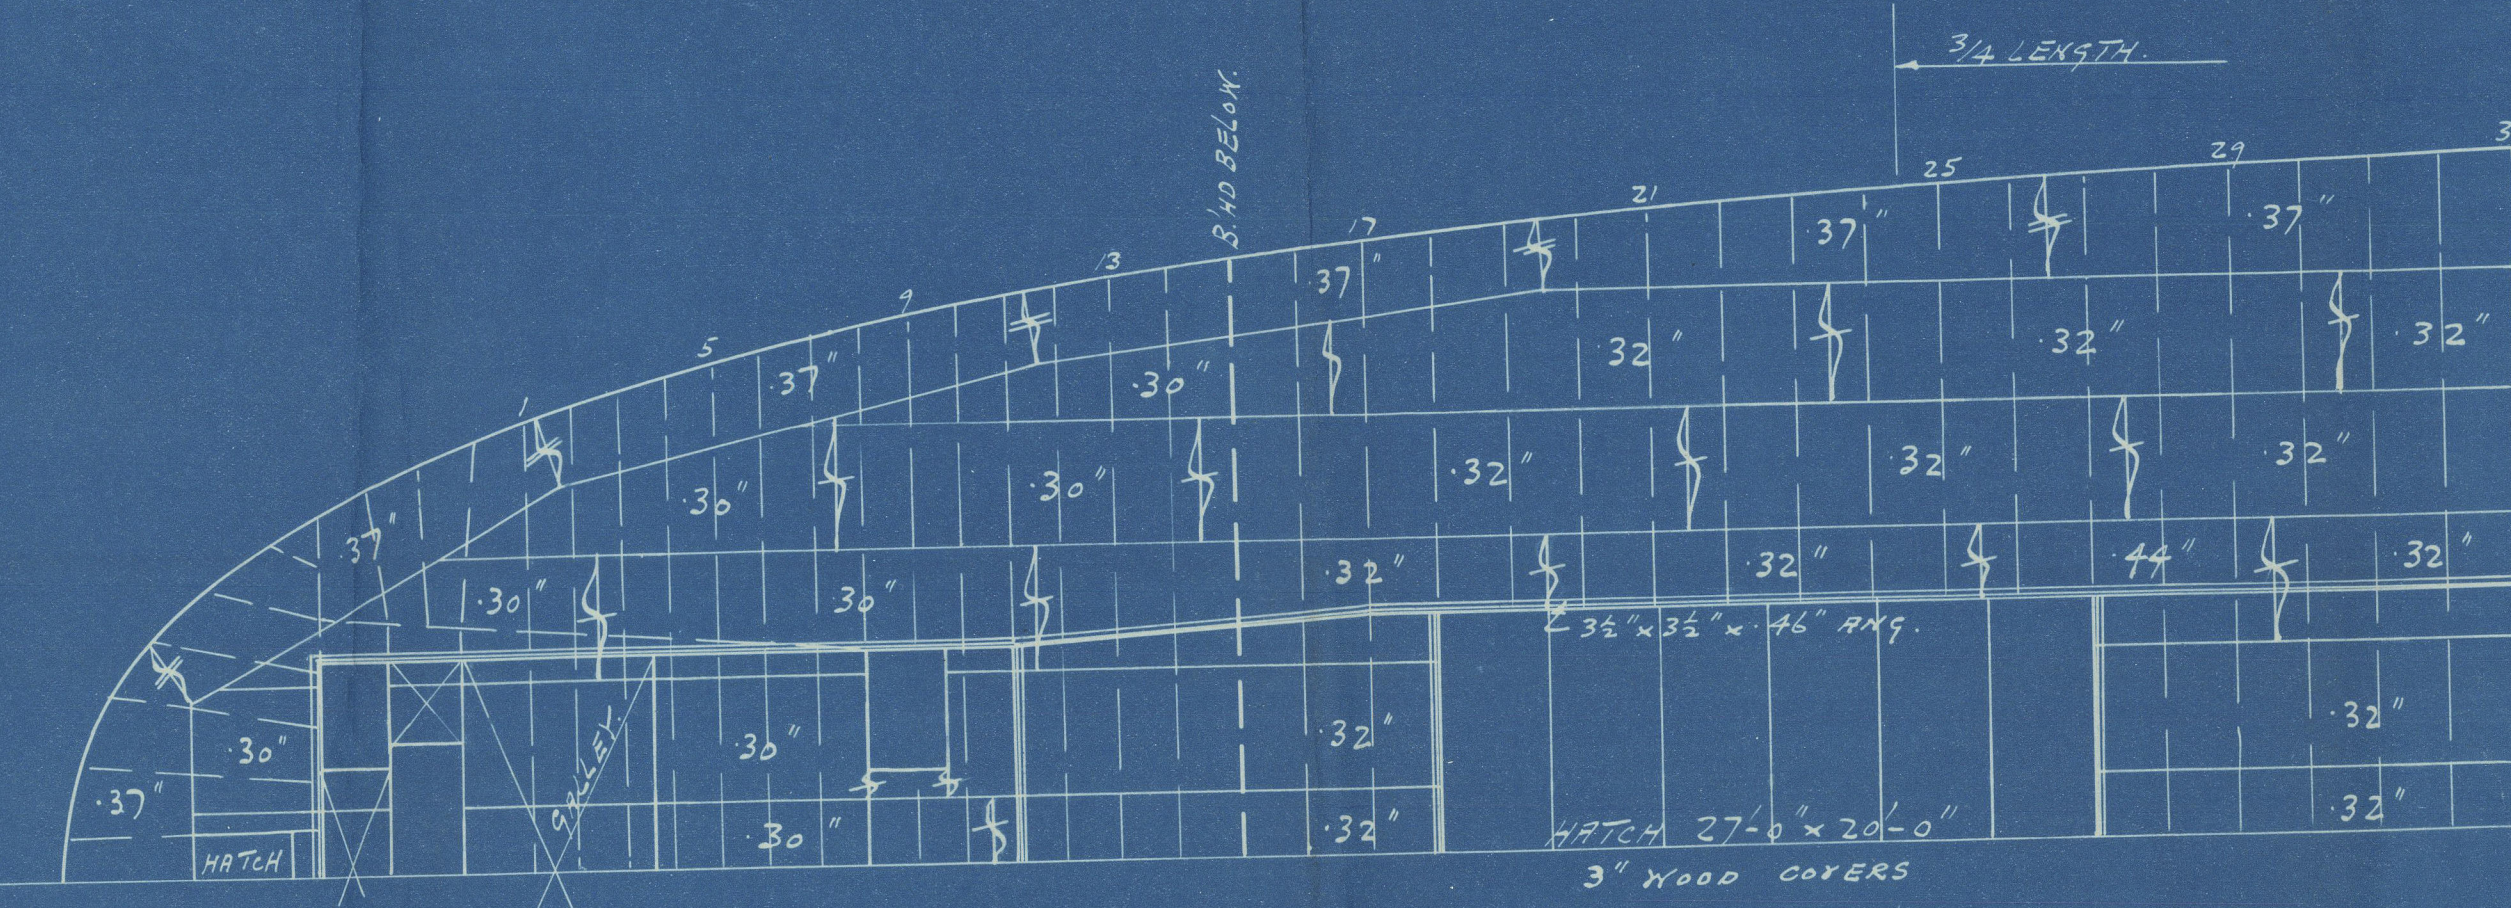
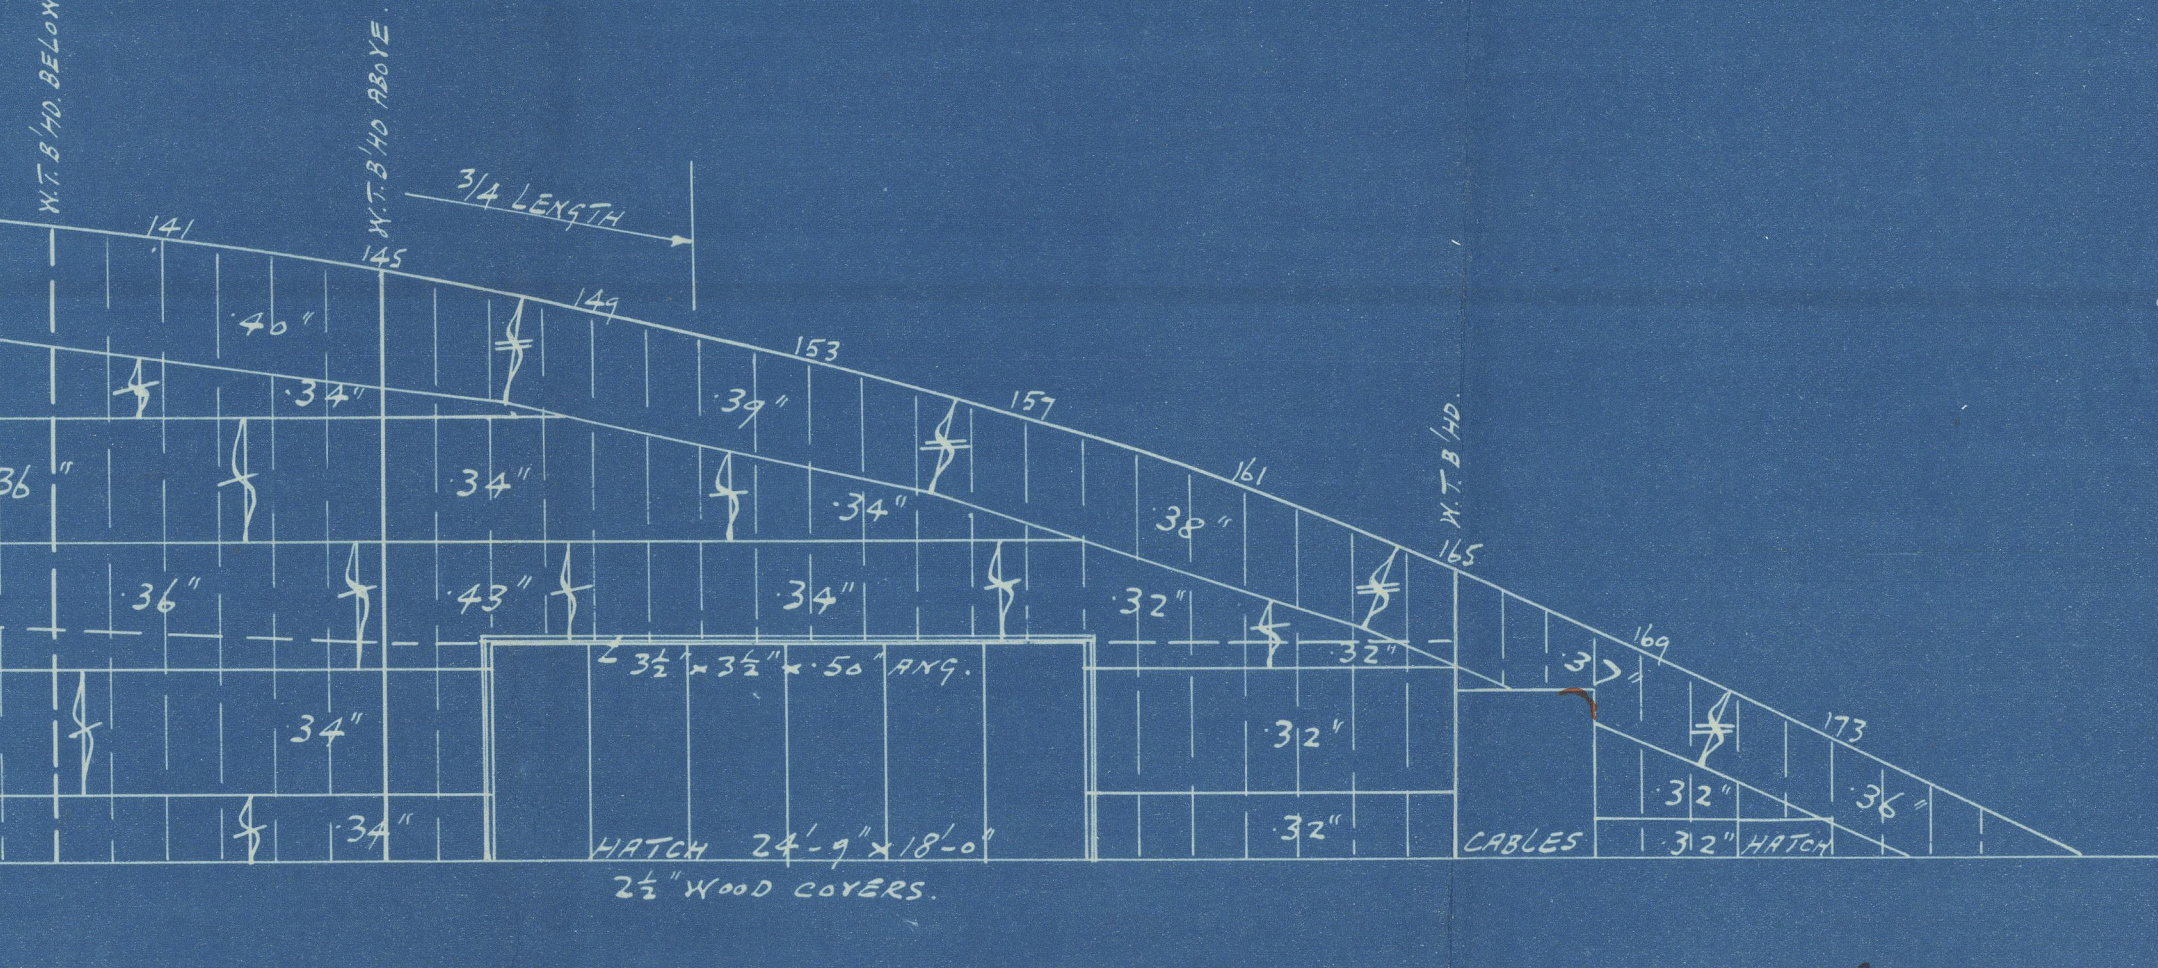
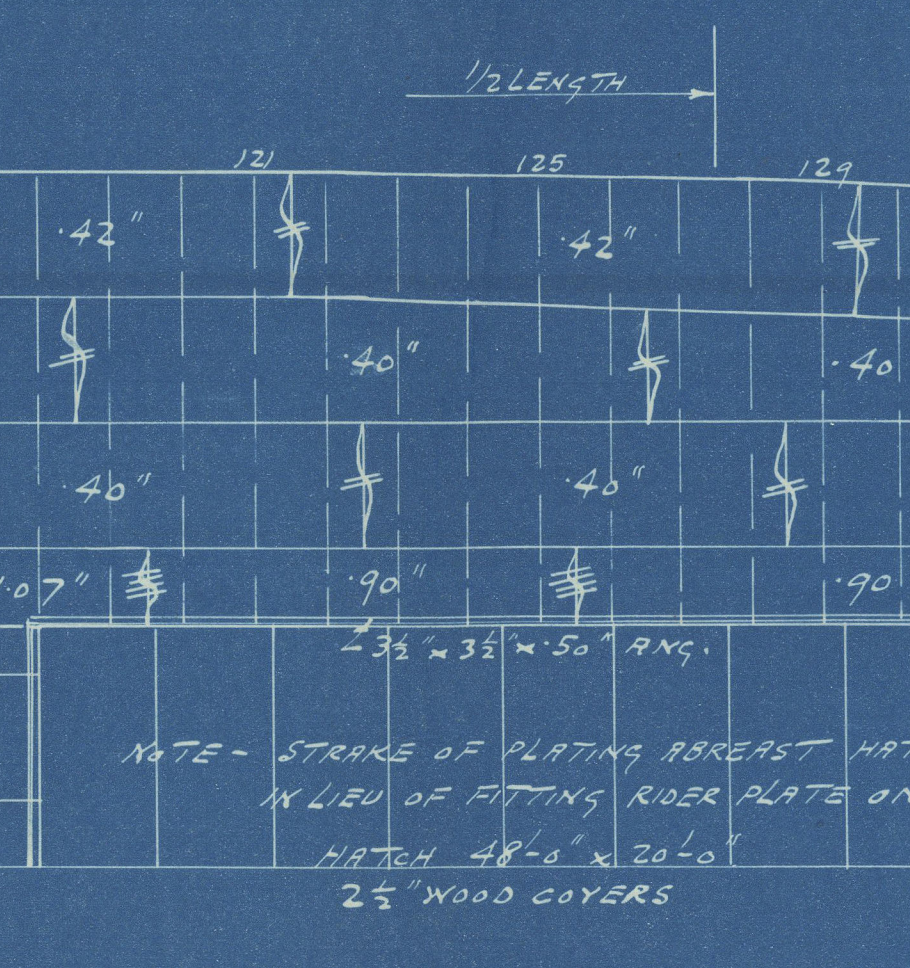
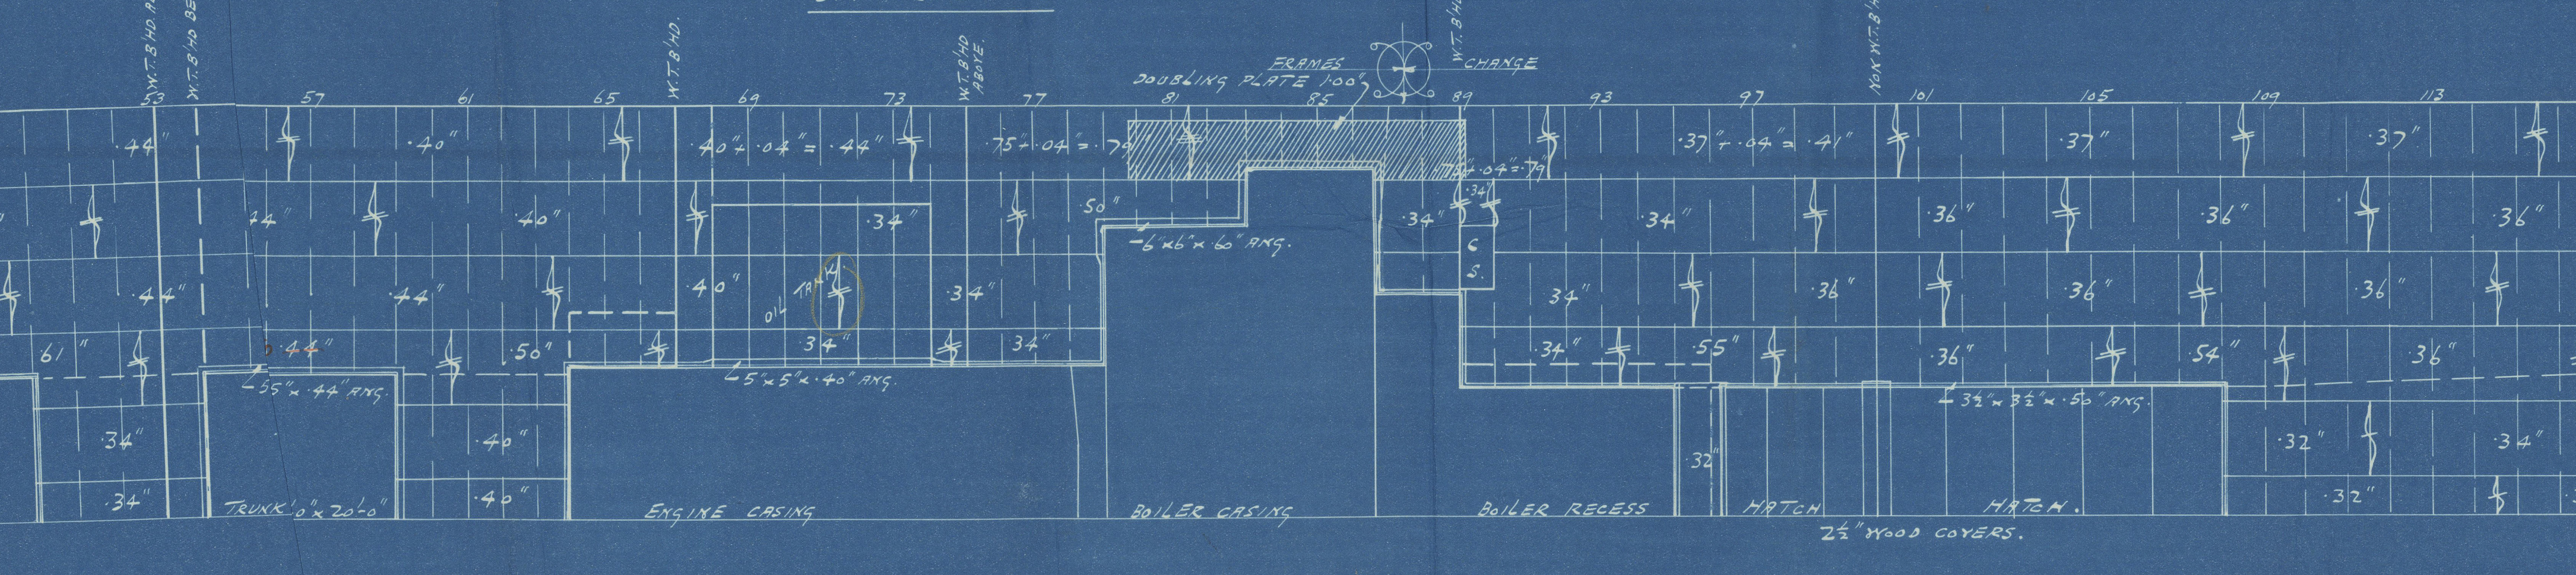
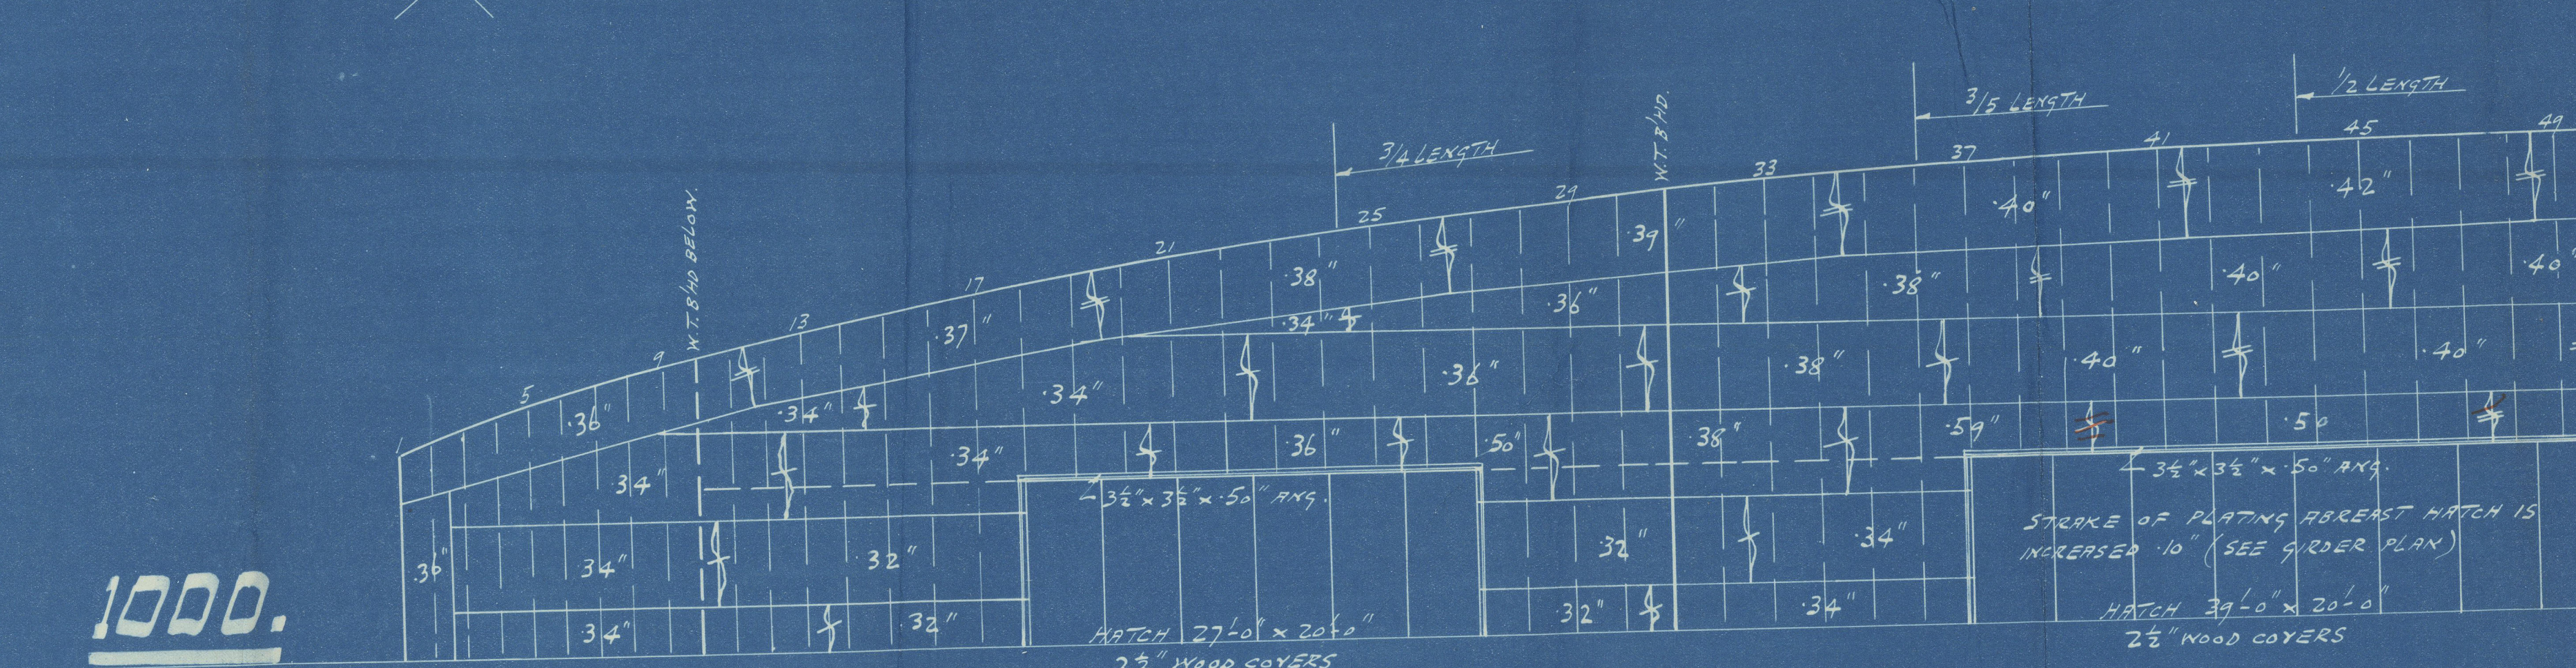
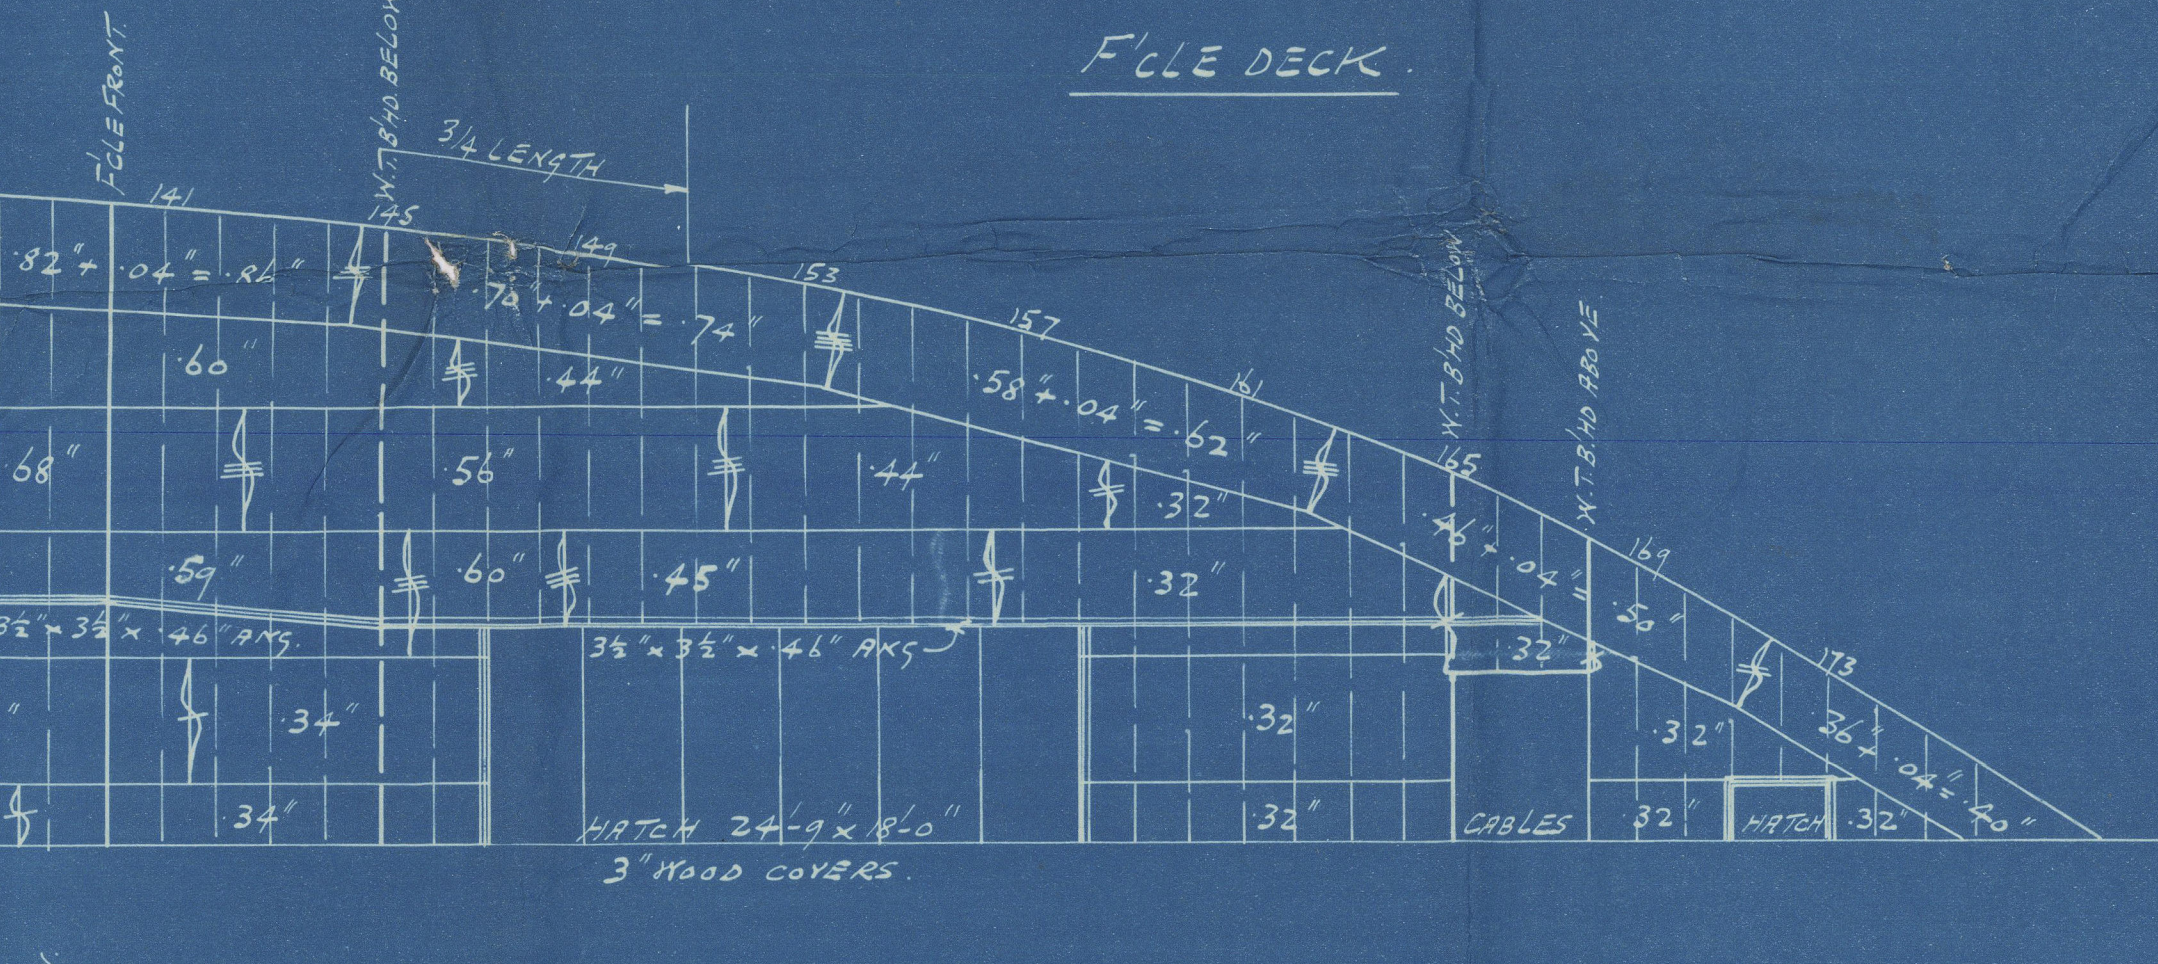
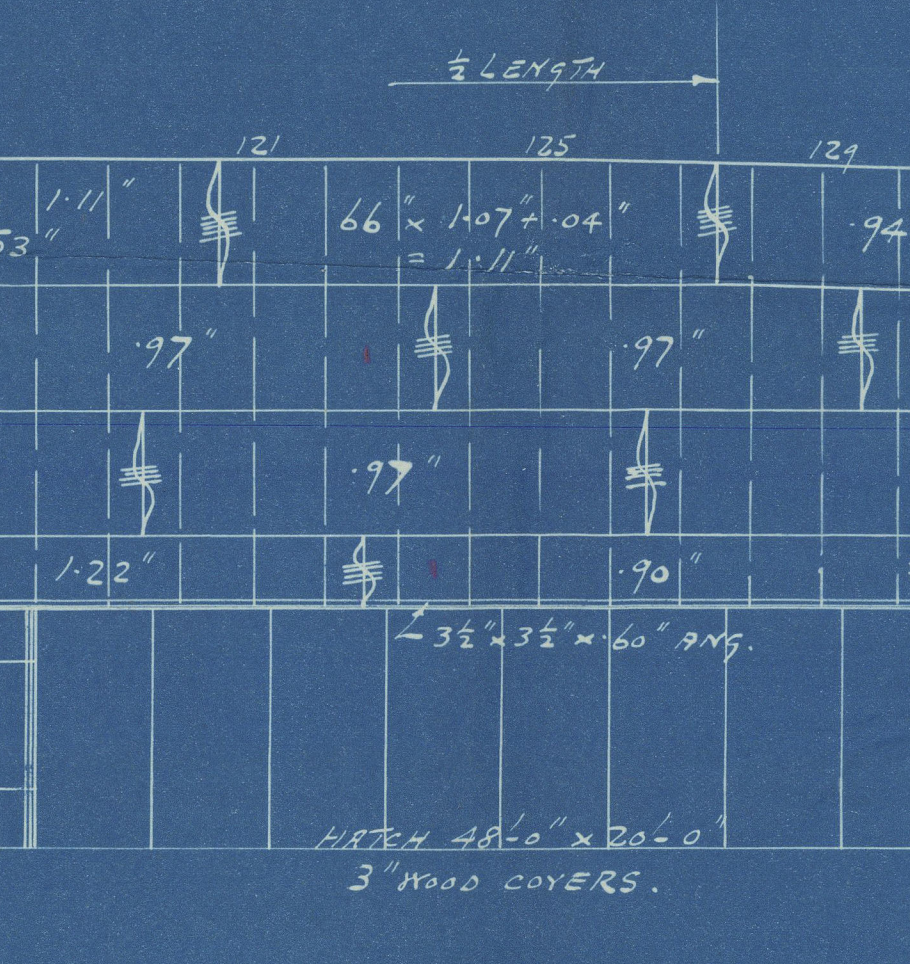
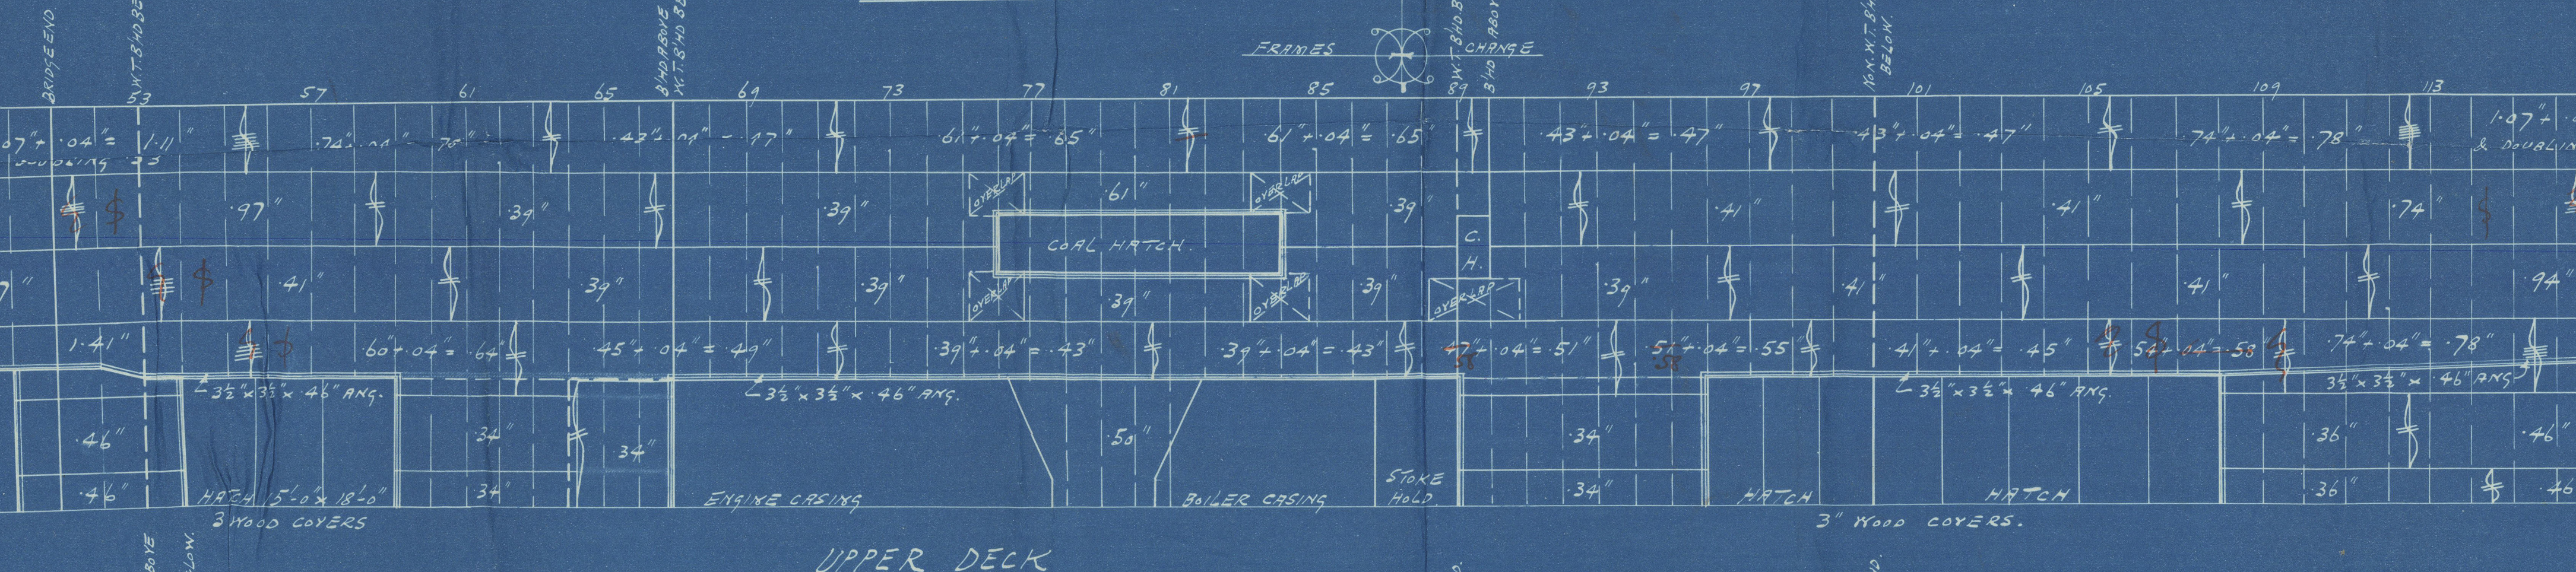
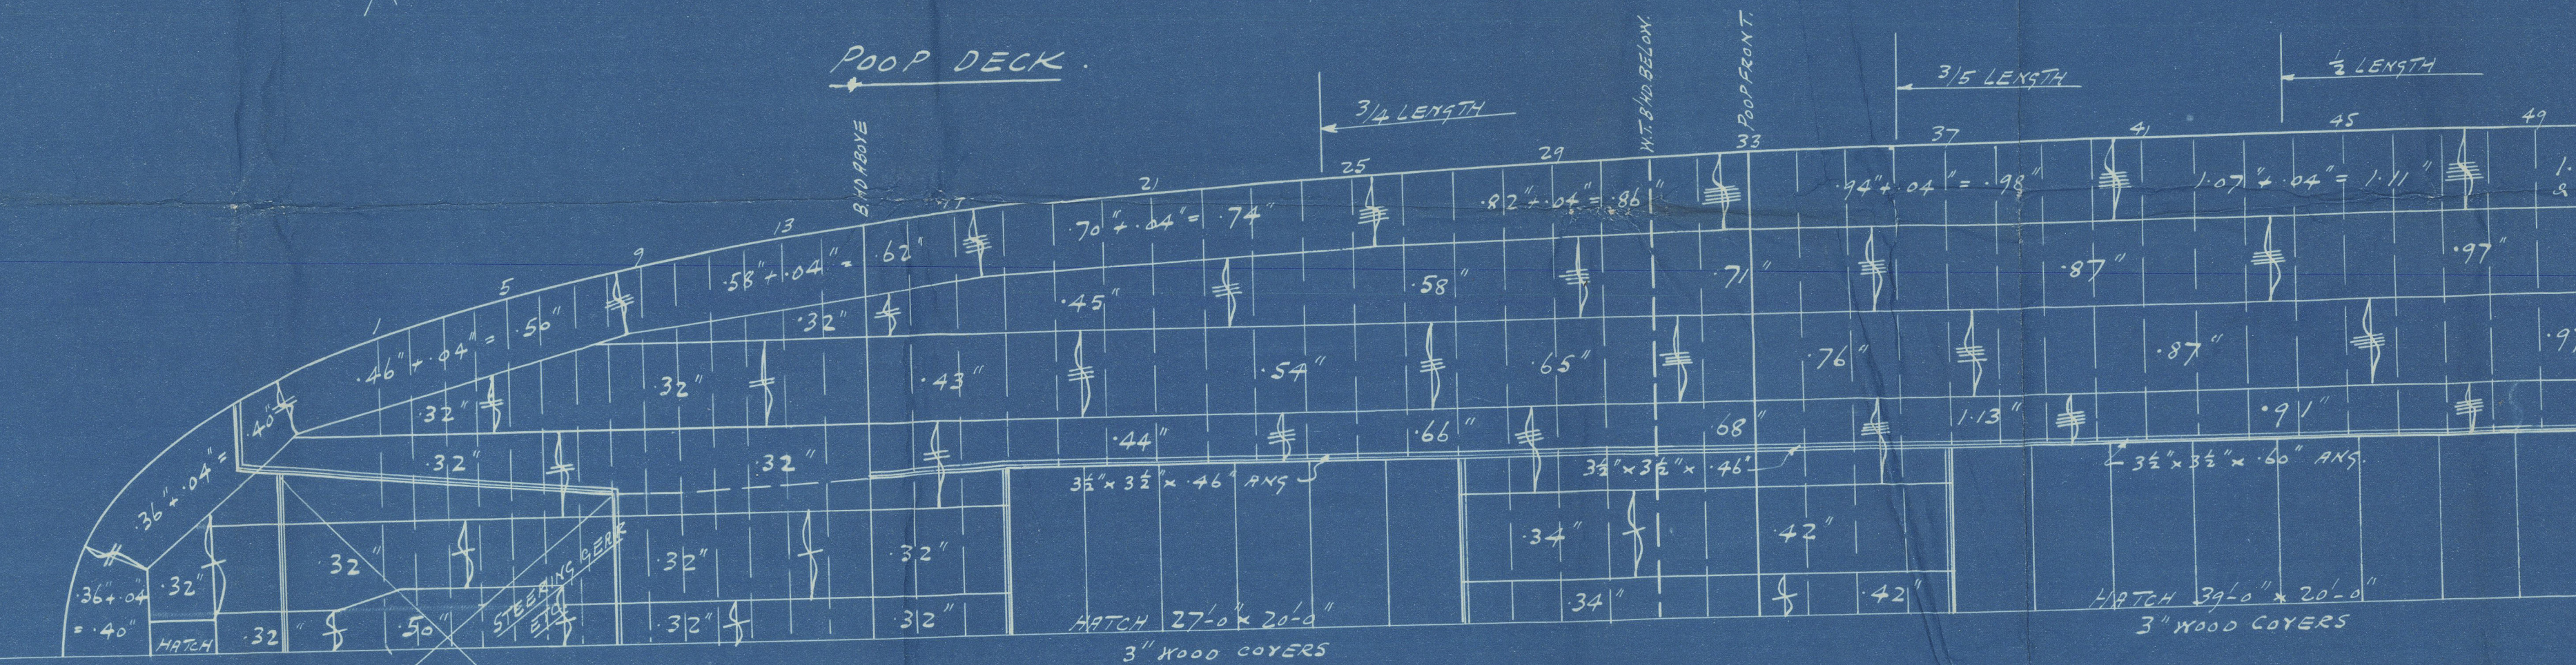
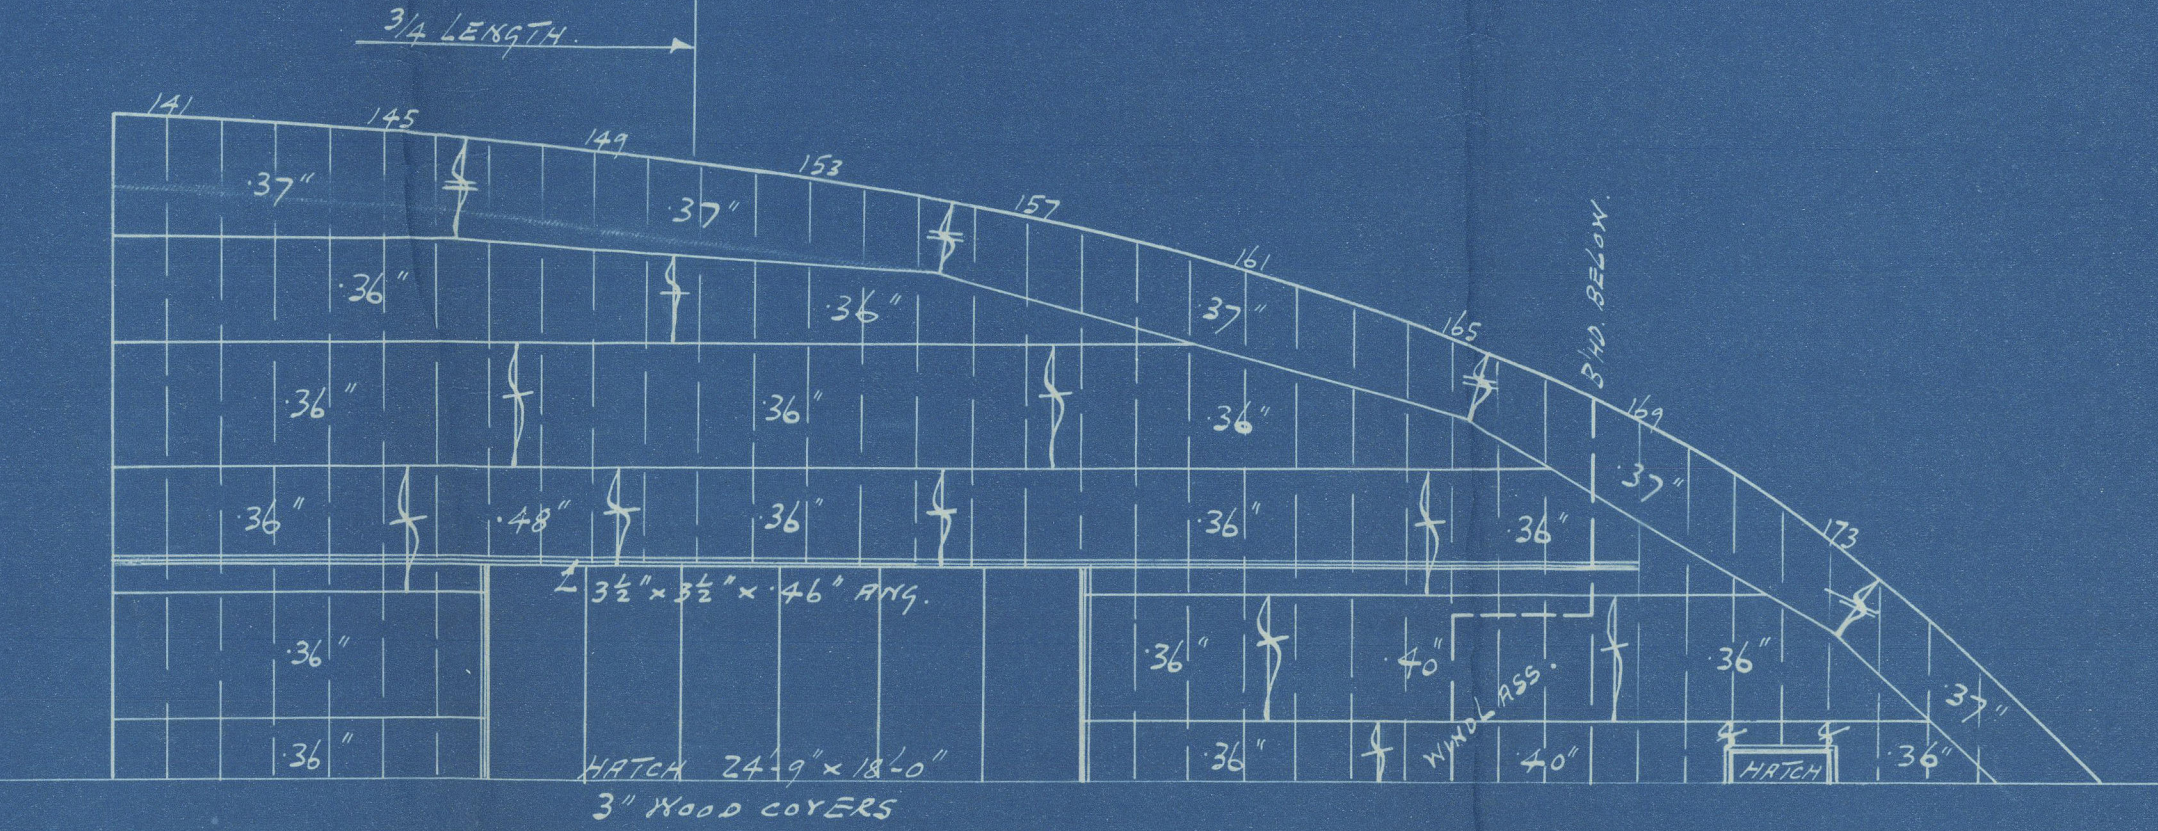


AMENDED ARRANGEMENT OF DECK PLATING

SCALE $\frac{1}{8}'' = \text{ONE FOOT}$

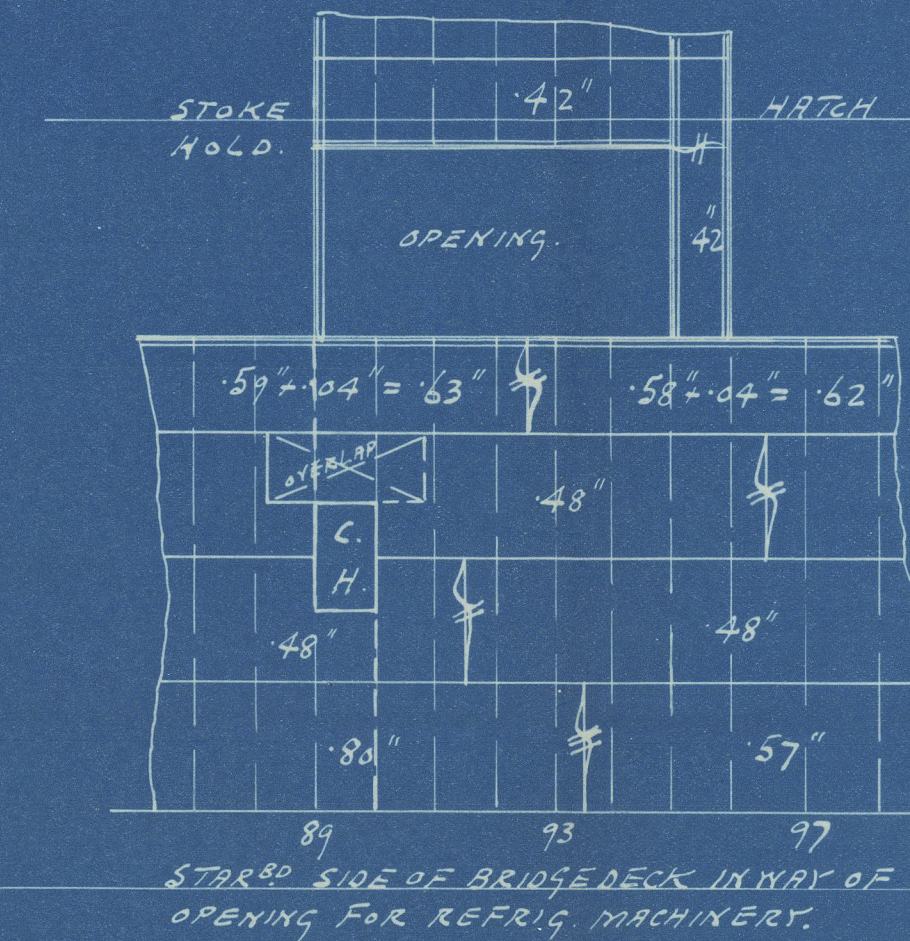

NOTE - DECK PLATING INCREASED AT HATCH CORNERS & CORNERS OF LARGE DECK OPENINGS IN LIEU OF FITTING DOUBLINGS.

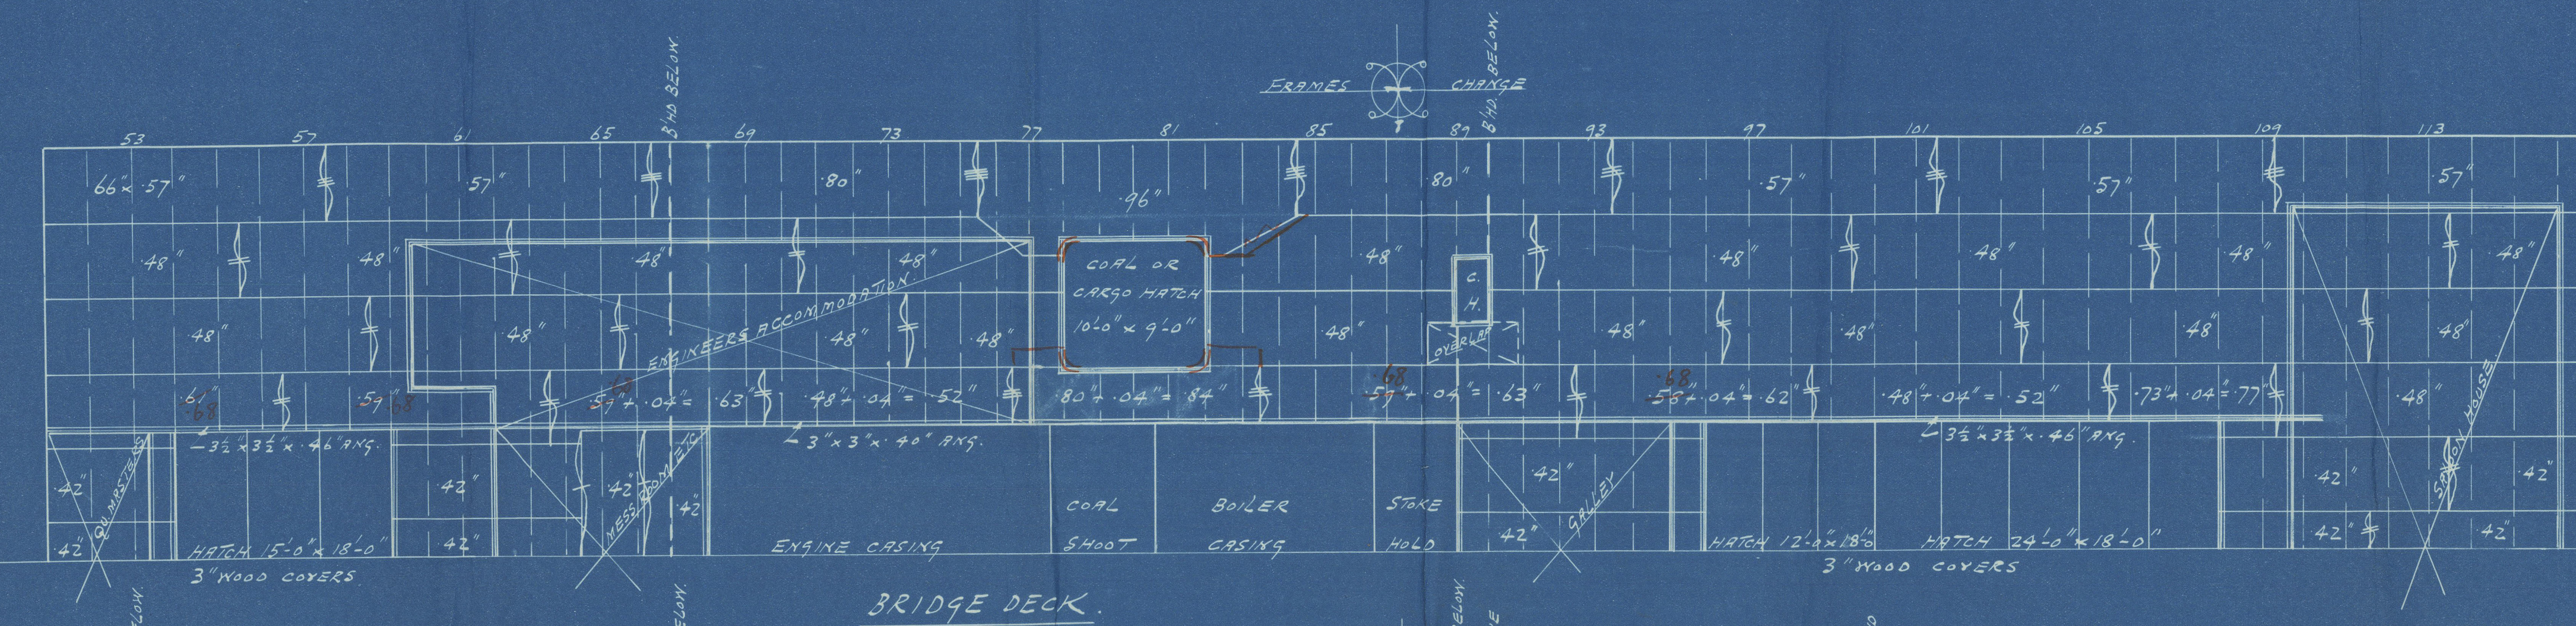

PLAN NO 32.
DRAWN BY J.W.T.
CHECKED BY

W. GRAY & CO. LIMITED
21. 3. 28
WEST HARTLEPOOL

1000

W.S.

26. 3. 28

CORRIGENDUM


WEST HARTLEPOOL

Messrs Wm Gray & Co Ltd

No 1000

Amended Arrangement
of plating of Decks

8 City of Dieppe
W. H. Pl. rep. 16775

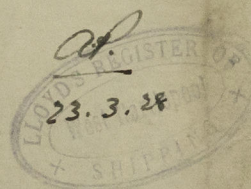

002897-002906-0073

© 2020

Lloyd's Register
Foundation