
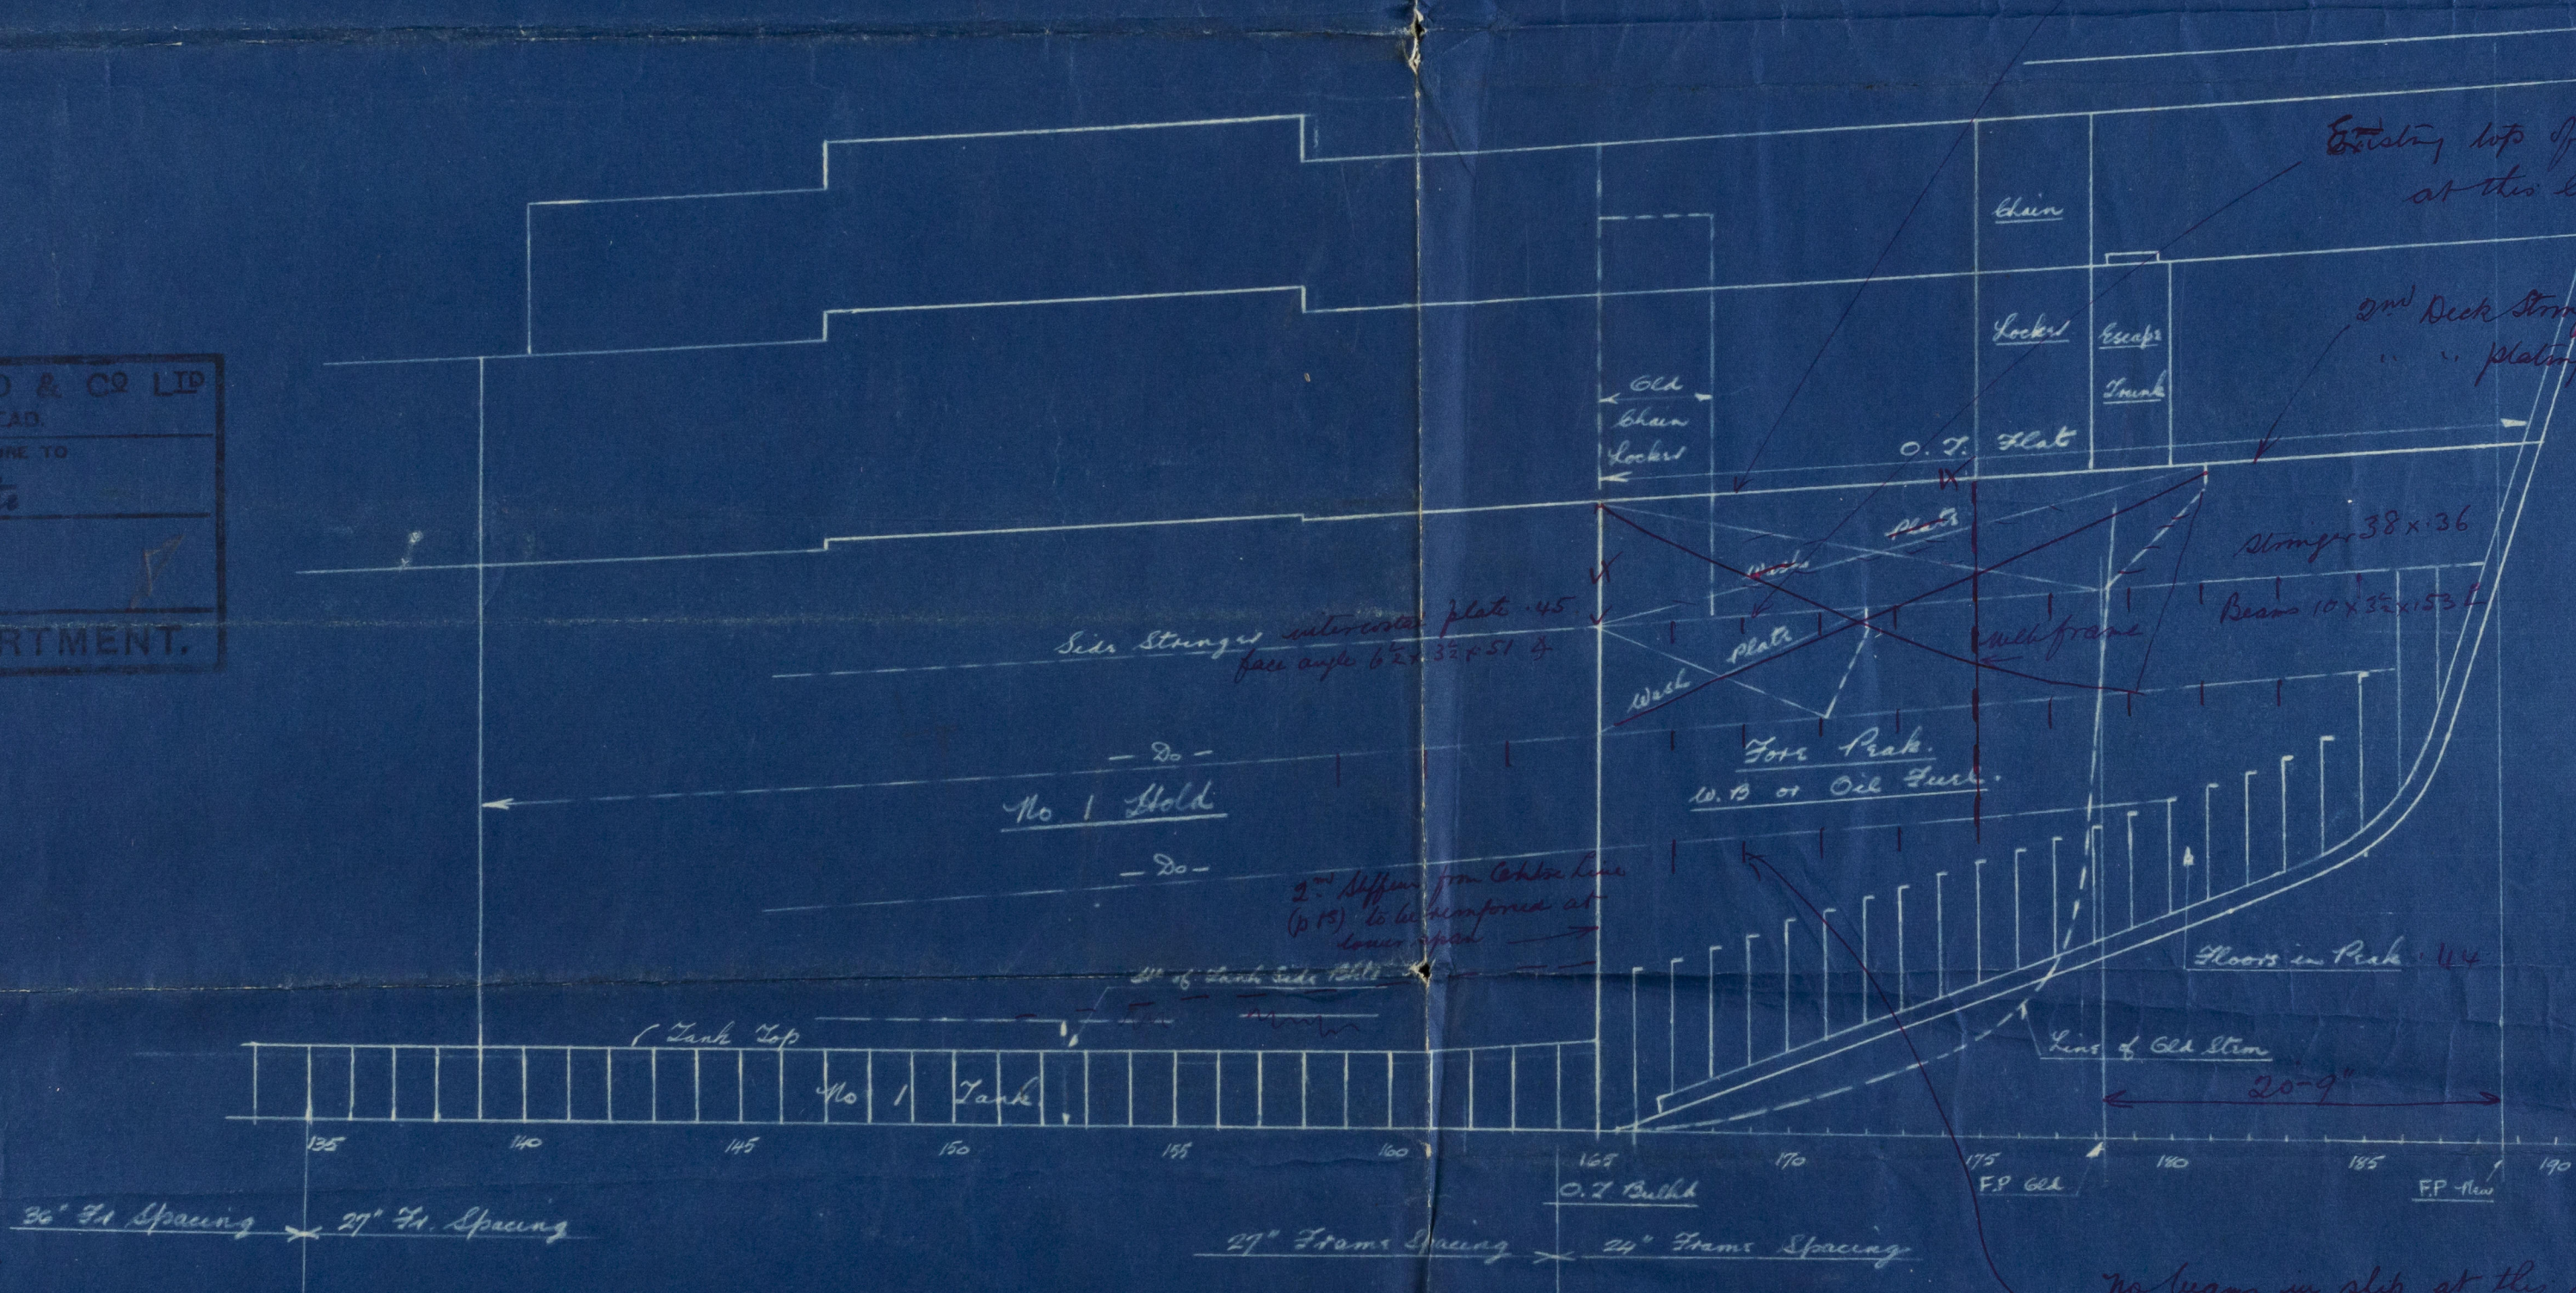


S.S. "City of Dieppe" 26/4/34

Proposed modification to Fore End.

Scale $\frac{1}{8}" = \text{One ft}$

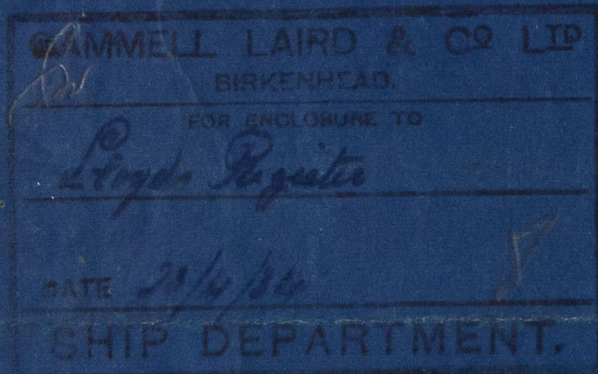

Before scantlings of beams can be considered plan will require to be submitted showing spans of beams & height of over flow.

Seams to be double riveted or existing seams reinforced by Electric Welding in way of oil.

No beams in slip at the stmper but there may be require to be fitted when exact form is determined.

Main Frames. 15 x 14 x 4, 60% channel
" Reverse Frames. 4 x 4 x 4 (see angle, same joint frame)

Frames 9 x 32, 39 L.

Particulars of Web Strs (if any)
? Any modification to Equipment.
Particulars of Side Stringers.

Particulars of Panting Beams & Stringers in Peak.
Sigs of Stems 10 3/4 x 2 3/4



Modification of fore end

S. S. "City of Dieppe"

LIVERPOOL:

Report No. 104343

(Plan in duplicate).

002897-002906-0077

© 2020



Lloyd's Register
Foundation