

N<sup>os</sup> 1239-40.

DIMENSIONS- 146'-6" B.P. x 25'-0" MLD. x 14'-0" MLD.

25 APR 1941


1245-46

1253-54

1259- 60


1265-66

SEE DETAIL PLAN OF  
CRUISER STERN.

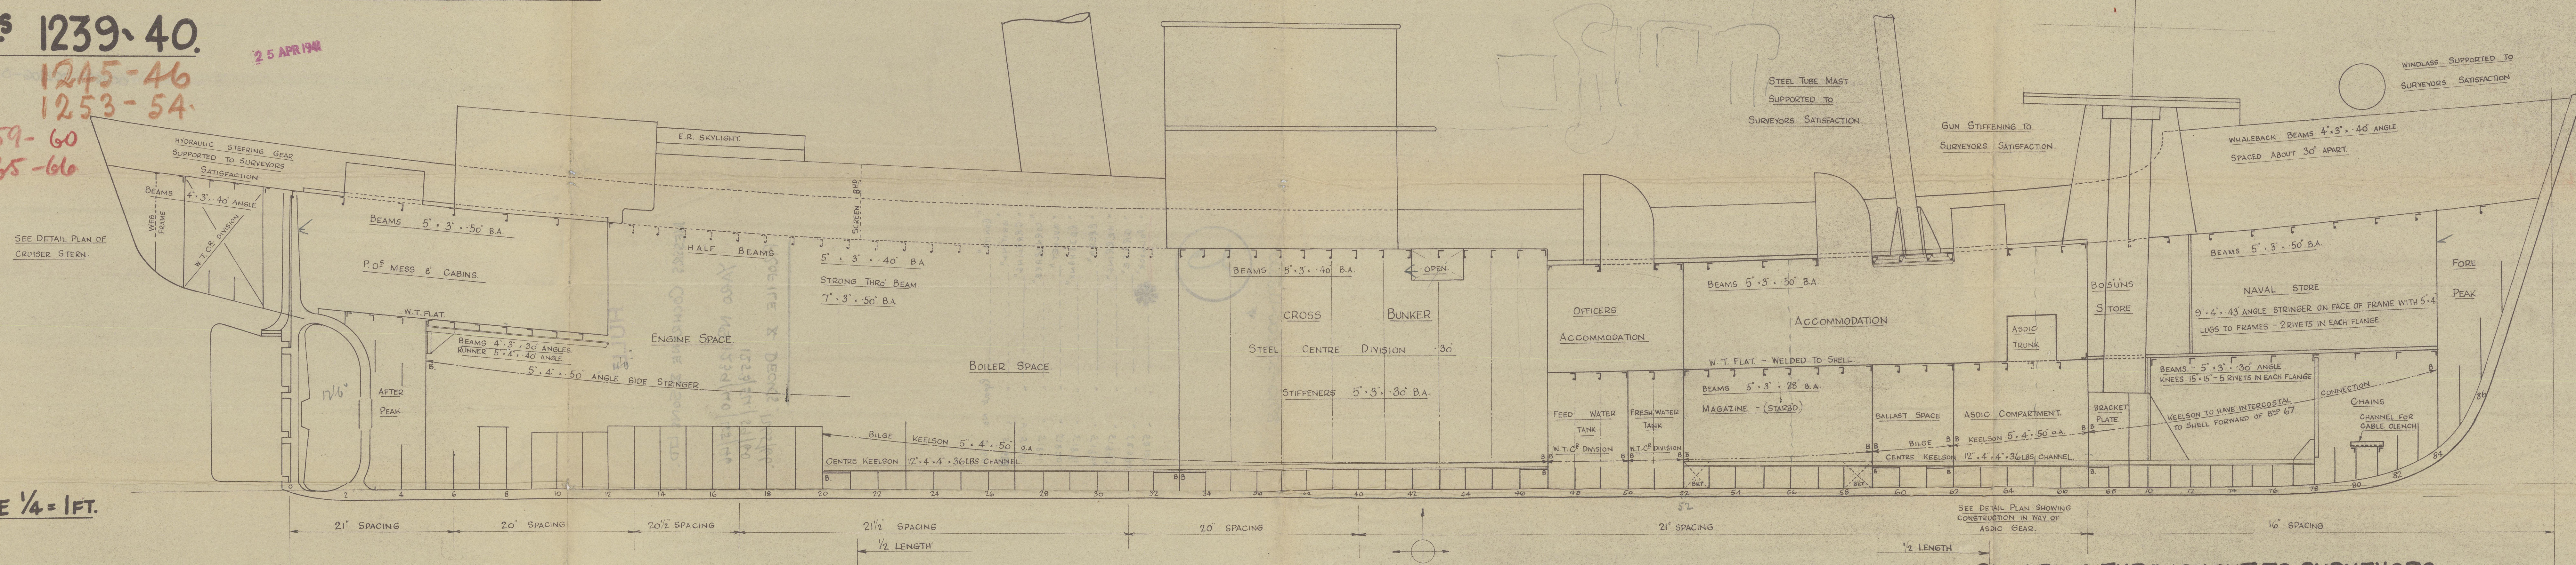

SCALE  $\frac{1}{4} = 1 \text{ FT.}$

# PILLARING THROUGHOUT TO SURVEYORS

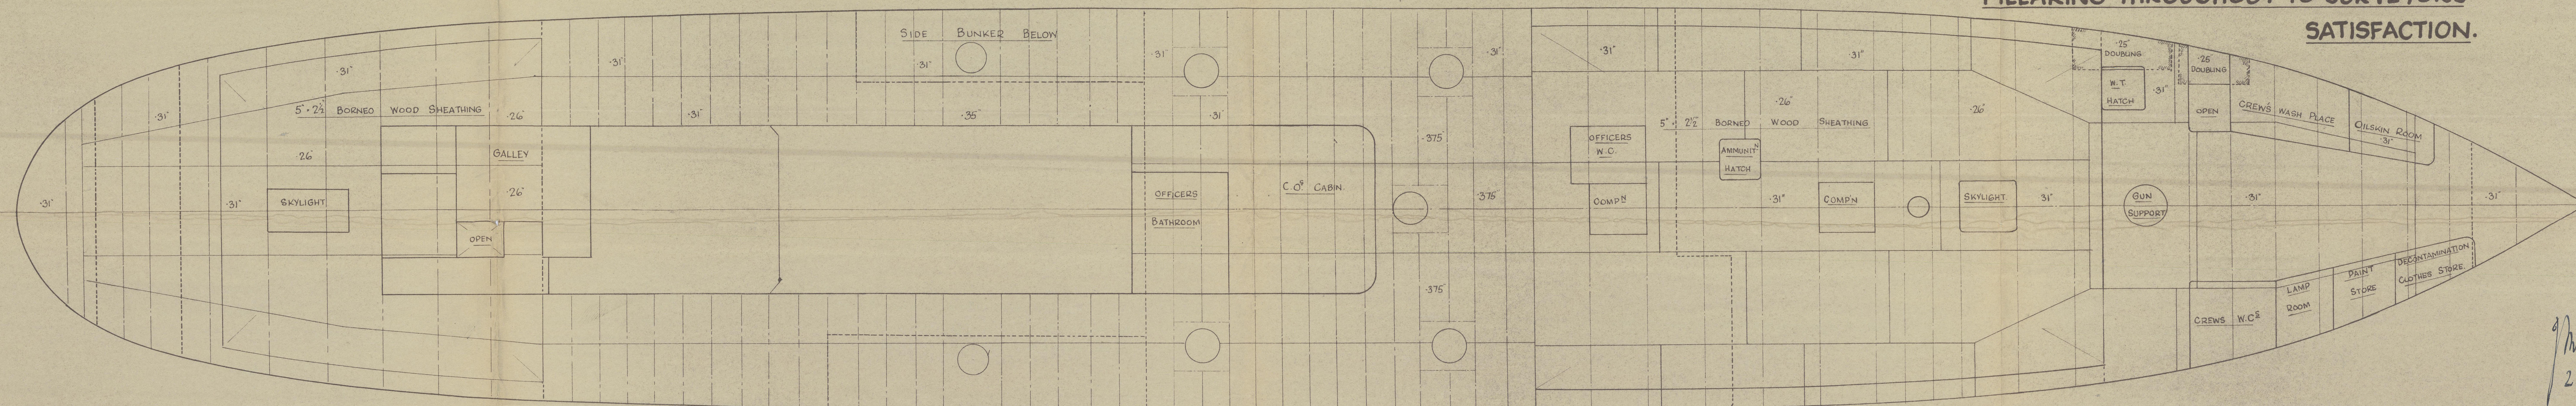

24-4-41





002897-002906-0168



© 2020

Lloyd's Register  
Foundation



HULL

MESSRS COCHRANE & SONS LTD.

YARD NO 1239/40/45/46  
1253/54/59/60

PROFILE & DECKS 1265/66.

" BONITO "	Report No.	51601.
" WHITING "	"	51638.
" GRAYLING "	"	51681.
" CORNRACE "	"	51861.
" MULLET "	"	51820.
" REDSHANK "	"	51891.
" BREAM "	"	51964.
" HERRING "	"	51999.
" GRILSE "	"	52090.
" POLLOCK "	"	52104.



© 2020

Lloyd's Register  
Foundation

002897-002906-0168