

No 918G.

FIN CASTING. (1 OFF, MILD STEEL CASTING)

SCALE $1\frac{1}{2}" = 1 \text{ FOOT.}$

NOTES.


WORK TO MOULDS IN PREFERENCE TO PLAN.

ALL RIVET HOLES TO BE DRILLED BY MAKERS


AS SPACED ON MOULDS AND TO BE $\frac{1}{16}"$ LARGER

THAN DIAM. OF RIVET SHOWN.

TESTS: LLOYDS & BOARD OF TRADE.

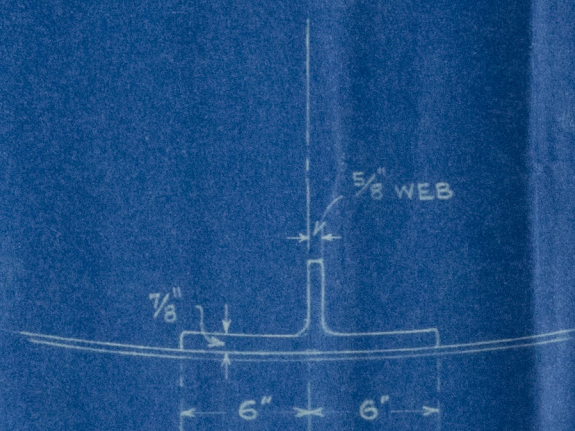

SECTION AT FRAME 6.
LOOKING AFT.

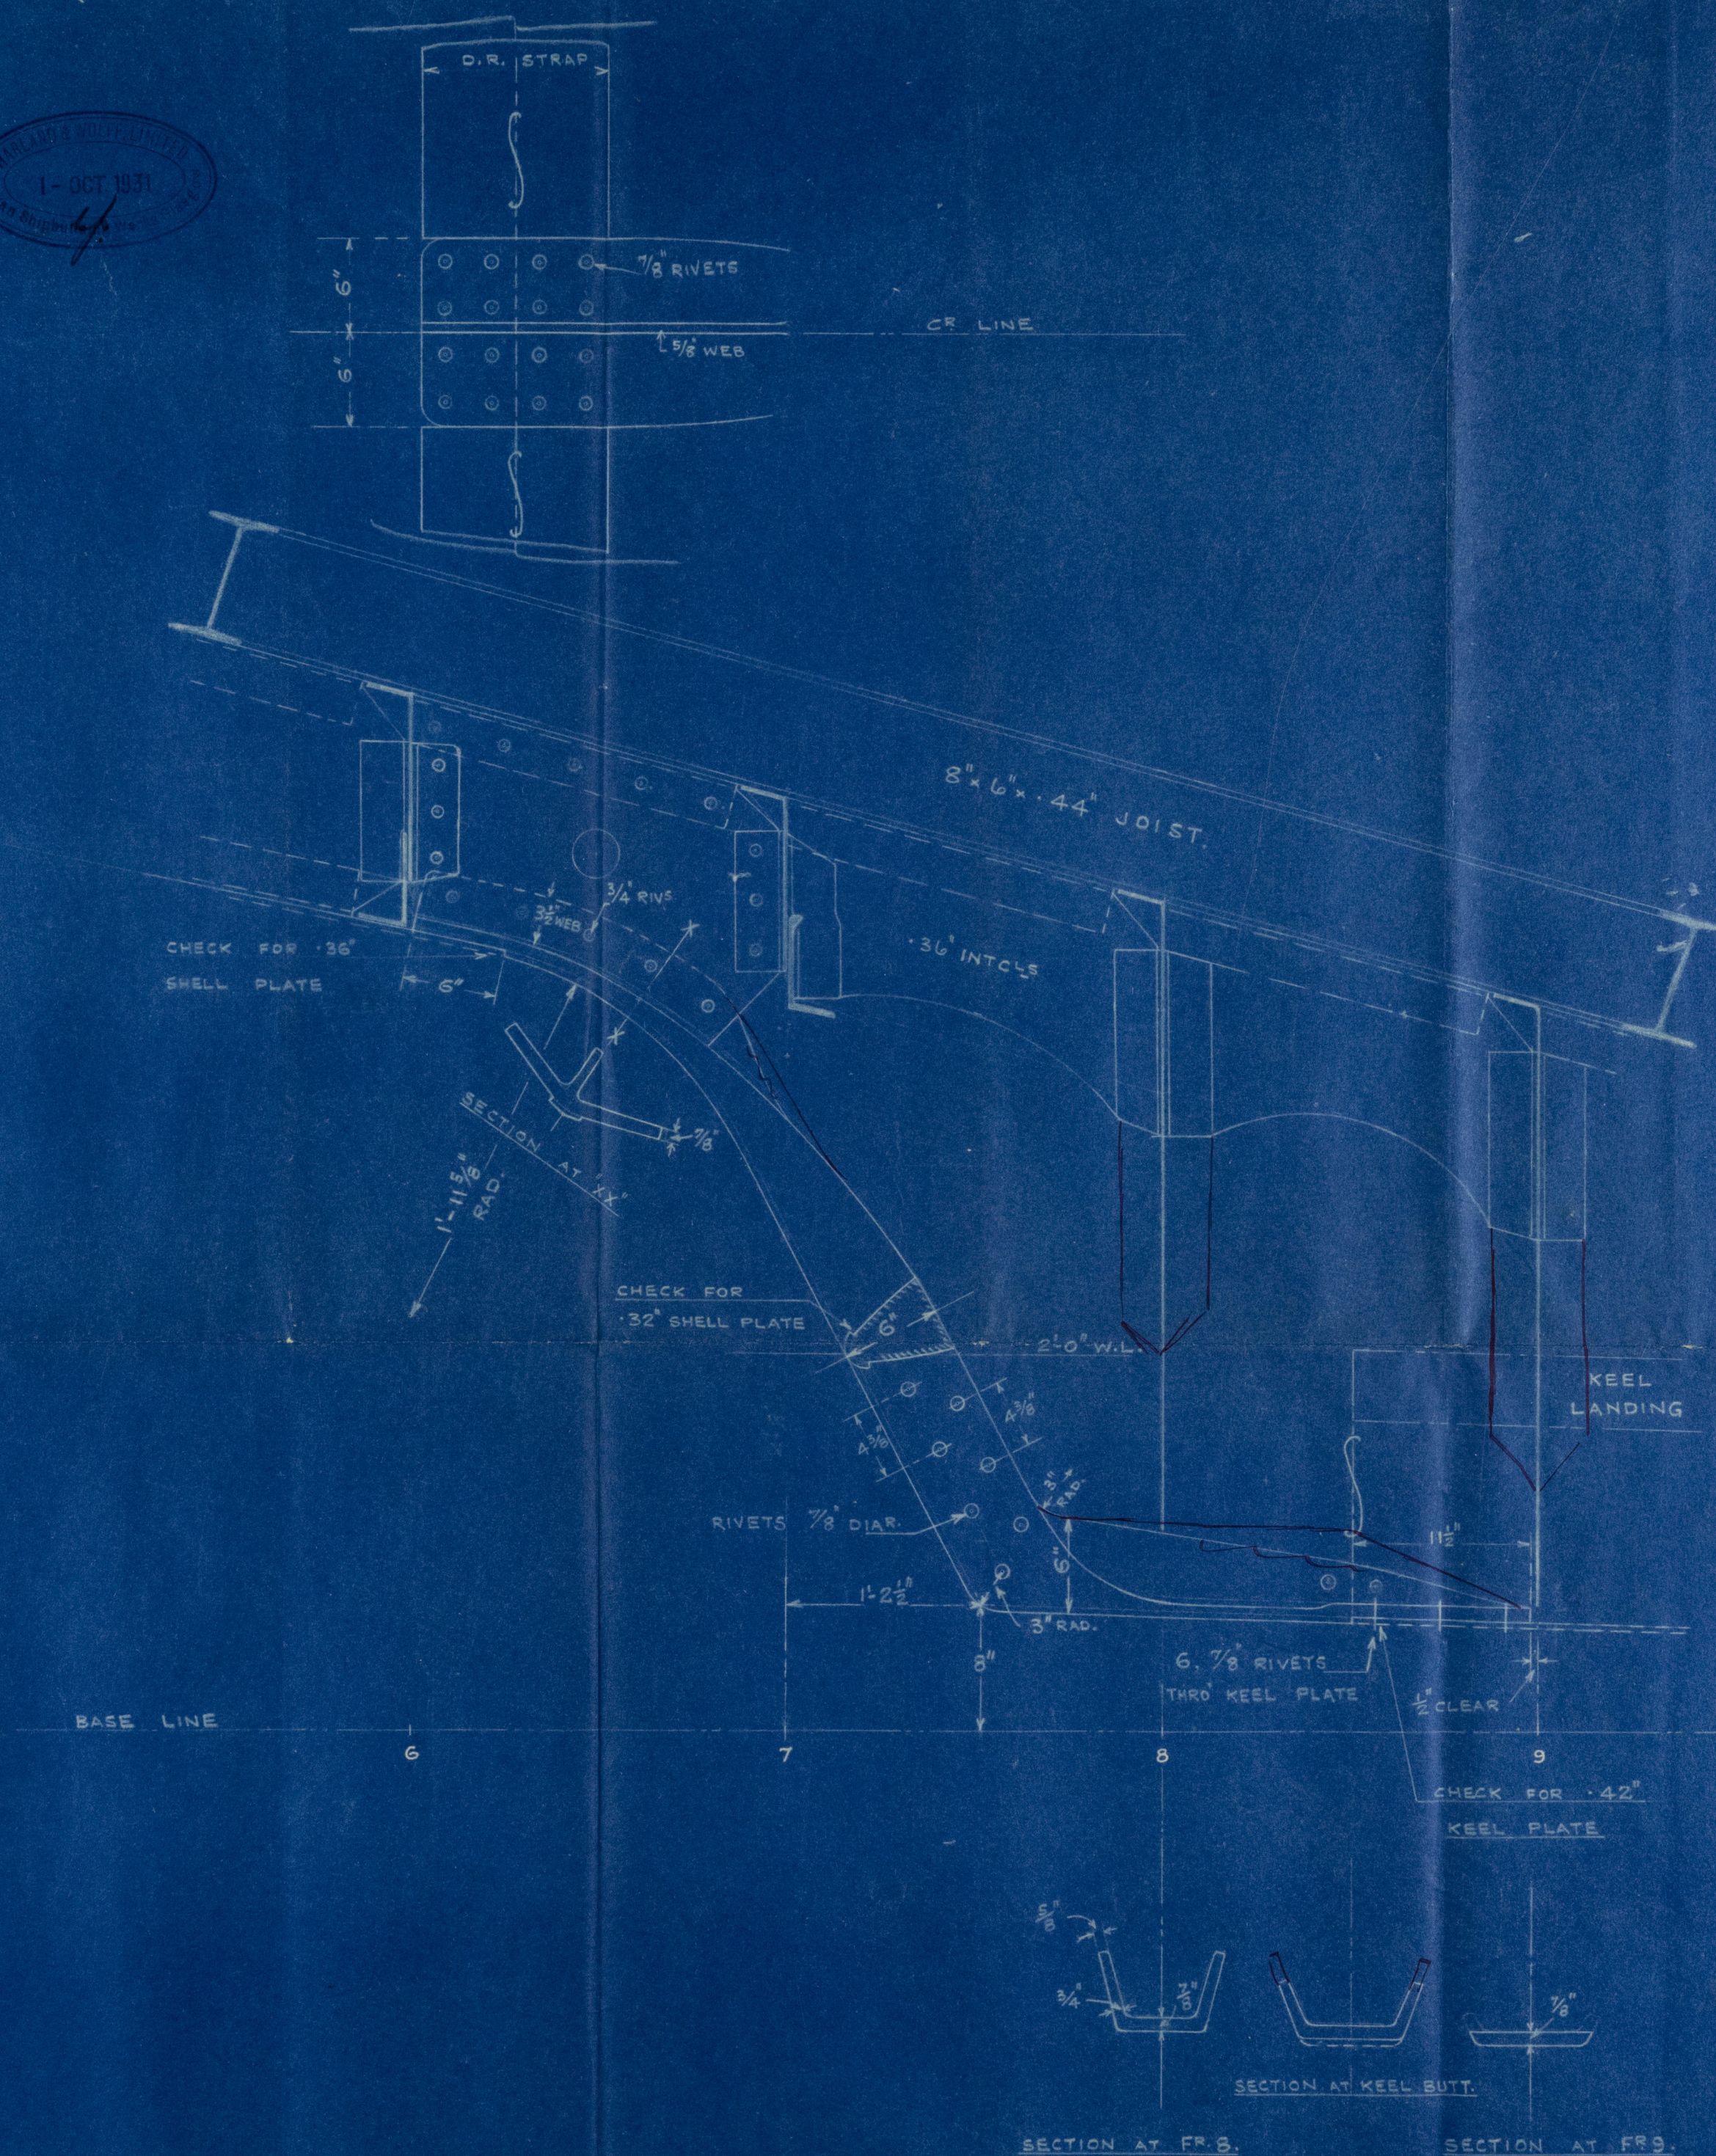

APPROVED
LLOYDS REGISTER OF SHIPPING

Wickham

DATE 5.10.31



Messrs. Harland & Wolff Ltd.

Jard N^o 9189.

Plan of Lin casting.

"Royal Iris II."

GLASGOW REPORT No. 52440



© 2021

Lloyd's Register
Foundation

007907-002415-0251