

S.S. No 457-458.

-CLASSE: 100.A.I. LLOYDS REGISTER.-

-WROUGHT STEEL SINGLE PLATE RUDDER AND-
-STERNFRAME.-

-SCALE 3/4"=1 FOOT.-


*Spare tiller & independent means
of steering to be provided (See Sect 43).*

-QUADRANT.-




-DETAIL OF PINTLE.-

-SCALE 3"=1 FOOT.-

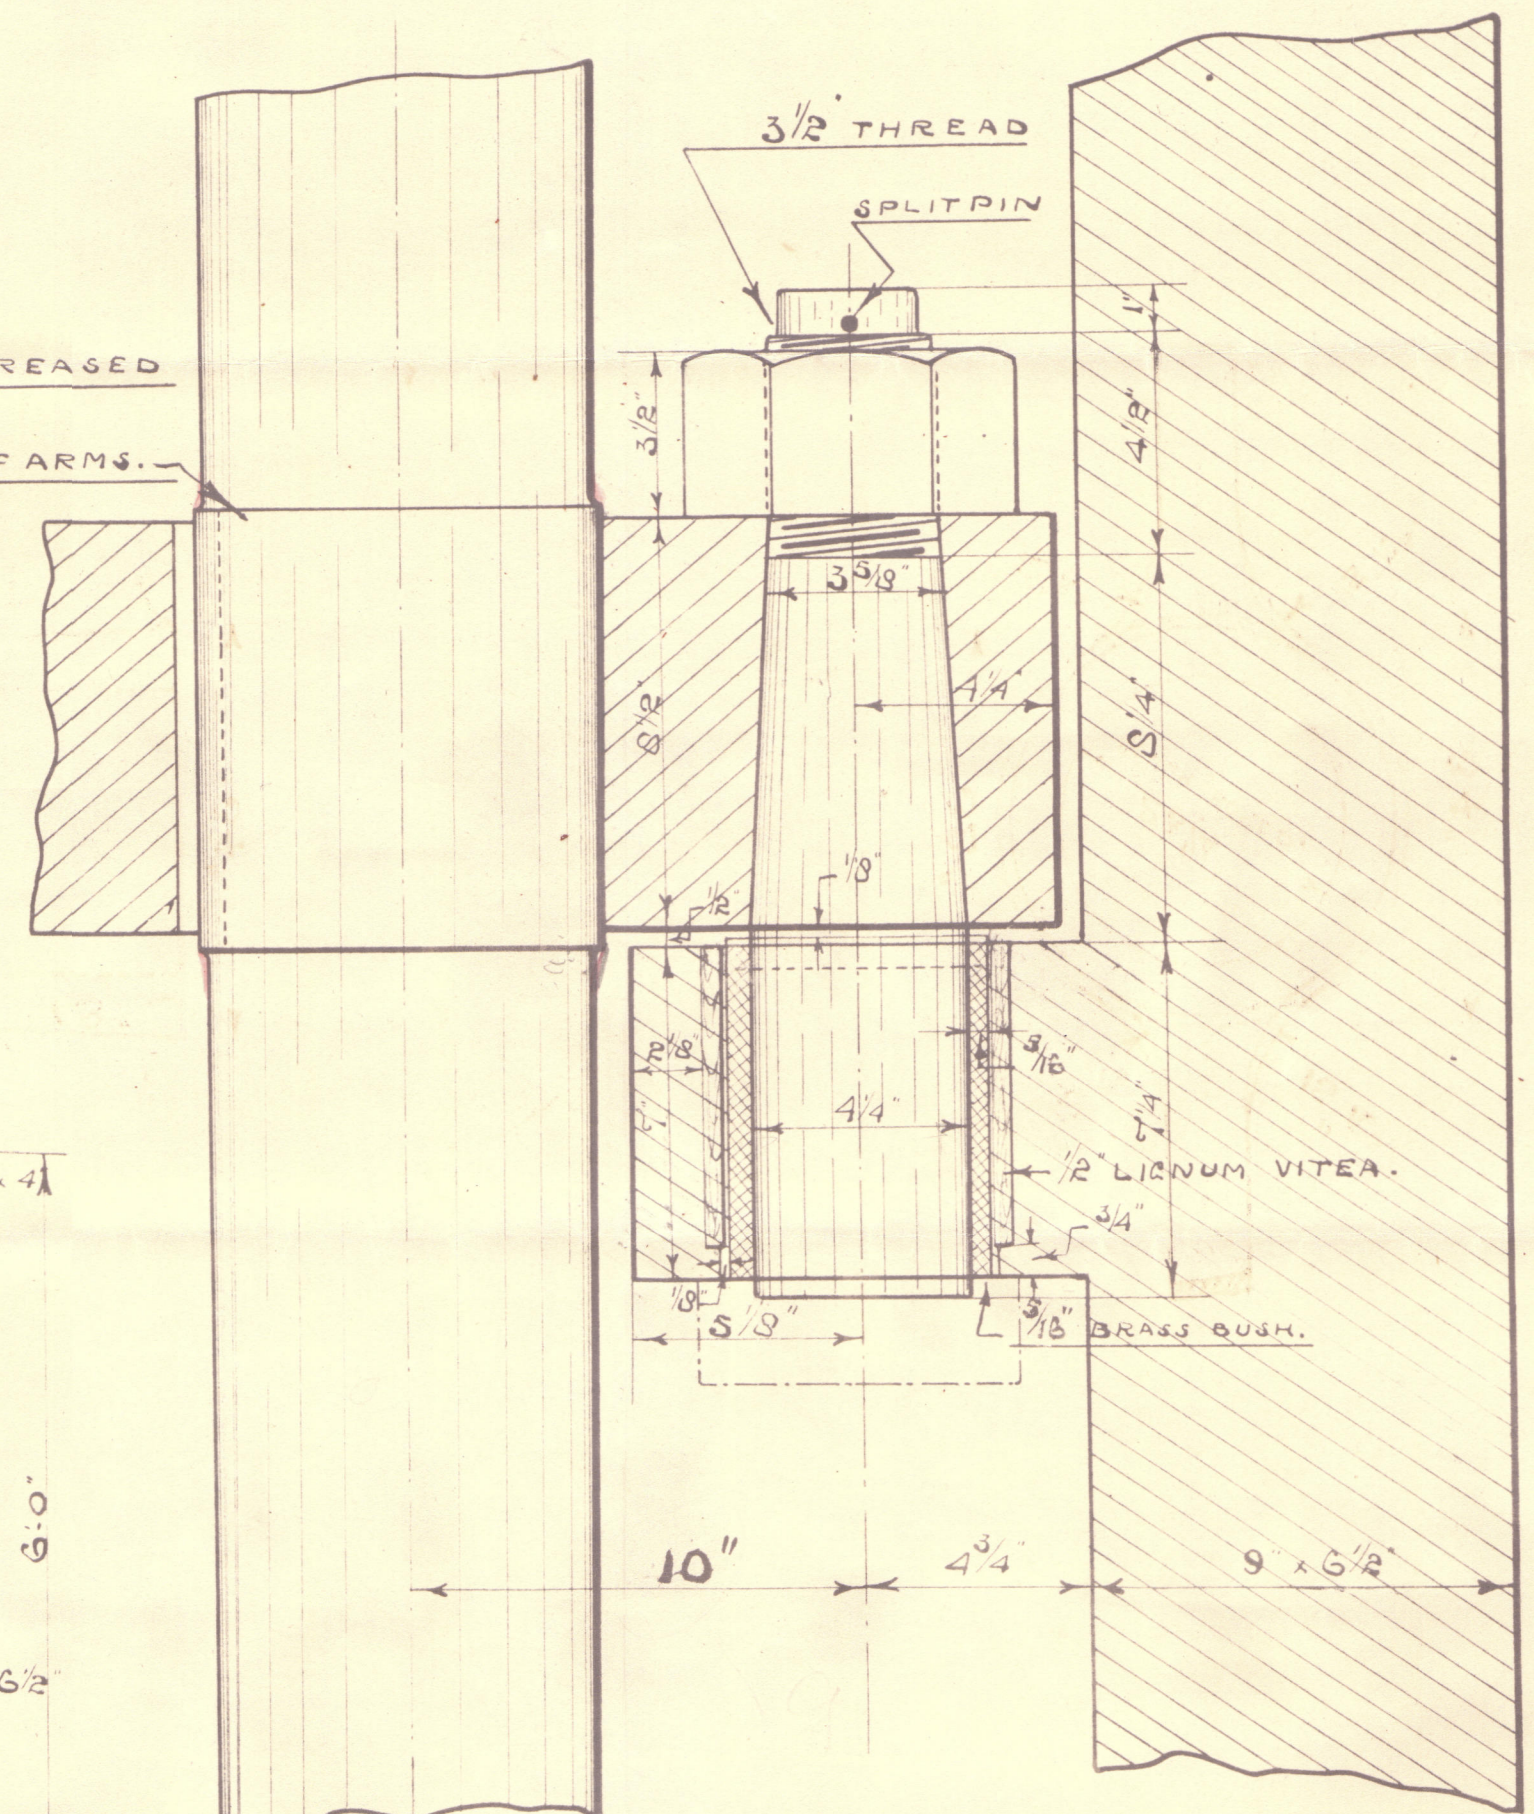


-SECTION

A-B-

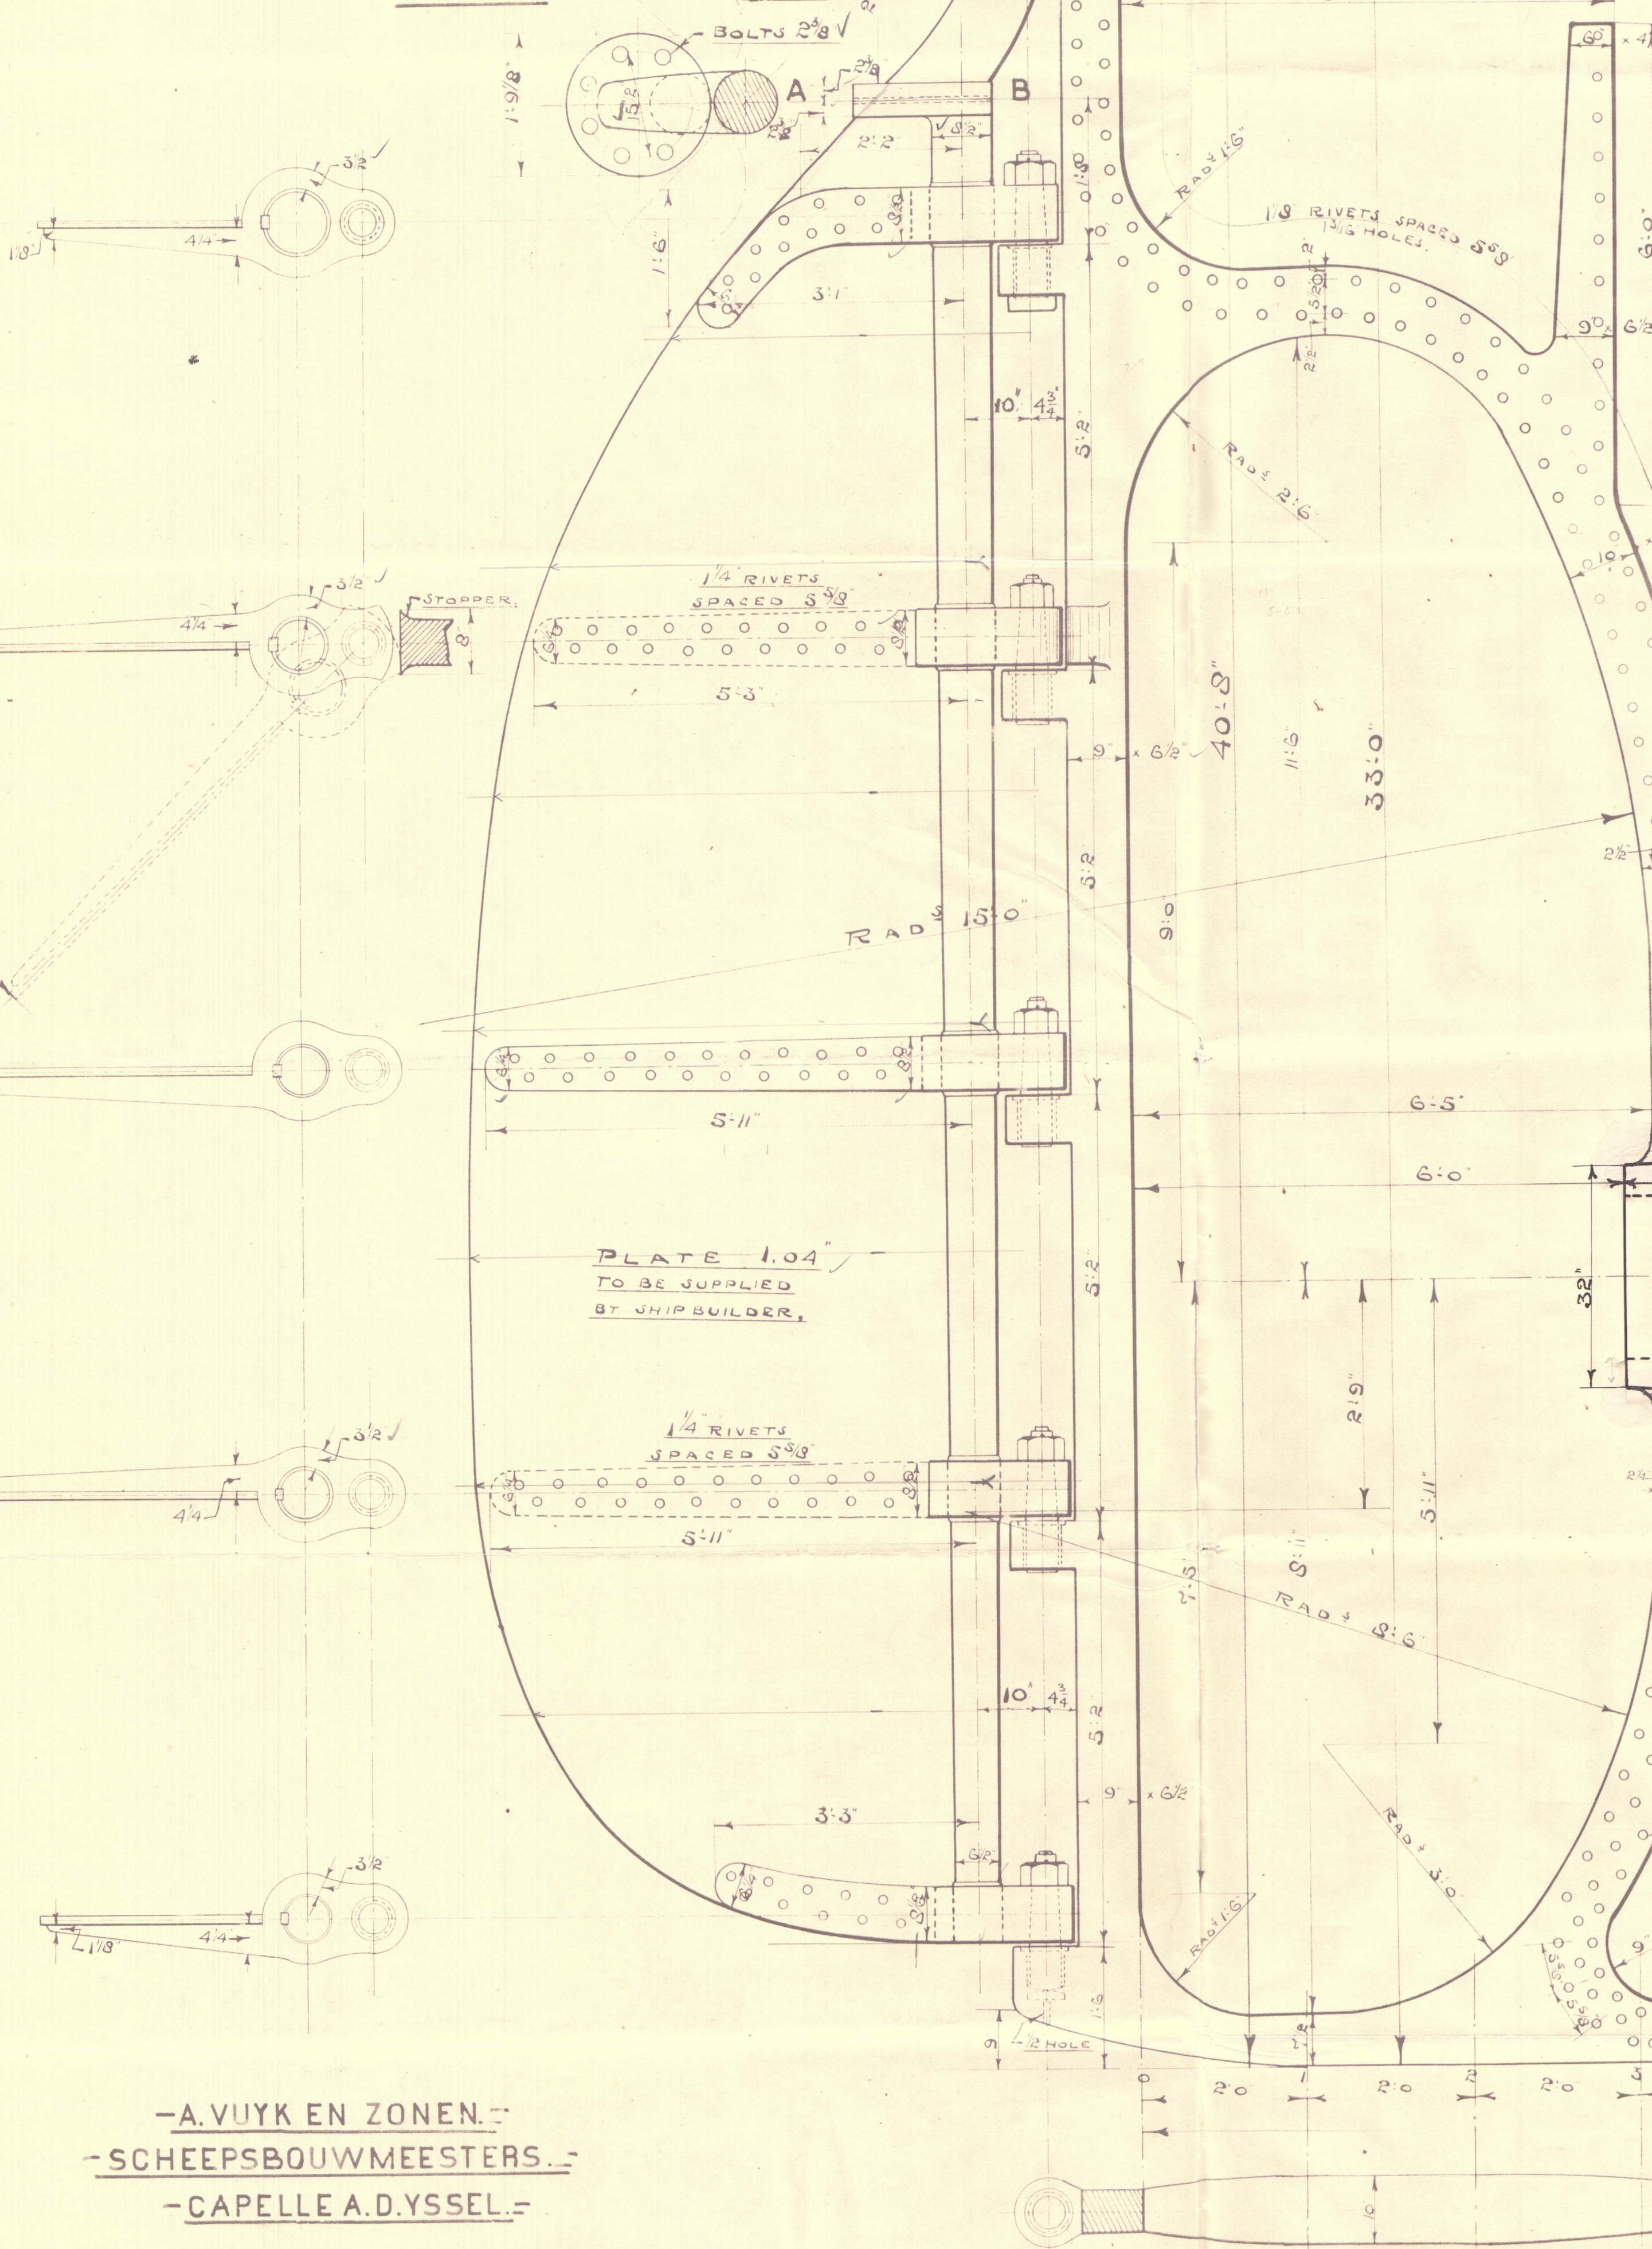

SPEED UNDER 10 KNOTS.-

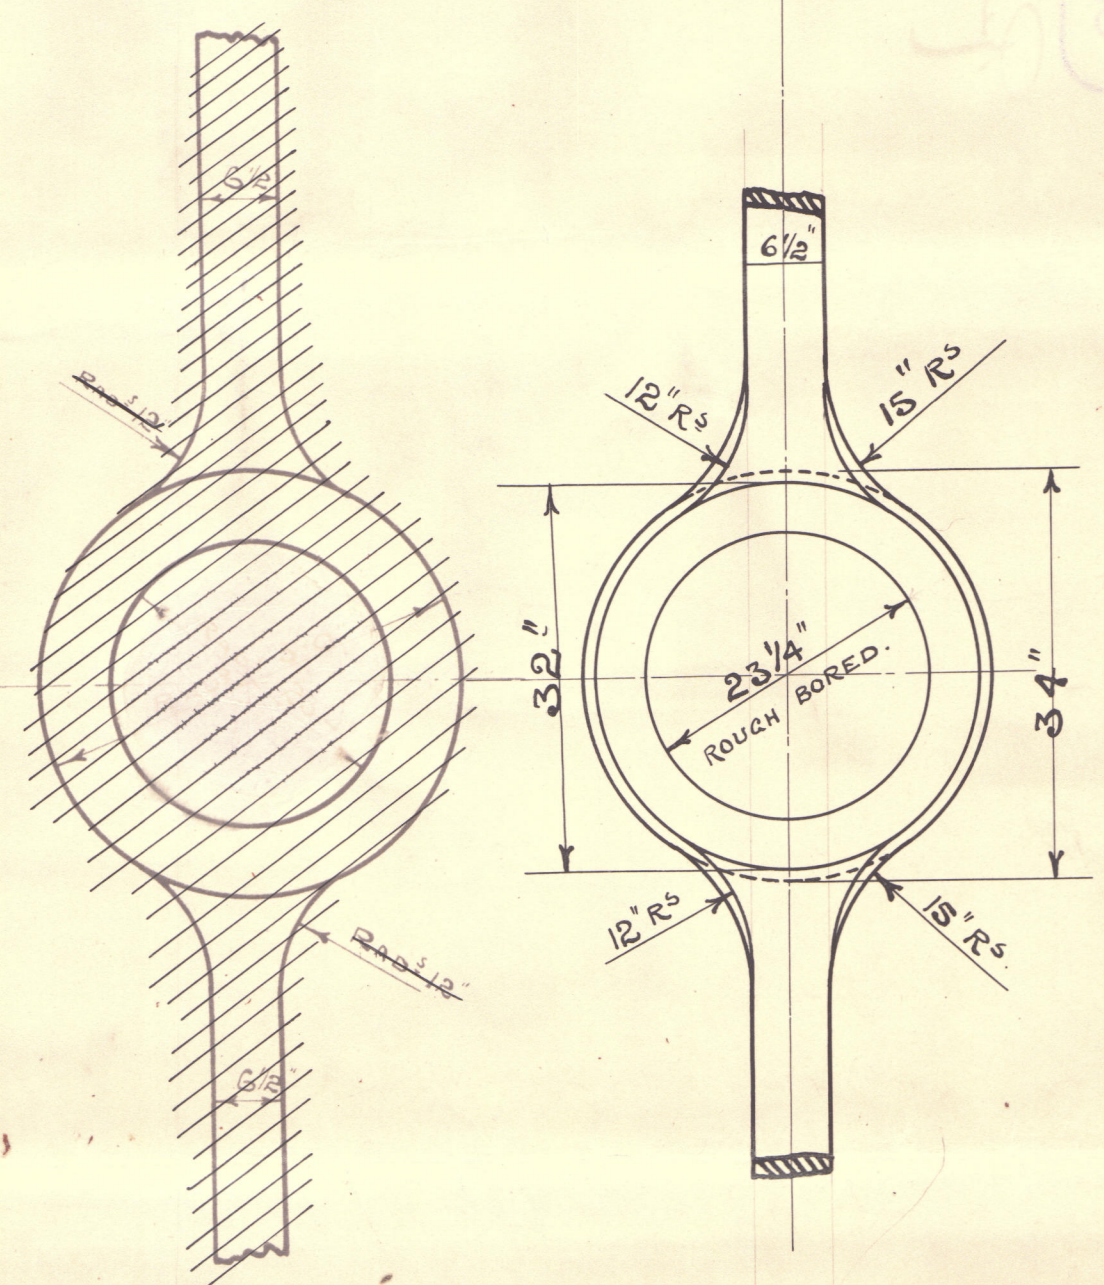

-SECTIONS OF KEELSCARPH.-

-A.VUYK EN ZONEN.-

-SCHEEPSBOUWMEESTERS.-

-CAPELLE A.D.YSSEL.-

IN ACCORDANCE WITH THE
APPROVED PLAN OF LLOYDS REGISTER
OF AUG 25 1917

1102.

A. VUYK & ZONEN
SCHEEPSBOUWMEESTERS

✧ 457-488 ✧

Cappelle a/d IJssel.

Rudder & Sternrame

KLAUS OLDENDO²⁴FF

"Silversum"

Rot. 114 31.



© 2020

Lloyd's Register
Foundation

002916-002922-0156