

HARLAND & WOLFF LIMITED,
GOVAN, GLASGOW.

THIS ENCLOSURE TO BE SENT TO

MESSRS THE SURVEYORS TO
LLOYD'S REGISTER OF SHIPPING

0042 2/2


Harland & Wolff's 677 G & 678 G.

M.V.'s "ELMBANK" & "FORRESBANK"

Plan of Rudder.

Transferred to Inverbank
from Elmbank

GLASGOW REPORT No. 44610

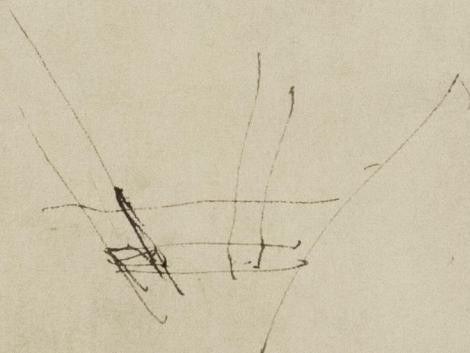

© 2020

Lloyd's Register
Foundation

002923-002928-0040