

$$\begin{array}{r} L \times D \text{ ----- } 1721 \\ L \times (B+D) \text{ ----- } 4845 \end{array}$$

## EQUIPMENT


— MIDSHIP SECTION —  
STEAM SCREW TRAWLER

— № 1201 —

127'-6" B.P. x 24'-6" MLD. x 13'-6" MLD.  
TO CLASS  $\nabla$  100.A.I. STEAM TRAWLER

SCALE  $\frac{1}{2}$  IN = 1 FT.

RIVETING

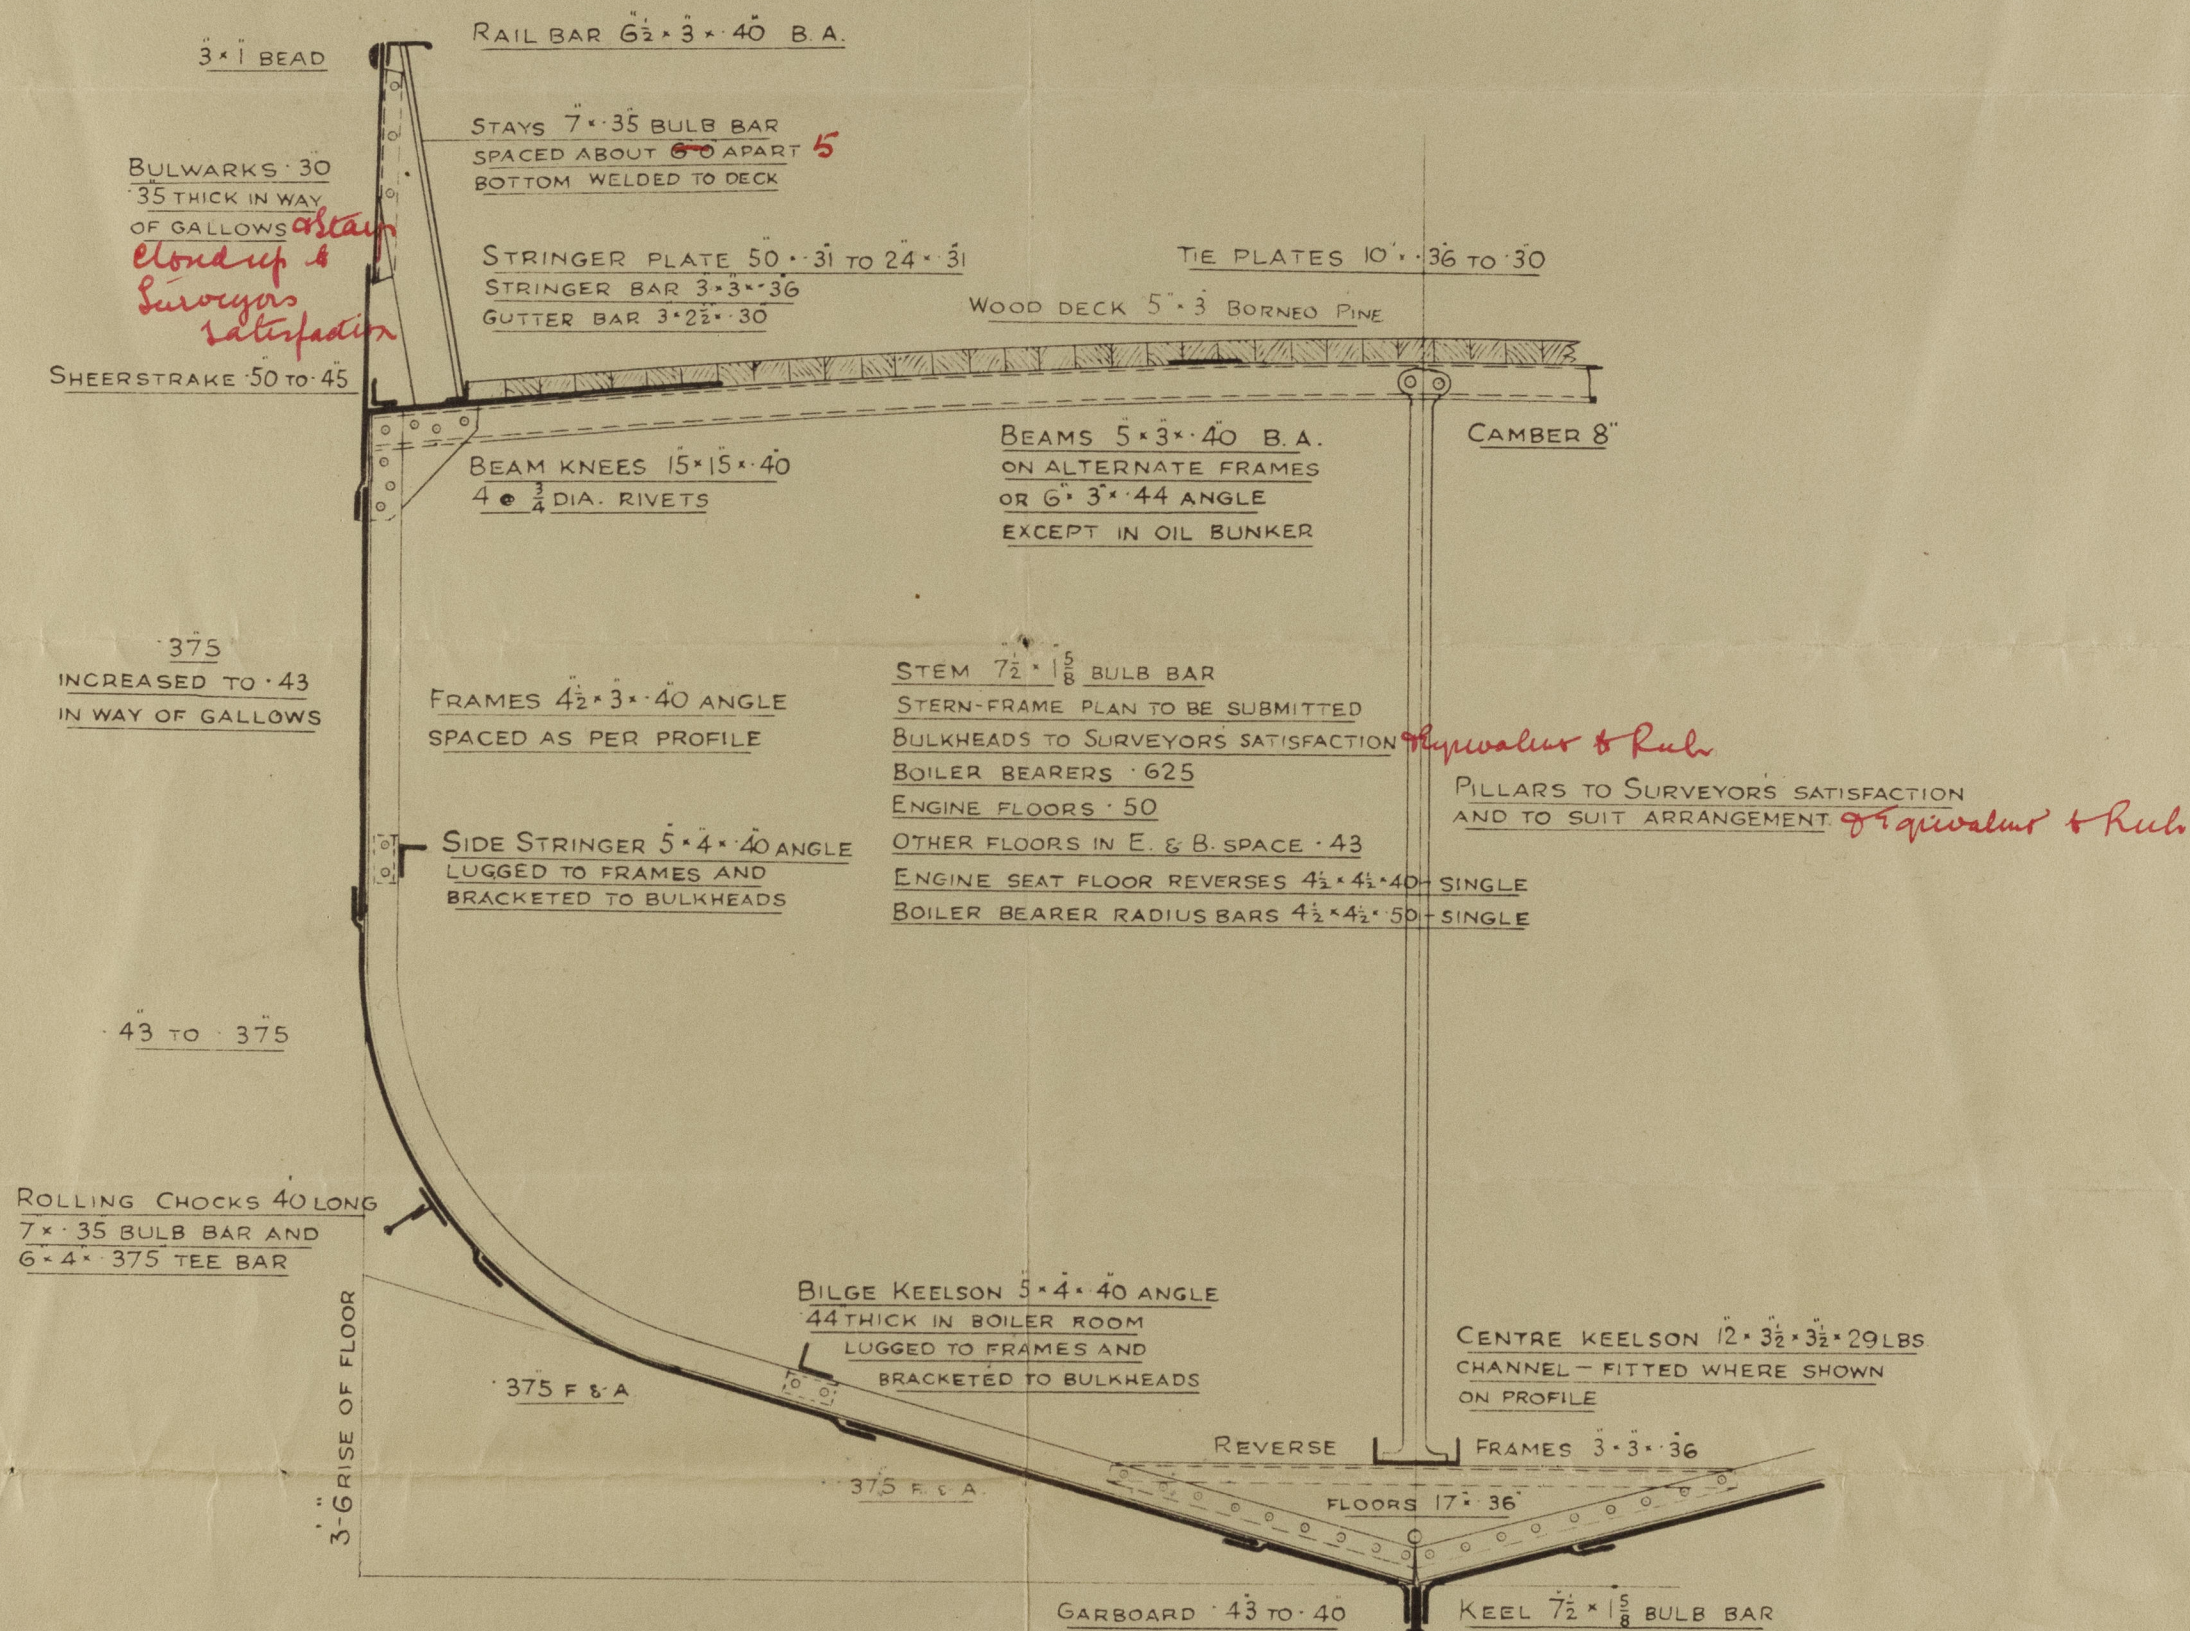



HULL



Messrs. Cochrane & Sons, Ltd.,  
Yard No. 1201.

Midship Section.  
DATE APPROVED 2/1/39.

S.S.	<i>Alita</i>
HULL REPORT No.	<i>50041</i>

S.S.K.	<i>"Gwate"</i>
HULL	<i>50444.</i>

1/3  
w  
b  
s

002923-002928-0097



© 2020

Lloyd's Register  
Foundation