


Lloyd's Register of Shipping.

Ship's Name DENBIGH COAST

Official No. 164312

Memorandum of alterations reported since ship was surveyed for assignment of Load Lines
in JAN., 1937.

1. The only sanitary discharges from crew space below raised quarter deck are 3 wash basin discharges. Each of these is fitted with a single way cock fitted to the ship's side as shewn in the accompanying sketch.

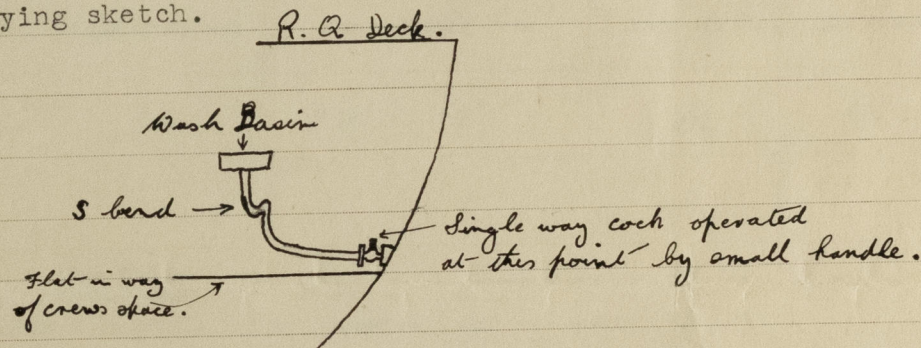

2. The steel skylight shewn on page 4 of the original Rpt. C. 11 has been removed to enable an electric capstan to be fitted in place. (raised quarter deck aft). (Mch., Dec., 1937/Jan., 1938).