

PROFILE & DECK PLAN


STEEL SCREW TRAWLER

Nos 513-514

DIM 5 120'-0" x 21'-6" EX x 12'-6" MLO

SCALE $\frac{1}{4}'' = \text{ONE FOOT.}$

PLAN No. 537
FOR ENCLOSURE TO:
Messrs Lloyds, Surveyors
Hull FROM
DOCHRANE & SONS,
SHIPBUILDERS, SELBY.
DATE August 18th 11 R.R.

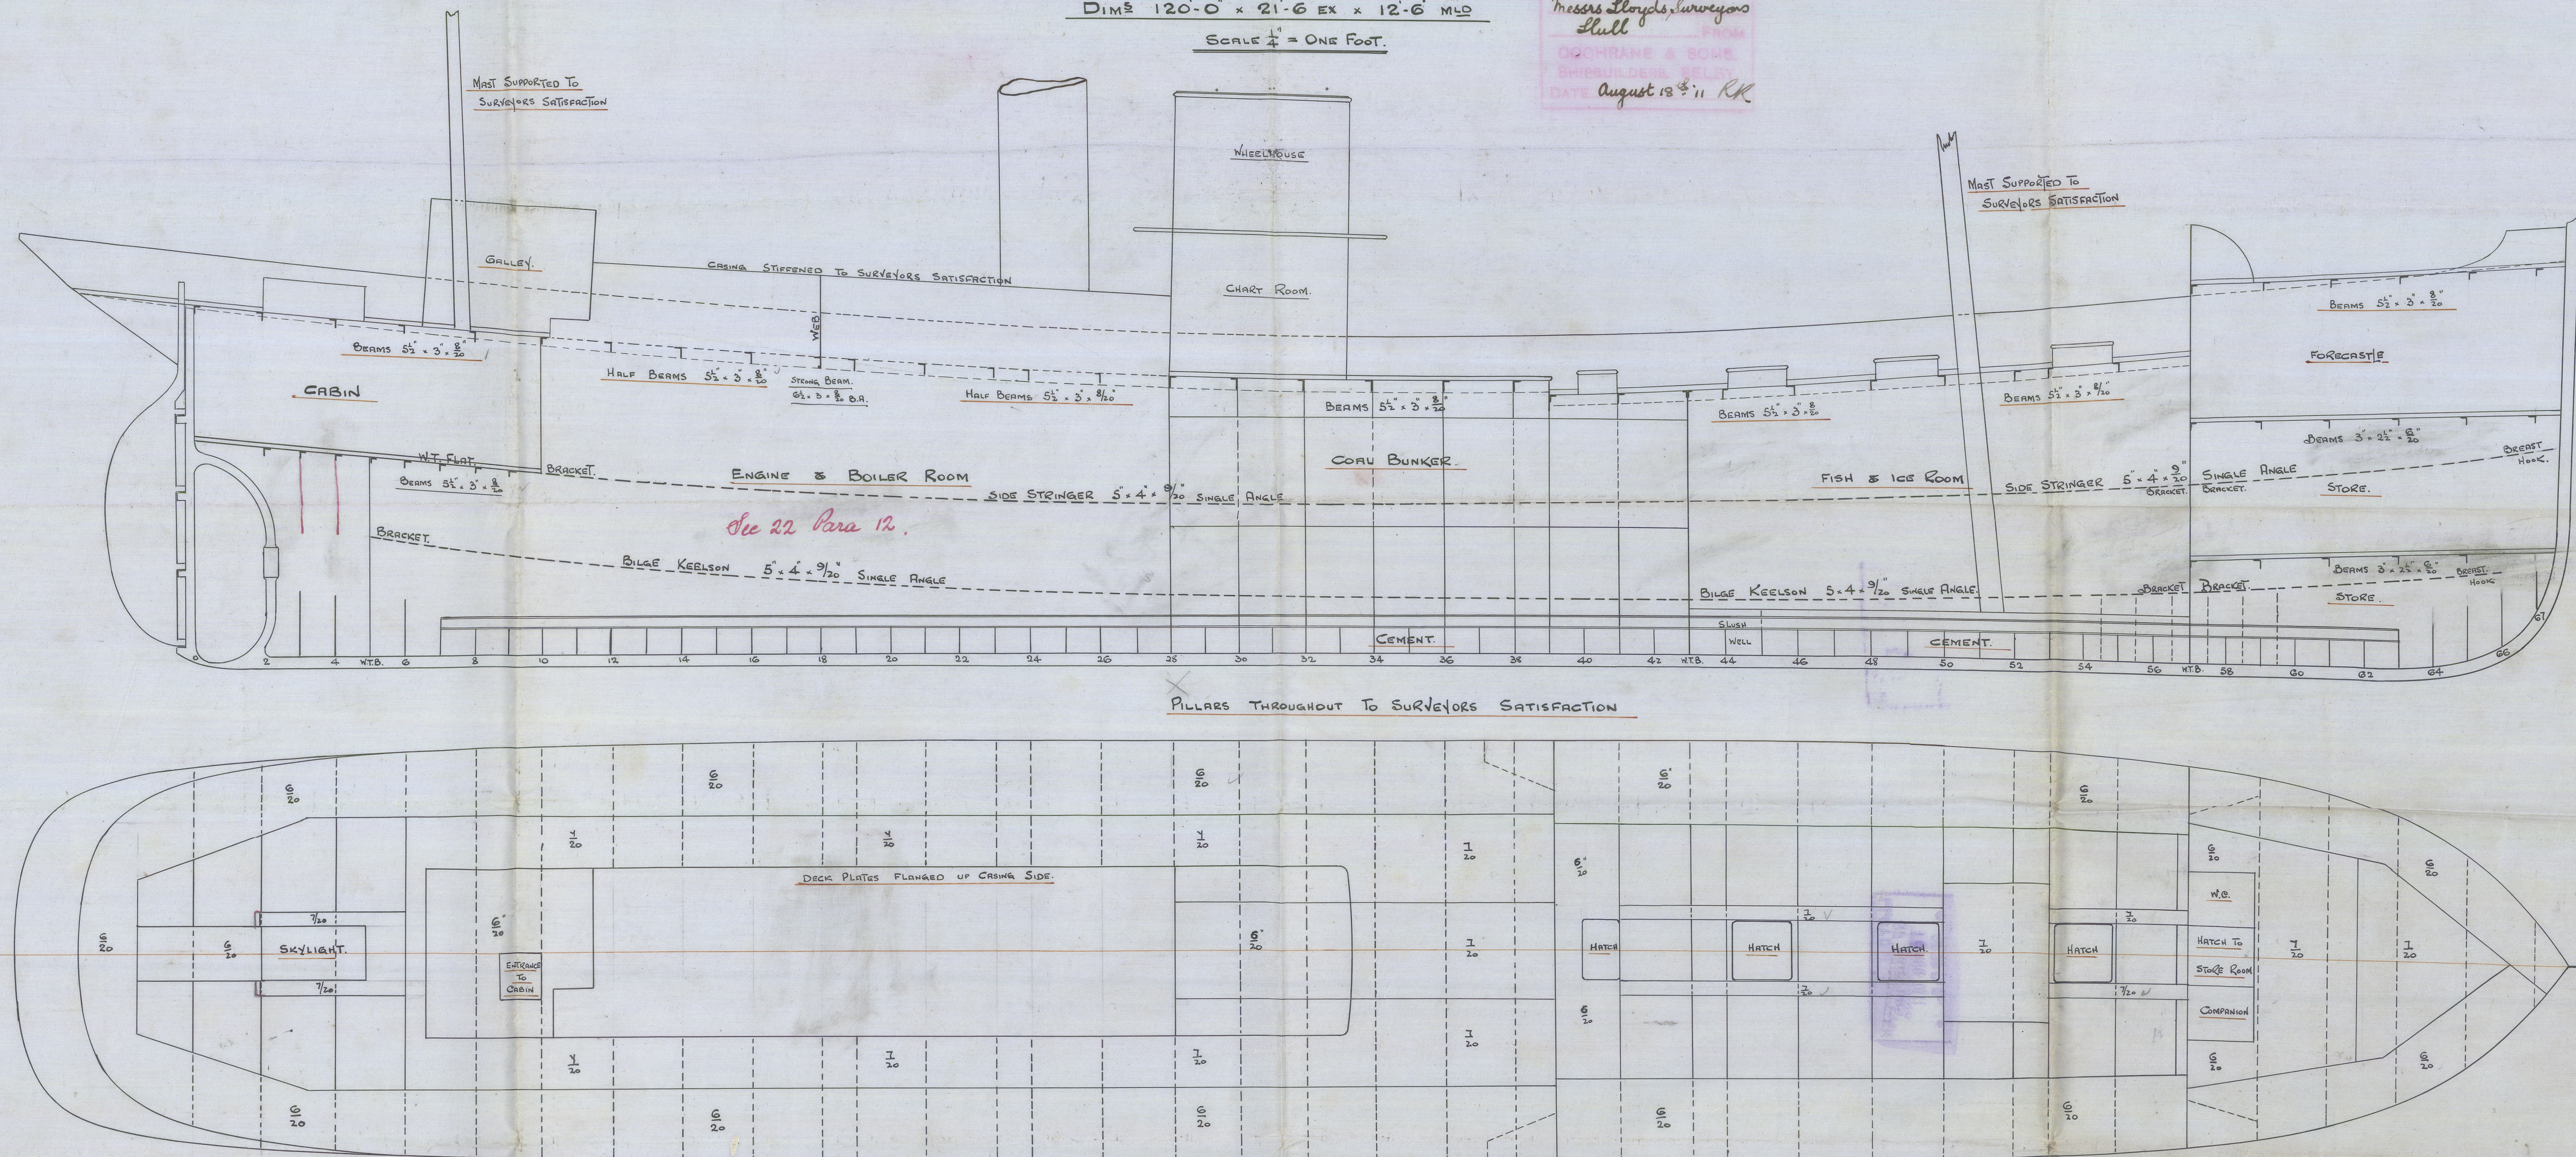

C. J.
23.8.11

1945
 1946
Cochran + Sons

No 513-514.


Profile & Decks.

s/s Alnmouth Hull Rpt No 24691

" Exmouth " " 24989

1000
1000
1000
1000

002929-002937-0091

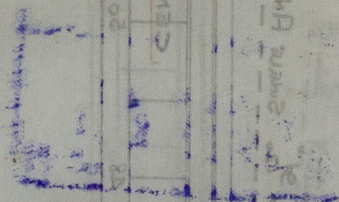

© 2021

Lloyd's Register
Foundation