

23.8.11
2.9.11

MIDSHIP SECTION

STEEL SCREW TRAWLERS


Nos 513-514

DIMS 120'-0" x 21'-6" EX x 12'-6" MLD

SCALE $\frac{1}{2}$ " = ONE FOOT

PLAN No. 596
FOR ENCLOSURE TO
Messrs Lloyds Surveyors
Hull FROM
COCHRANE & SONS
SHIPBUILDERS, SELBY
DATE August 18th 11 Rk

TO CLASS 100.A.1. FOR FISHING PURPOSES. DECK PLATED OVER
IN WAY OF MACHINERY SPACE. ENGINE & BOILER CASING
AS PREVIOUSLY APPROVED

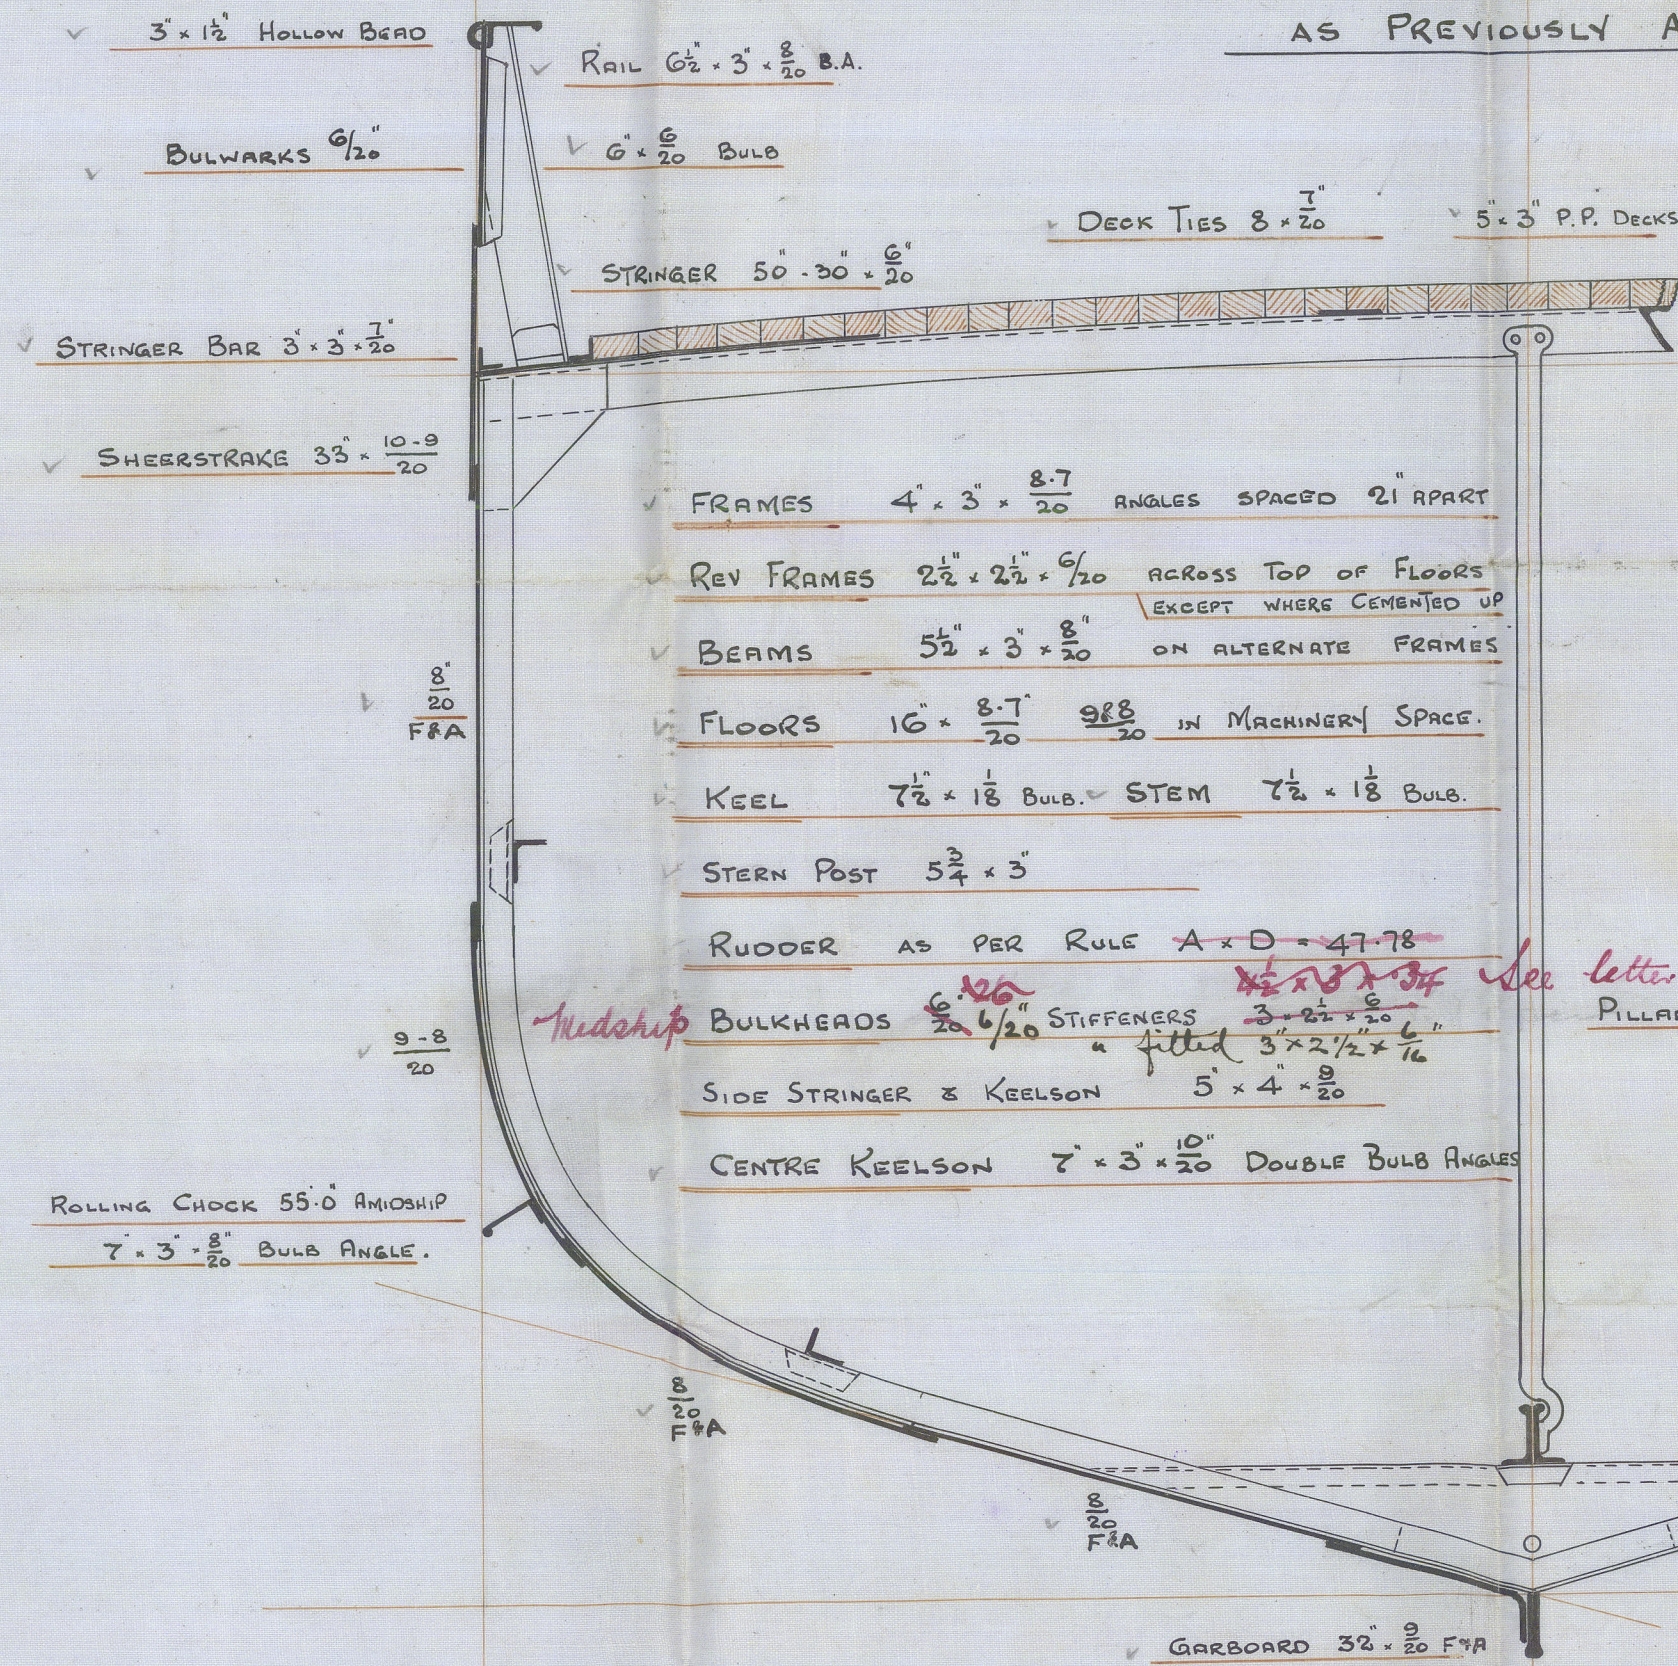

NUMERALS

$$B + D = 33.86$$

$$L \times (B + D) = 4062$$

PROPORTIONS

$$\frac{B}{D} = 9.6$$

$$\frac{B}{L} = 5.62$$

EQUIPMENT

- 1st BOWER ANCHOR $5\frac{1}{4}$ EX STOCK
- 2nd " " $4\frac{3}{4}$ " "
- KEEDGE ANCHOR $2\frac{1}{2}$ " "
- 90 FATHOMS 1" CABLE
- 60 " 6" HANSEK
- 60 " $4\frac{1}{2}$ WARP

RIVETING

- BUTTS OF SHELL PLATING LAPPED & DOUBLE RIVETED
- EXCEPT GARBOARD & SHEERSTRAKE WHICH ARE TO BE STRAPPED
- & DOUBLE RIVETED. LANDING EDGES DOUBLE RIVETED EXCEPT
- TOP EDGE OF SHEERSTRAKE WHICH IS TO BE SINGLE RIVETED.
- BUTTS OF STRINGER & TIE PLATES LAPPED & DOUBLE RIVETED.

C.F.
23.8.11

Stromm Angle
1p 242 at 1st 11/11

instead of
No 213-214
Cochrane & Sons

Cochran & Sons

№ 513 - 514

Midships Section -

1/2 Exmouth Hill Rd. 24989

S/S Almonorth
Stull Rd no 24691


002929-002937-0002

Lloyd's Register
Foundation