
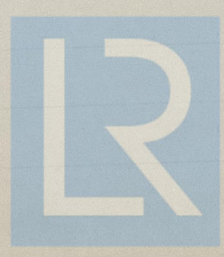


304.84
180.0
124.84
1.0
12.48
6.24

002929-002937-0124

ON FOR IRON
hs length cov

S.S. Julieta
Dimensions of Trunk.

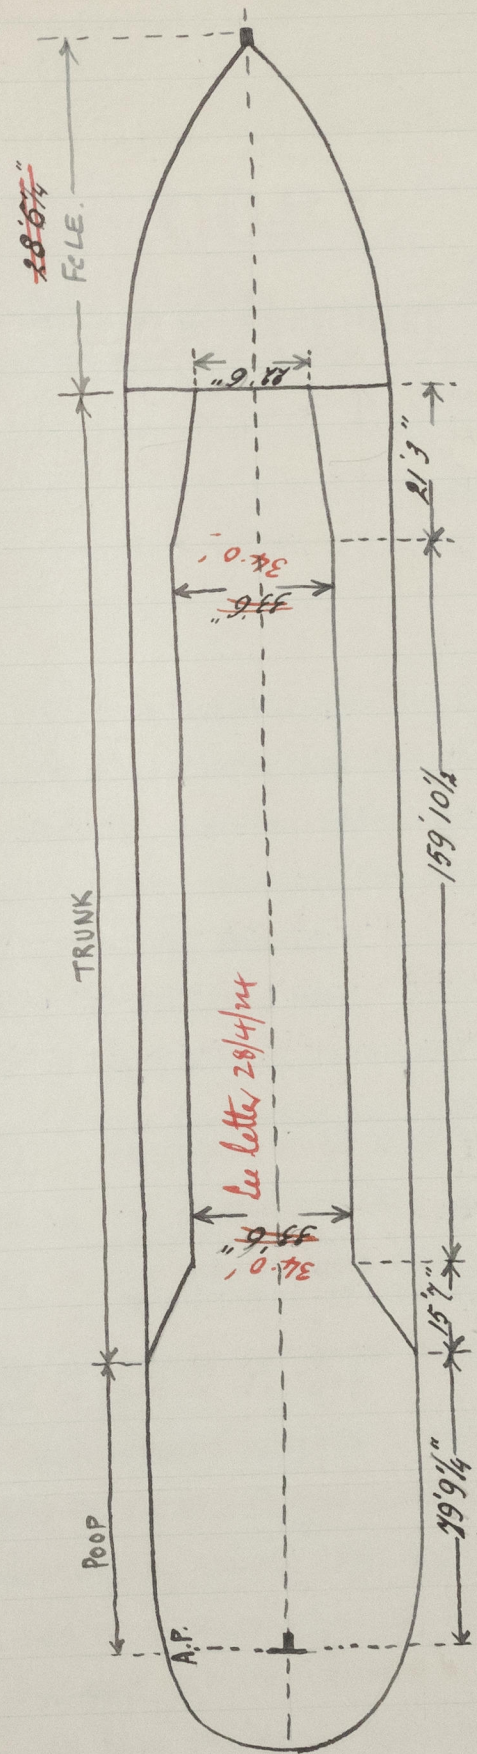

© 2021

Lloyd's Register
Foundation