


5/2/29


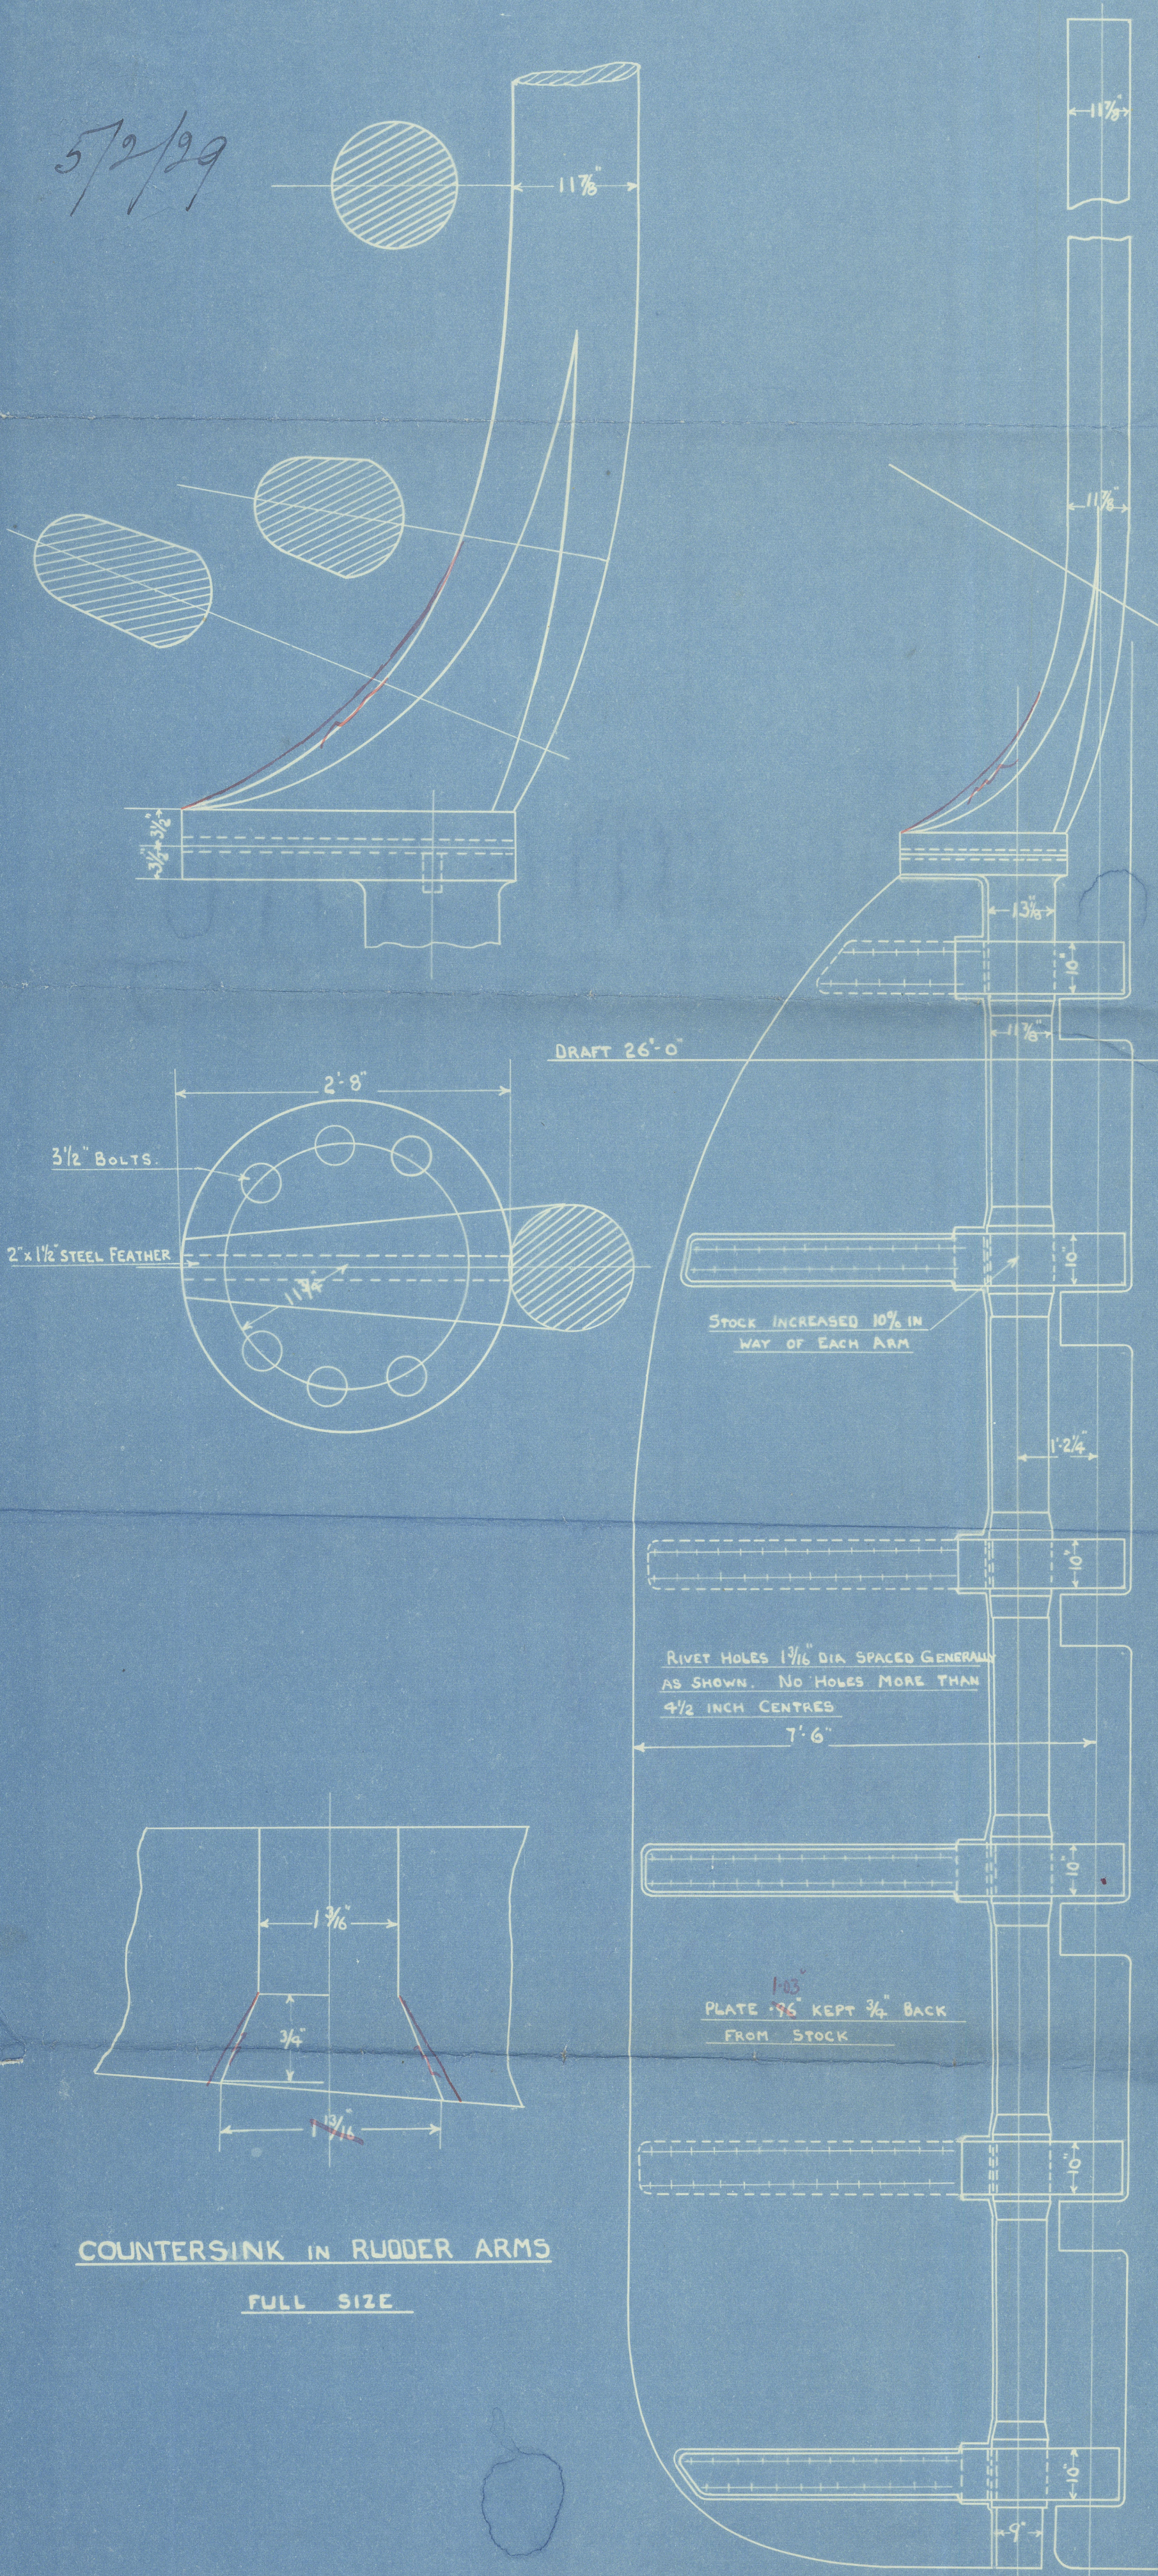


N^{os} 510-511-512 & 513 PROPOSED PLAN of RUDDER

SCALE 1/2" = 1 FOOT

FORGED STEEL OR FORGED IRON
TO LLOYDS APPROVAL

LENGTH OF VESSEL 425'-0"
SPEED 13 1/2 KNOTS
RUDDER AREA 164 SQ FT
CENTRE OF GRAVITY ABAFT
CENTRE OF PINS 3'-89"
A x B 638

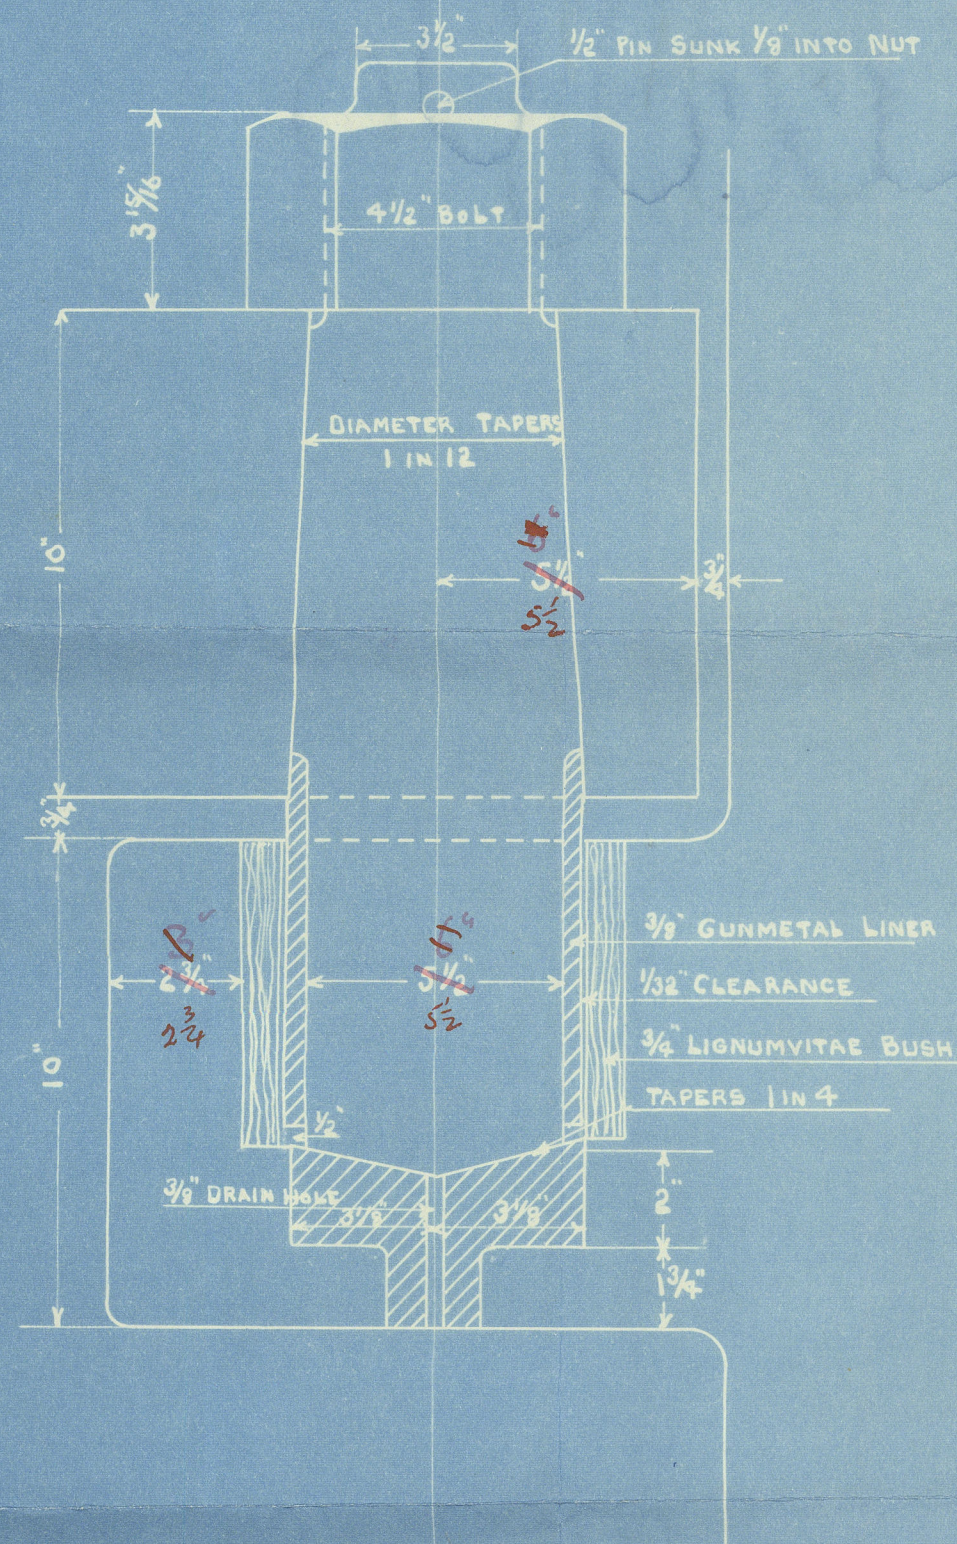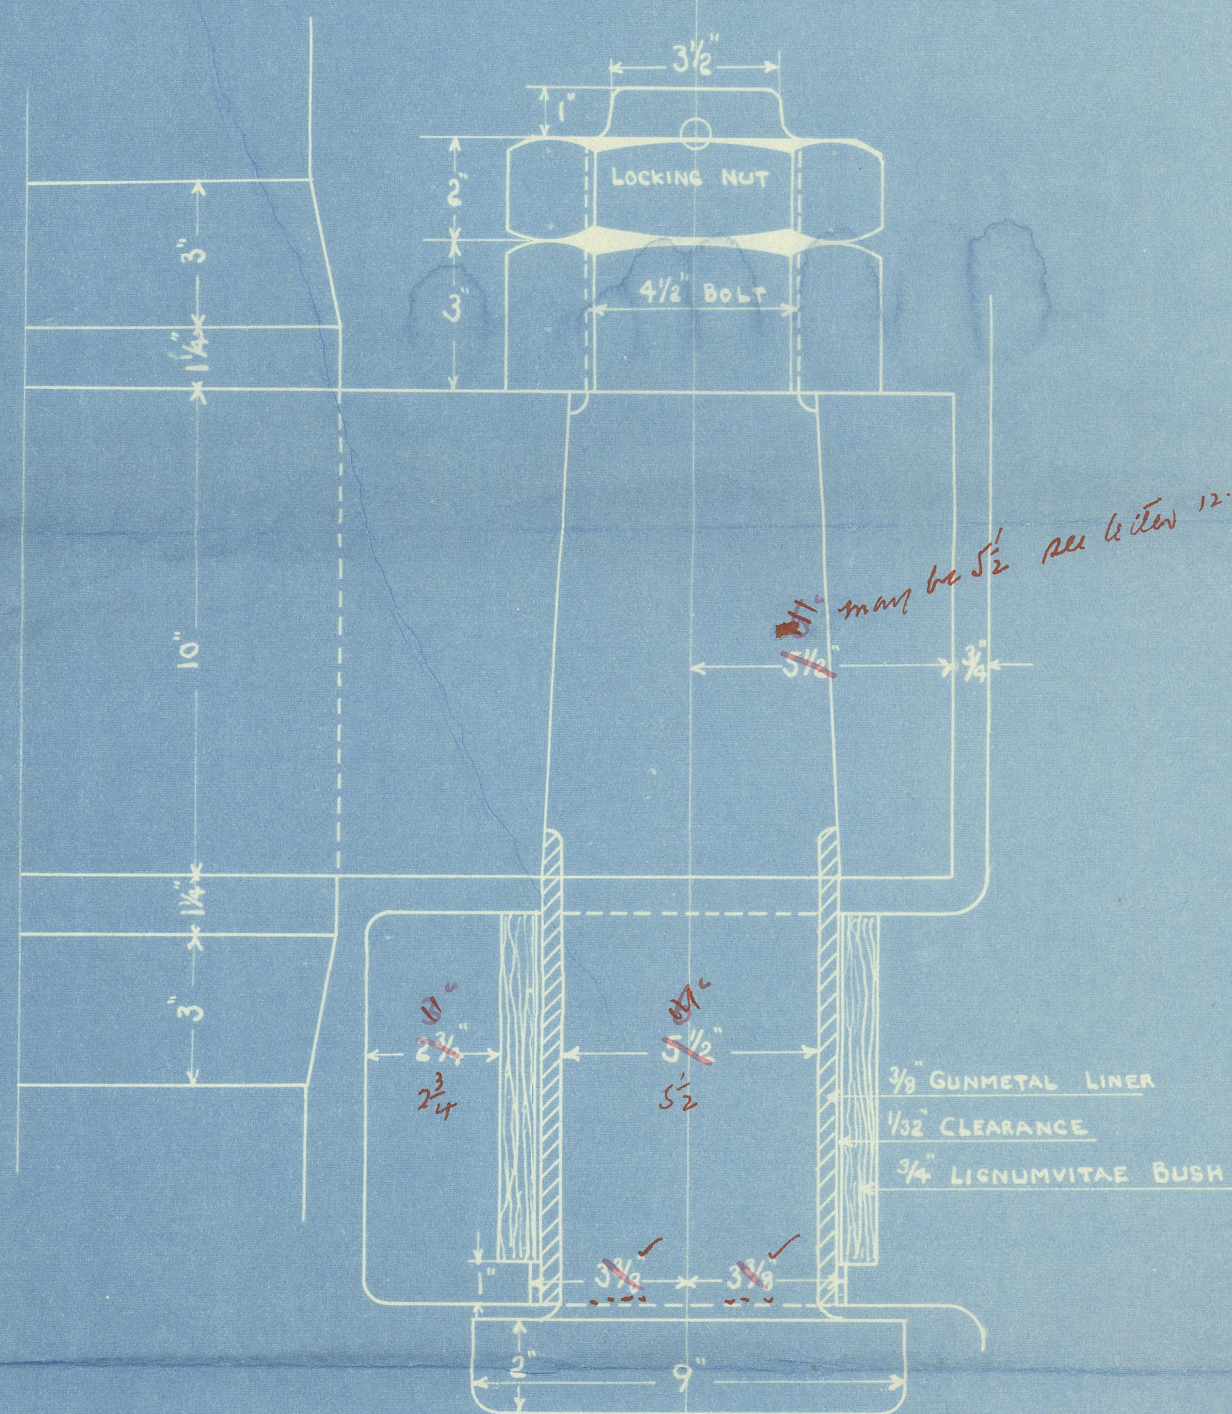

W.J.
5.2.29



002936-002946-0053

W 6th

510/13

Reeder

(2)

s.o. "Irishbank"*

s.o. "Lozicbank"

s.o. "Gaybank"

s.o. "Tweedbank"



© 2020

Lloyd's Register
Foundation

000938-000946-0053