



24.2.15

PLAN No. 5299
FOR ENCLOSURE TO
Messrs. Lloyd's
Hull FROM
J. & SONS, LTD.
SHIPBUILDERS, SELBY.
DATE 16/2/15

- MIDSHIP SECTION -

- STEEL SCREW TRAWLERS -

- NOS 645-6 -


131' 8" B.P. x 24' 0" EX. x 13' 6" MLD.

TO CLASS 100. A.I. STEAM TRAWLER

DECK PLATED OVER IN WAY OF MACHINERY SPACE

ENGINE AND BOILER CASING AS PREVIOUSLY APP^d

SCALE 1/2" = 1 FOOT.

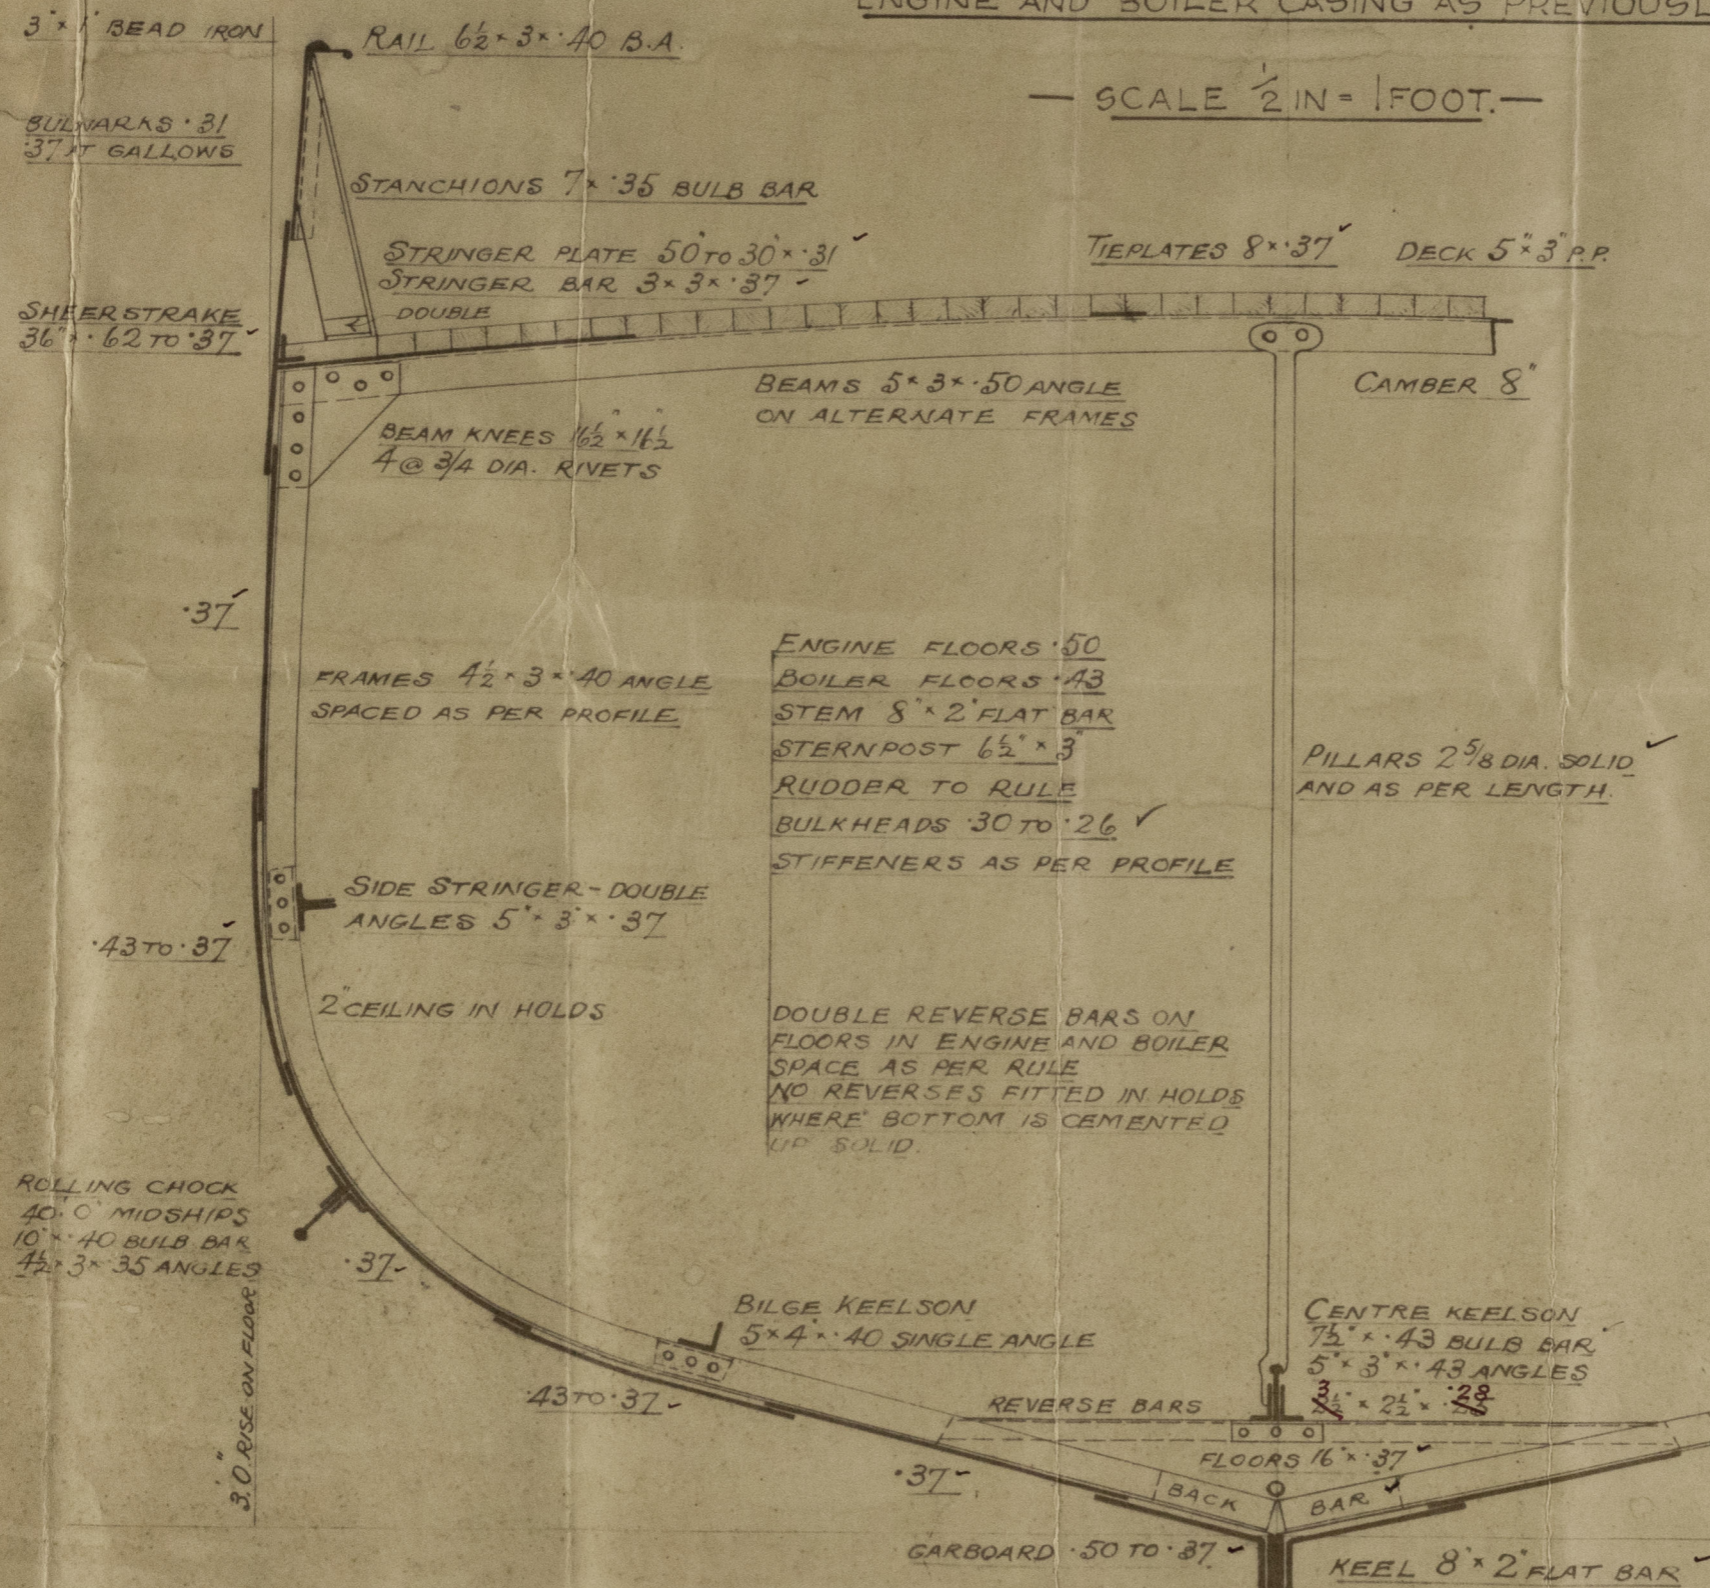

NUMERALS

B + D ----- 37.37 ✓
L x (B + D) ----- 4920.13 ✓

PROPORTIONS

1/B ----- 5.51 ✓
1/D ----- 9.75 ✓

EQUIPMENT

1ST BOWER 6 CWTs. EX STOCK OR 7 1/2 CWTs. STOCKLESS ✓
2ND " 5 1/2 " " " 7 " " ✓
KEDGE 3 CWTs EX STOCK ✓
120 FMS 1 1/16 DIA. STUD LINK CABLE ✓
60 " 6" HAWSER ✓
60 " 5" WARP ✓

RIVETTING


ALL LANDINGS DOUBLE RIVETTED, EXCEPT TOP EDGE OF SHEER STRAKE WHICH IS SINGLE SHELL BUTTS LAPPED AND DOUBLE RIVETTED EXCEPT GARBOARD AND SHEER STRAKE, WHICH ARE STRAPPED
RIVETS IN KEEL, STEM & STERNFRAME 1" DIA.
SHELL RIVETS 3/4" DIA. ✓

Cf.
24.2.15



© 2020

Lloyd's Register
002438-00946-097
Foundation

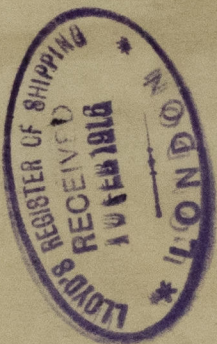

Cochranes 645/6

Plan of Midship
Section



S.S. Night Hawk *
Hall Ppt No. 29123.
S.S. Donna Nook
Hall Ppt No. 29158.



© 2020

Lloyd's Register
Foundation

002938-002946-0247