
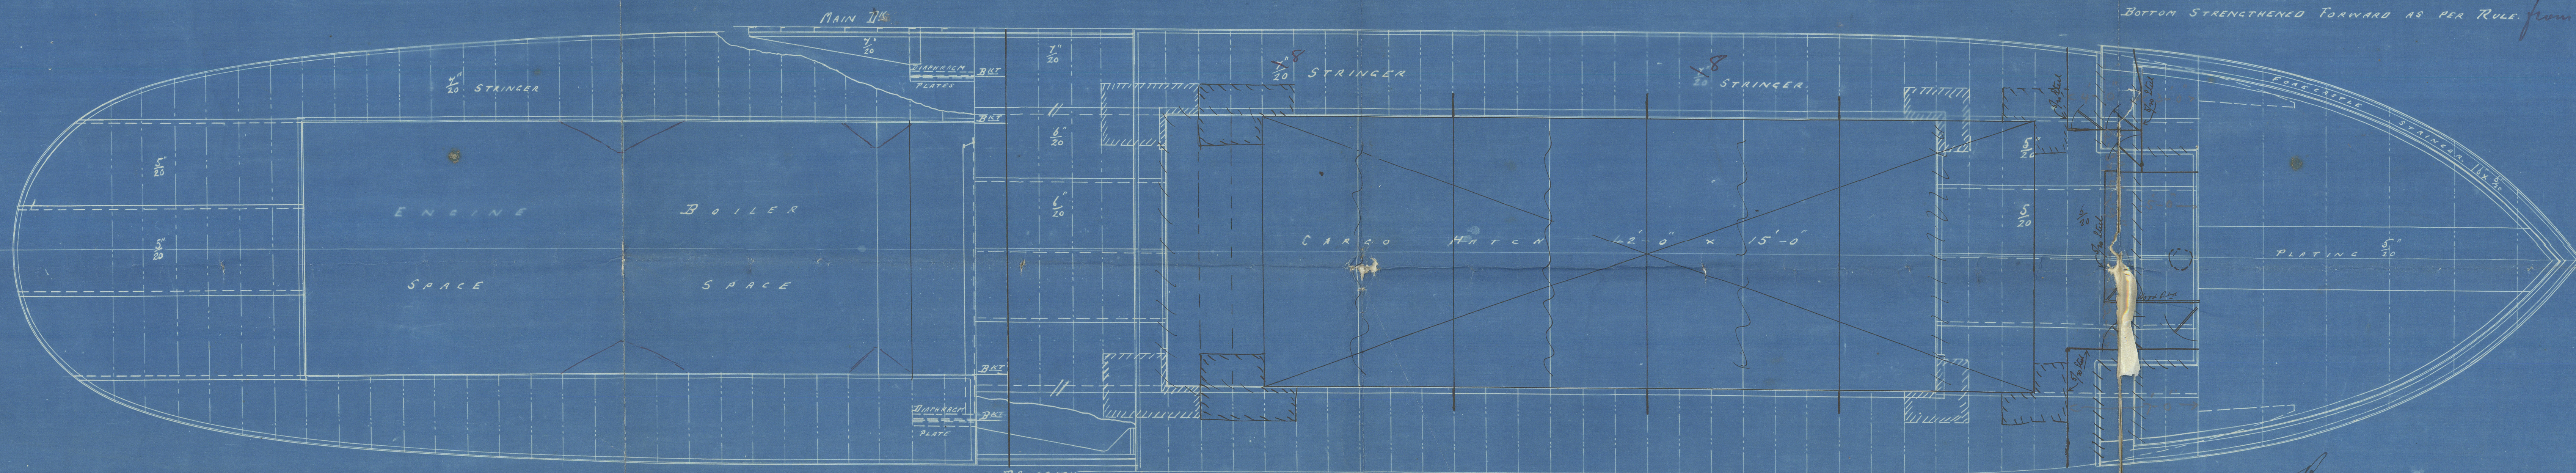
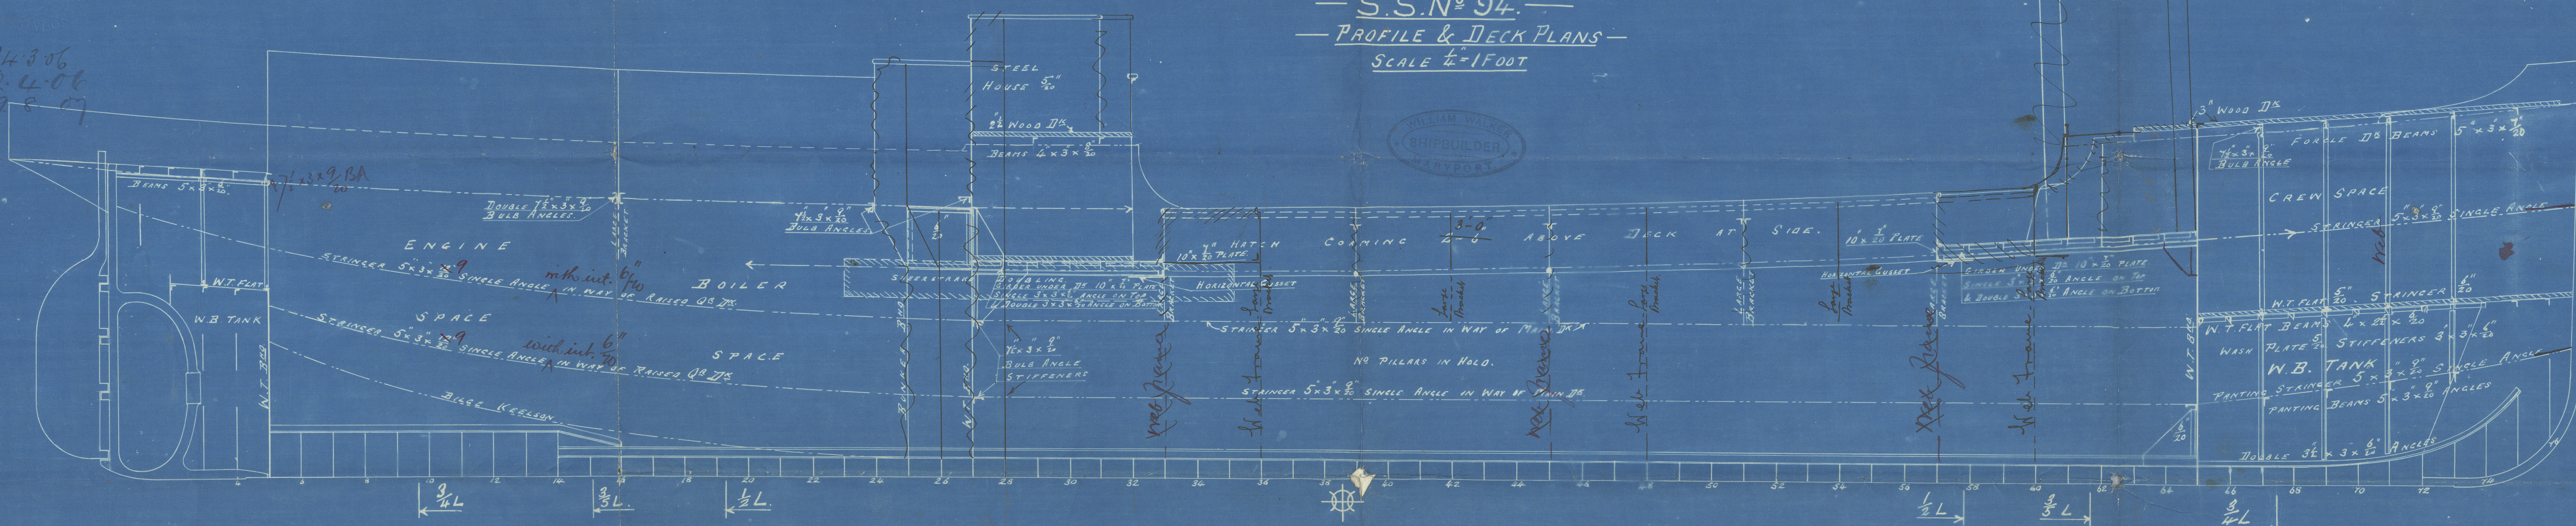


24.3.06  
2.4.06  
19.8.07

DIMENSIONS  
LENGTH B.P. 135'-0"  
BREADTH MLD 25'-0"  
DEPTH " 11'-5"

S.S. No 94.  
PROFILE & DECK PLANS  
SCALE 1/4" = 1 FOOT

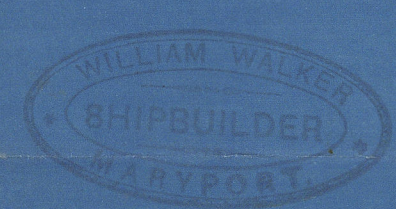

BOTTOM STRENGTHENED FORWARD AS PER RULE. FROM 3/5 L TO 1/2 L AT AFT STEMS.

C.B.  
24.3.06



S. S. No. 94.

Profile and Deck Plan

Bow Port 1496

S S "Endcliffe"



© 2020

Lloyd's Register  
Foundation

007938-002946-0313