



EQUIPMENT

2 BOWER ANCHORS $8\frac{1}{2}$ CWTs EACH STOCKLESS
1 STREAM " $2\frac{3}{4}$ " " EX-STOCK
1 KEDGE " 1 " " "
24 105 FMS. $\frac{1}{8}$ " STUDD-CHAIN CABLE
2 445 24" STEEL WIRE-FOR STREAM CHAIN
19 875 22 " " TOWLINE
90 2 " " " HAWSER

S.S. No 94

MIDSHIP SECTION

SCALE $\frac{1}{2}$ " = 1 FOOT.

TO CLASS 100 A.1.

PRINCIPAL DIMENSIONS

LENGTH B.P. 135'-0"

BREADTH MOULDED 25'-0"

DEPTH MOULDED 11'-5"

HALF BREADTH 12'5"

WHOLE DEPTH 11'937"

HALF GIRTH 22'32"

1ST NO. 46'75"


2ND NO. 13'40"

3RD NO. 62'64'5"

4TH NO. 703'57'41"

EQUIVALENT NO. 69'68'0"

$\frac{L}{D} = 11'24$ $\frac{L}{B} = 5'36$

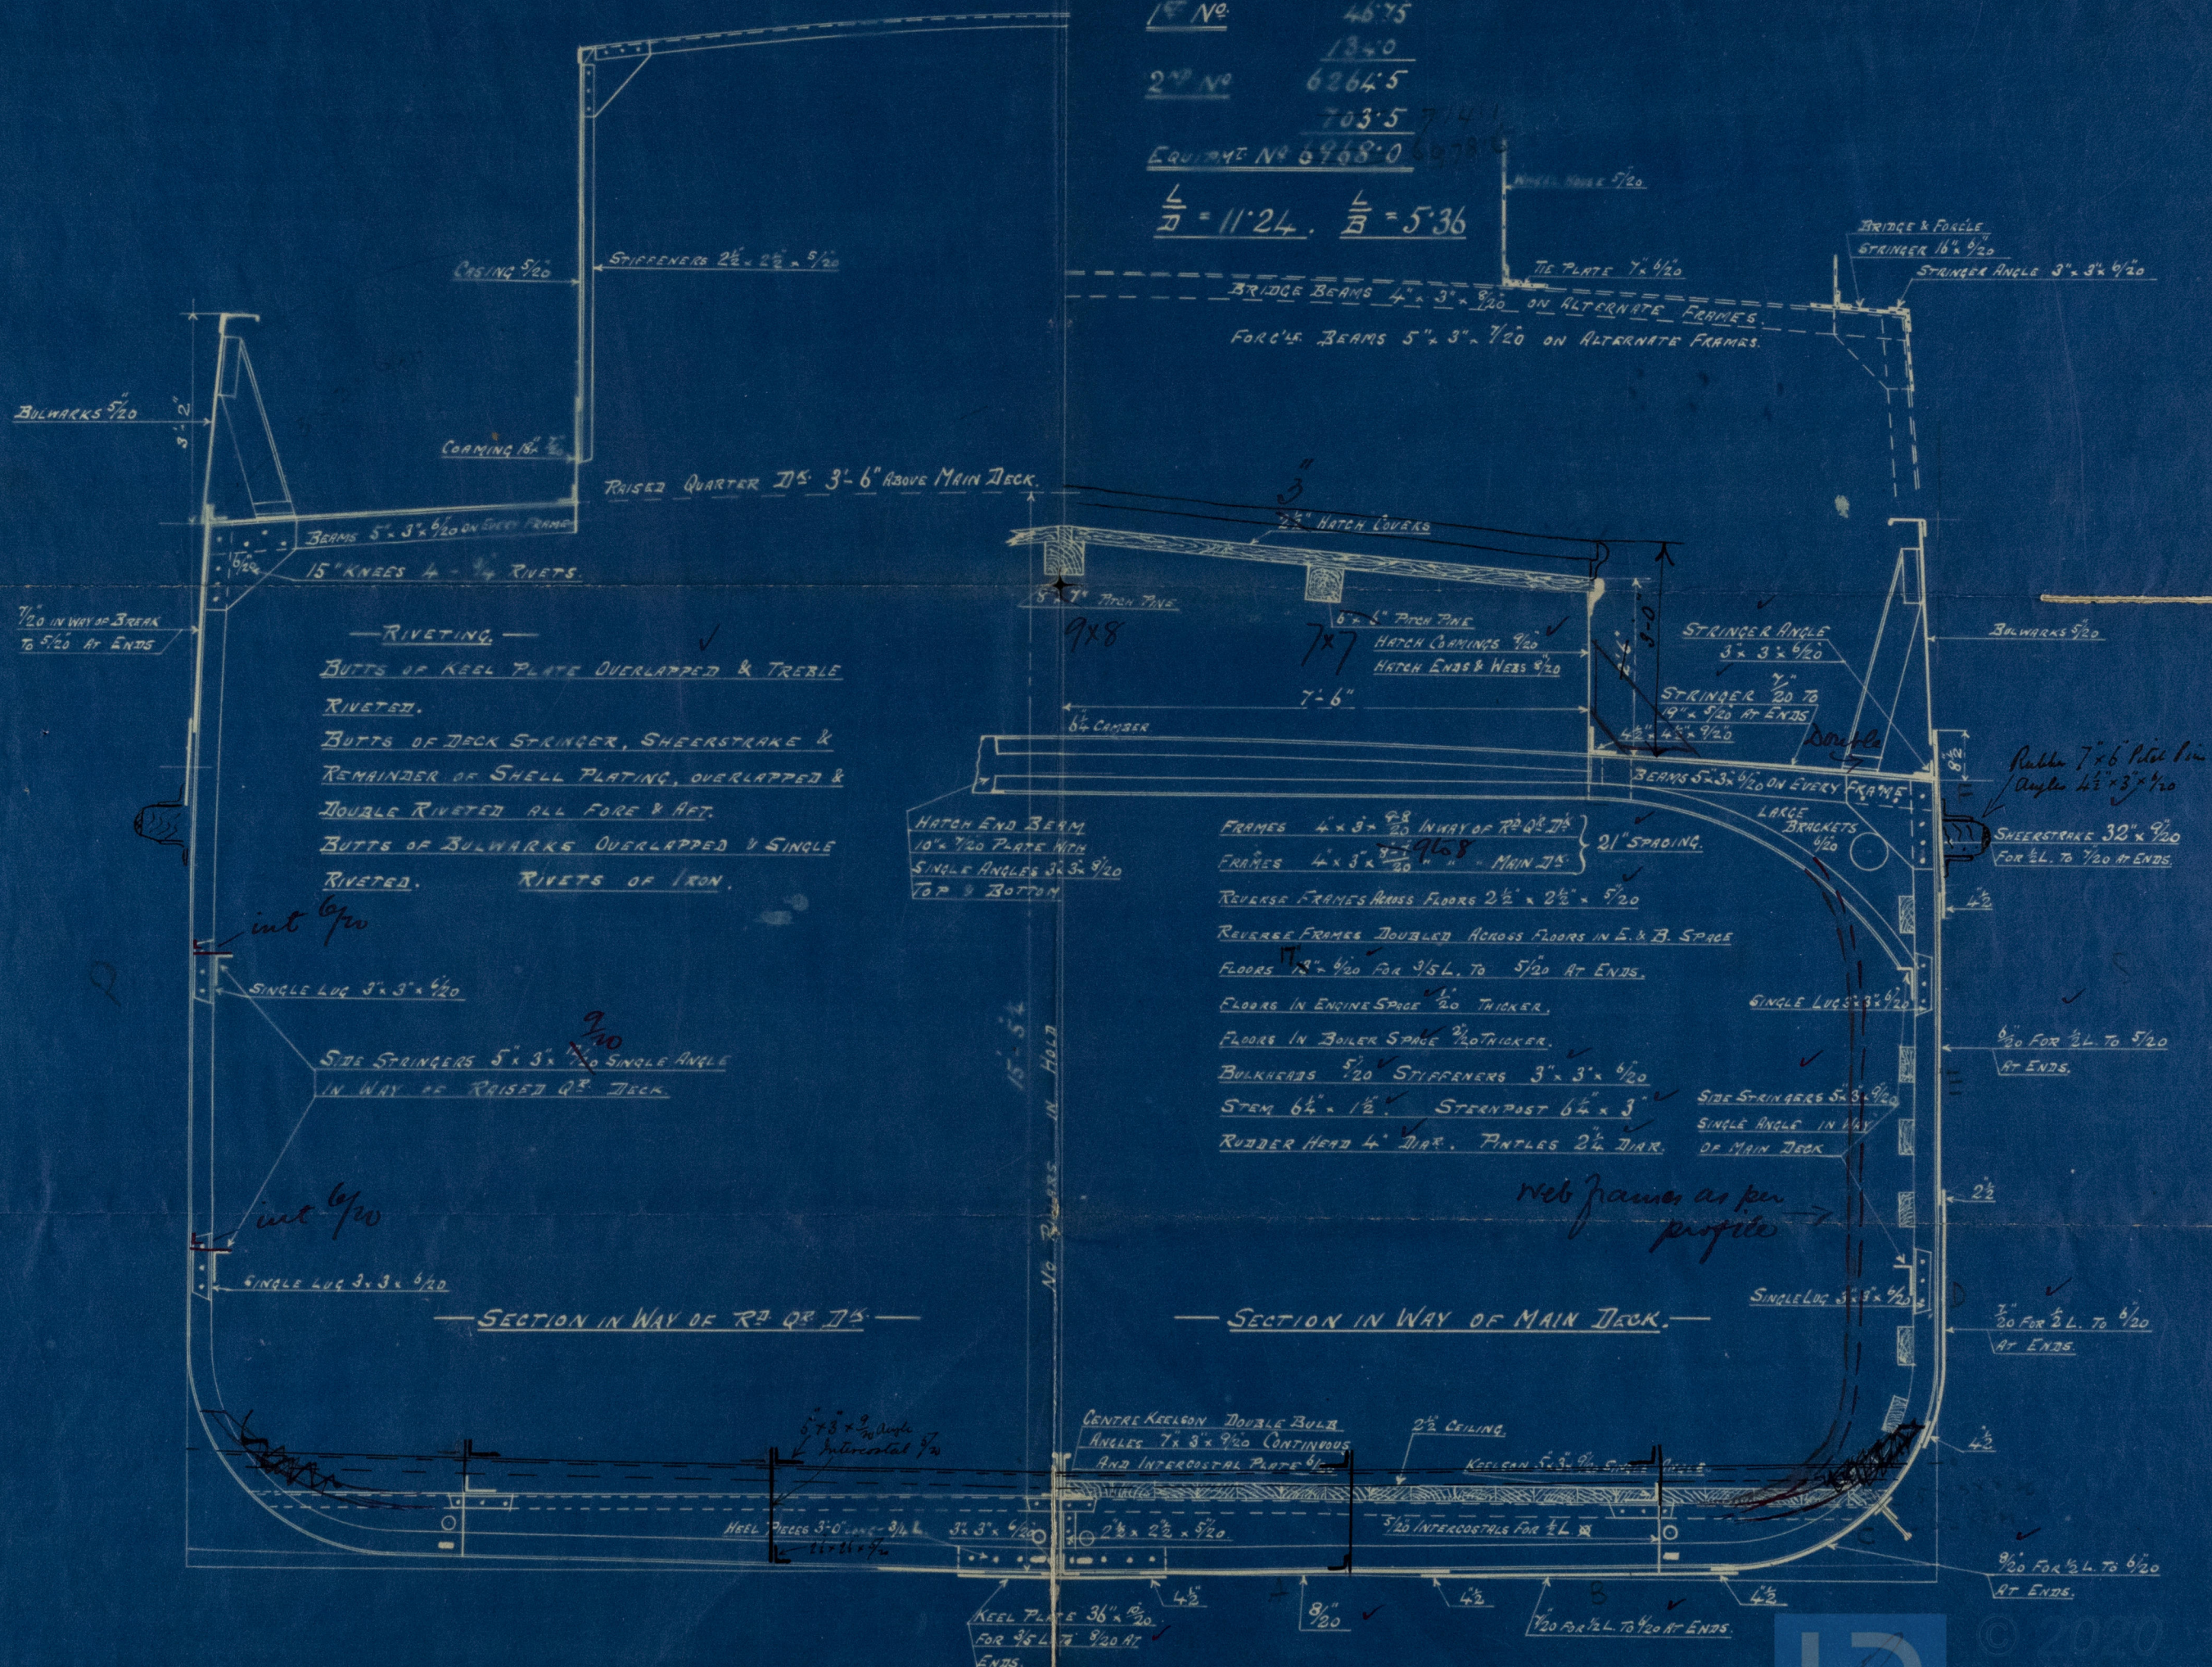





W. Walker.

S. S. No. 94

Midship Section

Nov. Rpt No. 1496

SS ENDCLIFFE

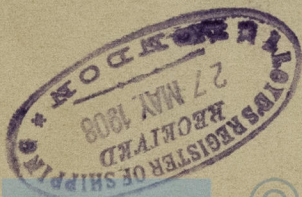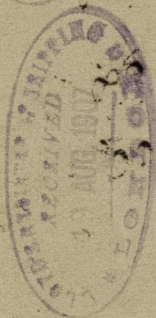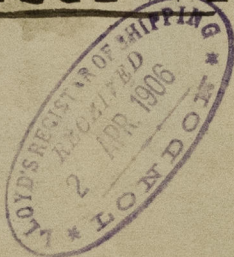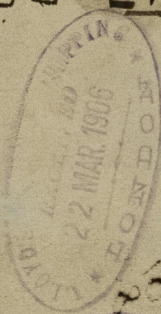

© 2020

Lloyd's Register
Foundation

002938-002946-0344