


— N^o 639 —

DIMENSIONS 135.0 BP x 23.6" EXT x 13.1" MLD
— SCALE 1/4" INCH —


PLAN No. 5045
FOR ENCLOSURE TO
MESSRS LLOYDS SURVEYORS
HULL. FROM
COCHRANE & SONS, LTD.
SHIPBUILDERS, SELBY.
DATE 10/12/14

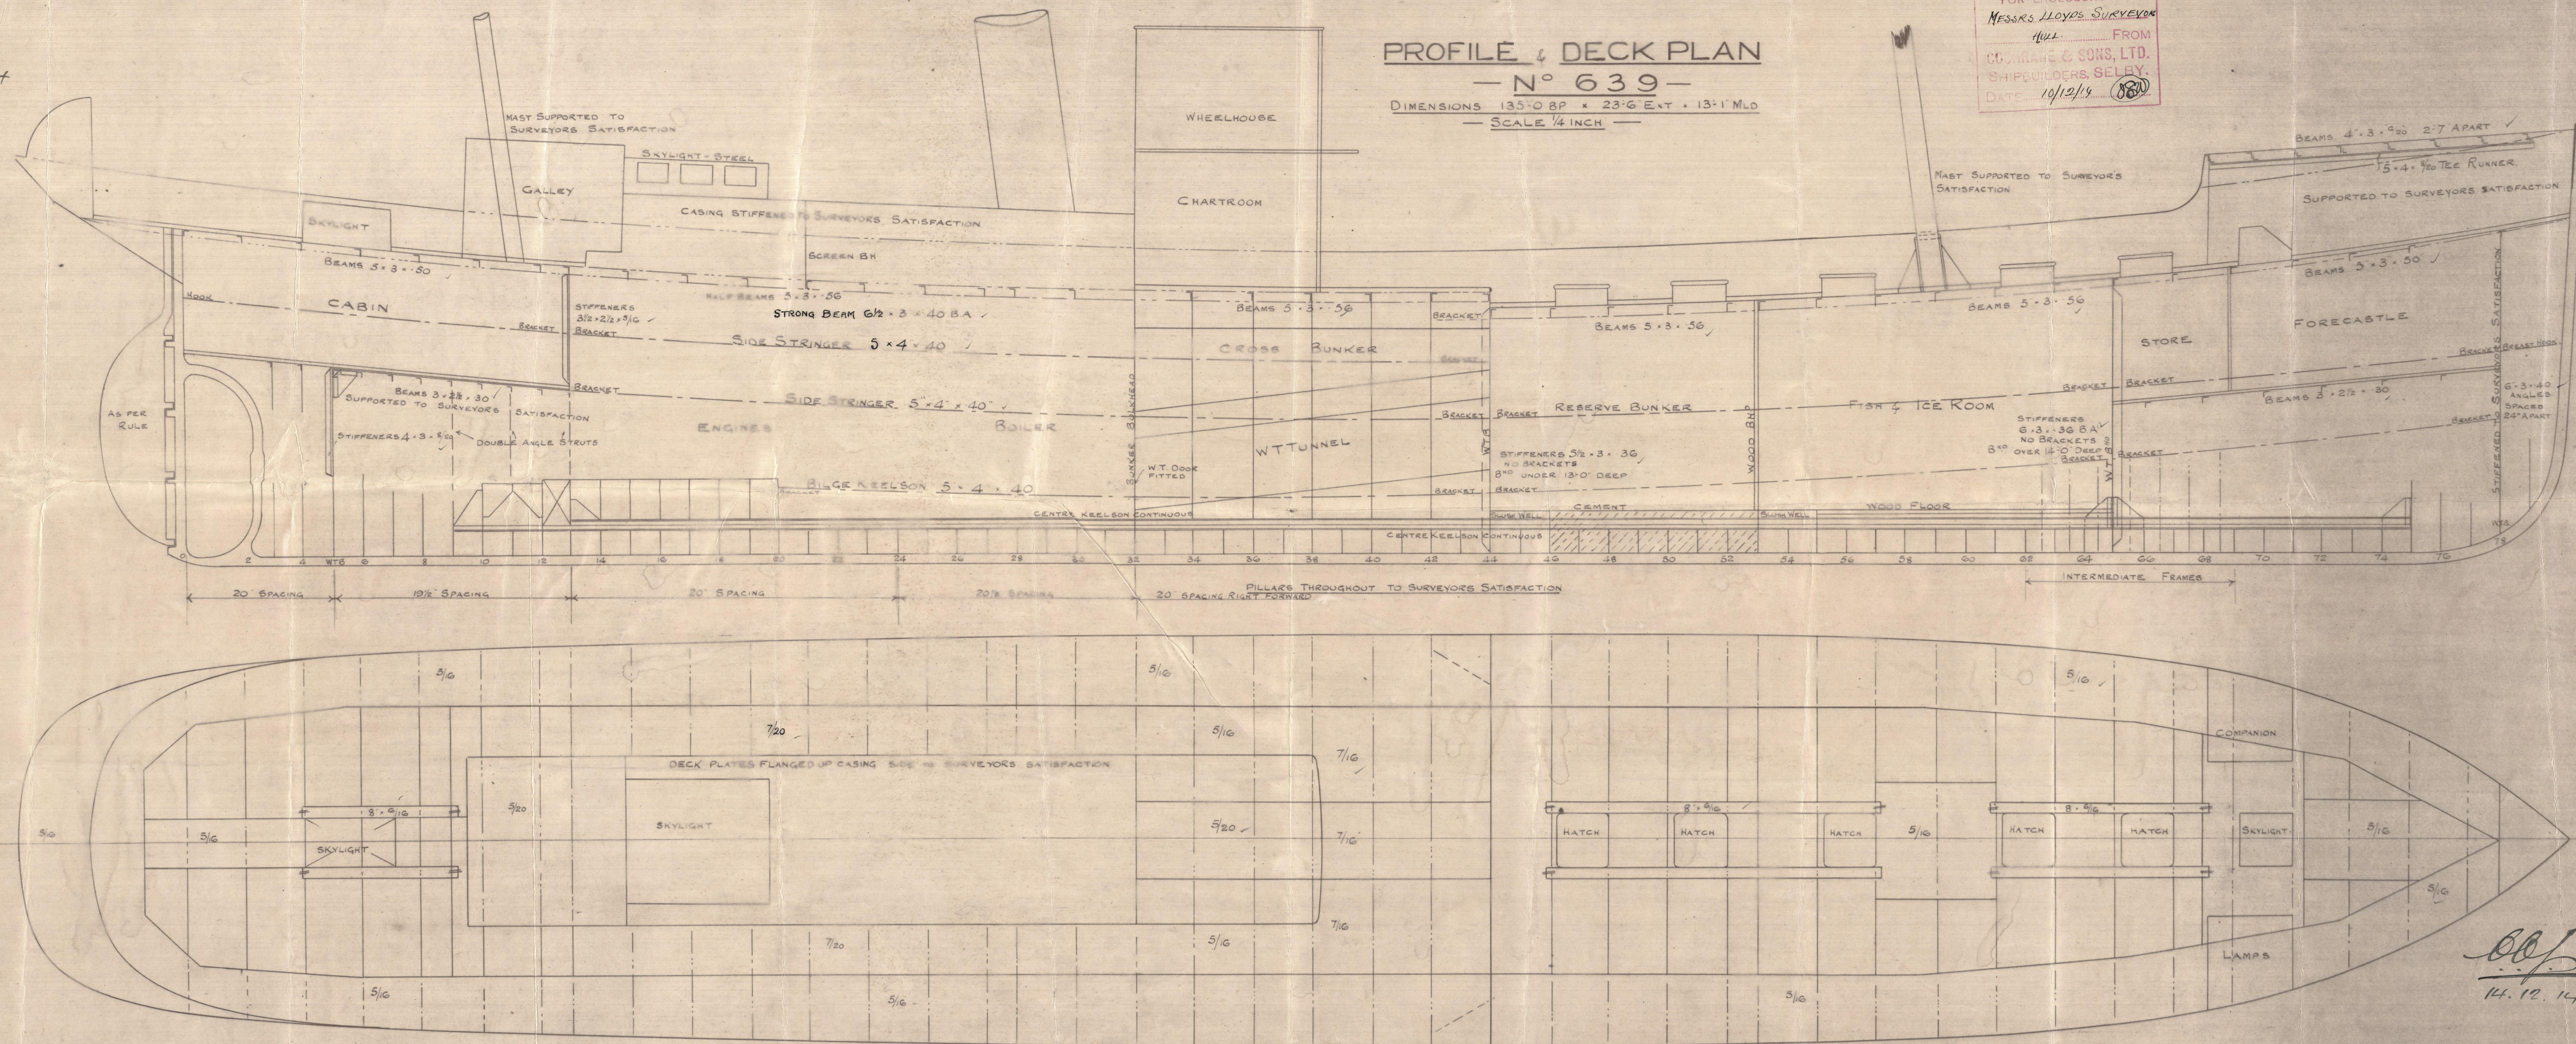

14. 12. 14.

Cochrane's no 39

Profile and Deck.

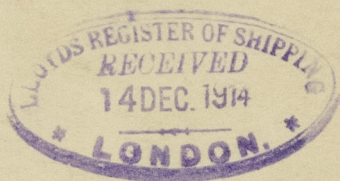

S. S. Tribune Hull Rpt. No. 28864



© 2020

Lloyd's Register
Foundation

002947-002955-0001