

14.12.14

MIDSHIP SECTION

STEEL SCREW TRAWLER

— No 639 —


135.0. B.P. x 23.6. EX. x 13.1. MOULDED

1/2" SCALE

TO CLASS 100.A.1.

DECK PLATED OVER IN WAY OF MACHINERY
ENGINE AND BOILER CASING AS PREVIOUSLY APPROVED

PLAN No. 5044.
FOR ENCLOSURE TO
MESSRS LLOYDS SURVEYOR
HULL. FROM
COCHRANE & SONS, LTD.
SHIPBUILDERS, SELBY.
DATE 10/12/14

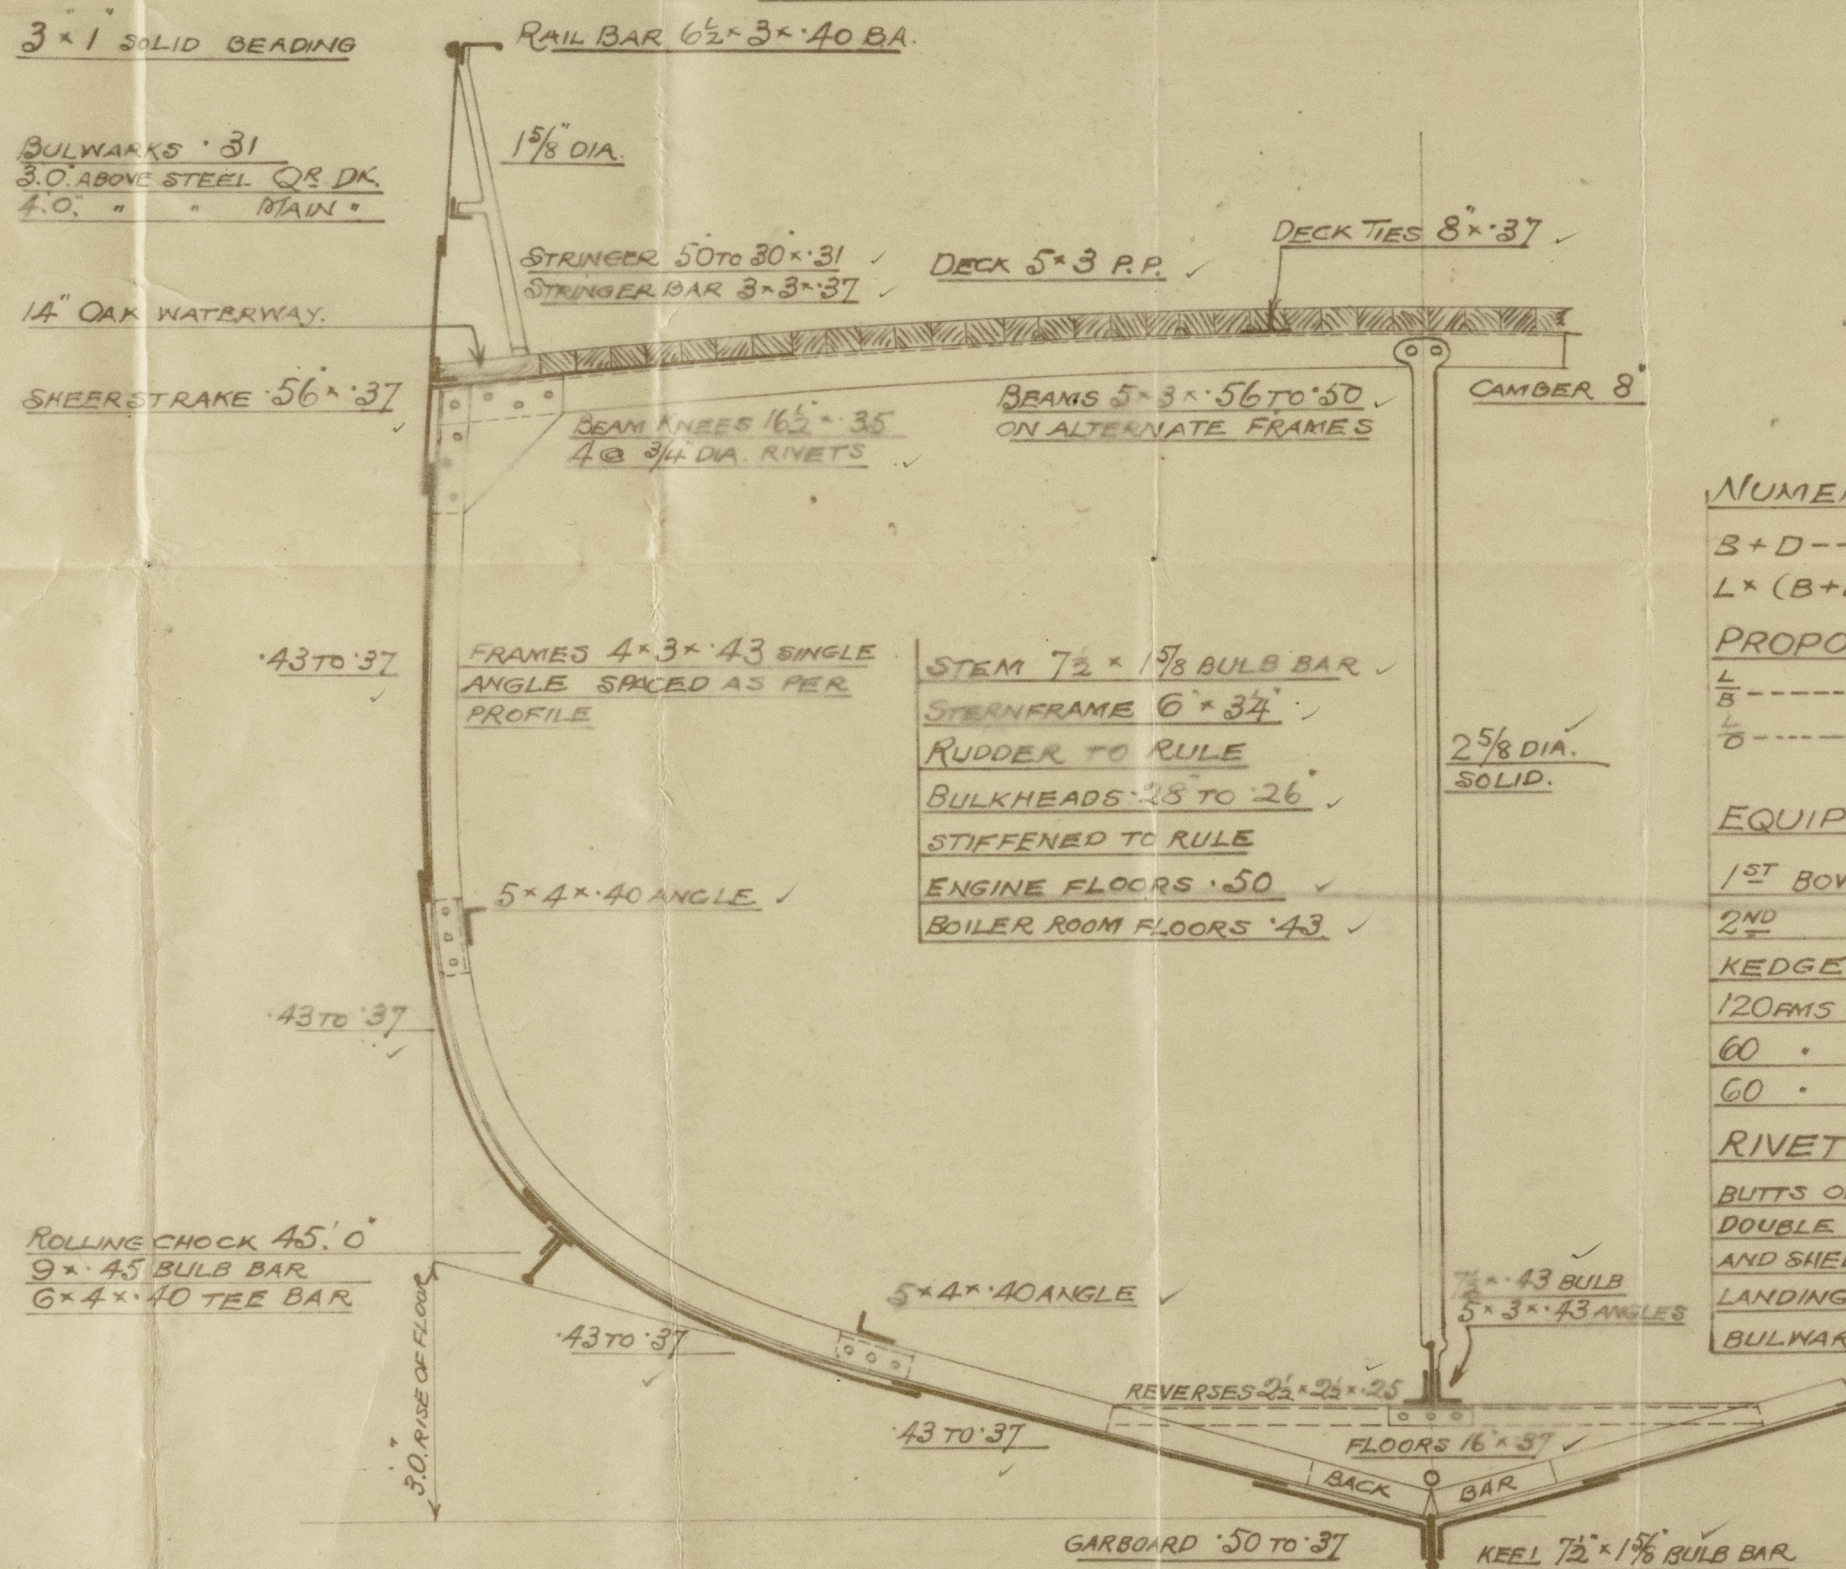

NUMERALS

B + D ----- 36.45 ✓

L x (B + D) ----- 4920.75 ✓

PROPORTIONS

L/B ----- 5.77 ✓

L/D ----- 10.32 ✓

EQUIPMENT

1ST BOWER 7 1/2 CWT'S STOCKLESS ✓

2ND " 7 " " ✓

KEDGE 3 " EX STOCK ✓

120 FMS 1 1/2" STUD LINK CABLE ✓

60 " 6" HAWSER ✓

60 " 5 WARP ✓

RIVETTING

BUTTS OF SHELL PLATES LAPPED AND
DOUBLE RIVETTED EXCEPT GARBOARD
AND SHEER STRAKE WHICH ARE STRAPPED
LANDINGS DOUBLE RIVETTED EXCEPT
BULWARKS WHICH ARE SINGLE

CCP

14.12.14.




© 2020

Lloyd's Register
Foundation

002947-002955-0002

Cochranes' no 839.

Midship Action

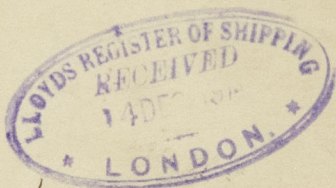

S. Tribune Hull Rpt. No 2886p.

© 2020

Lloyd's Register
Foundation

002947-002955-0002