


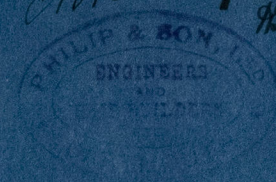

Noted. 29-10-09  
H



# DECK PLAN FOR STEAM TUGS NOS 368-369

SCALE 1/4" = 1 FOOT


Plain Plating

Chequer Plating


Plain Plating

28.10.09.

Widths of plates and shift of butts to be arranged.

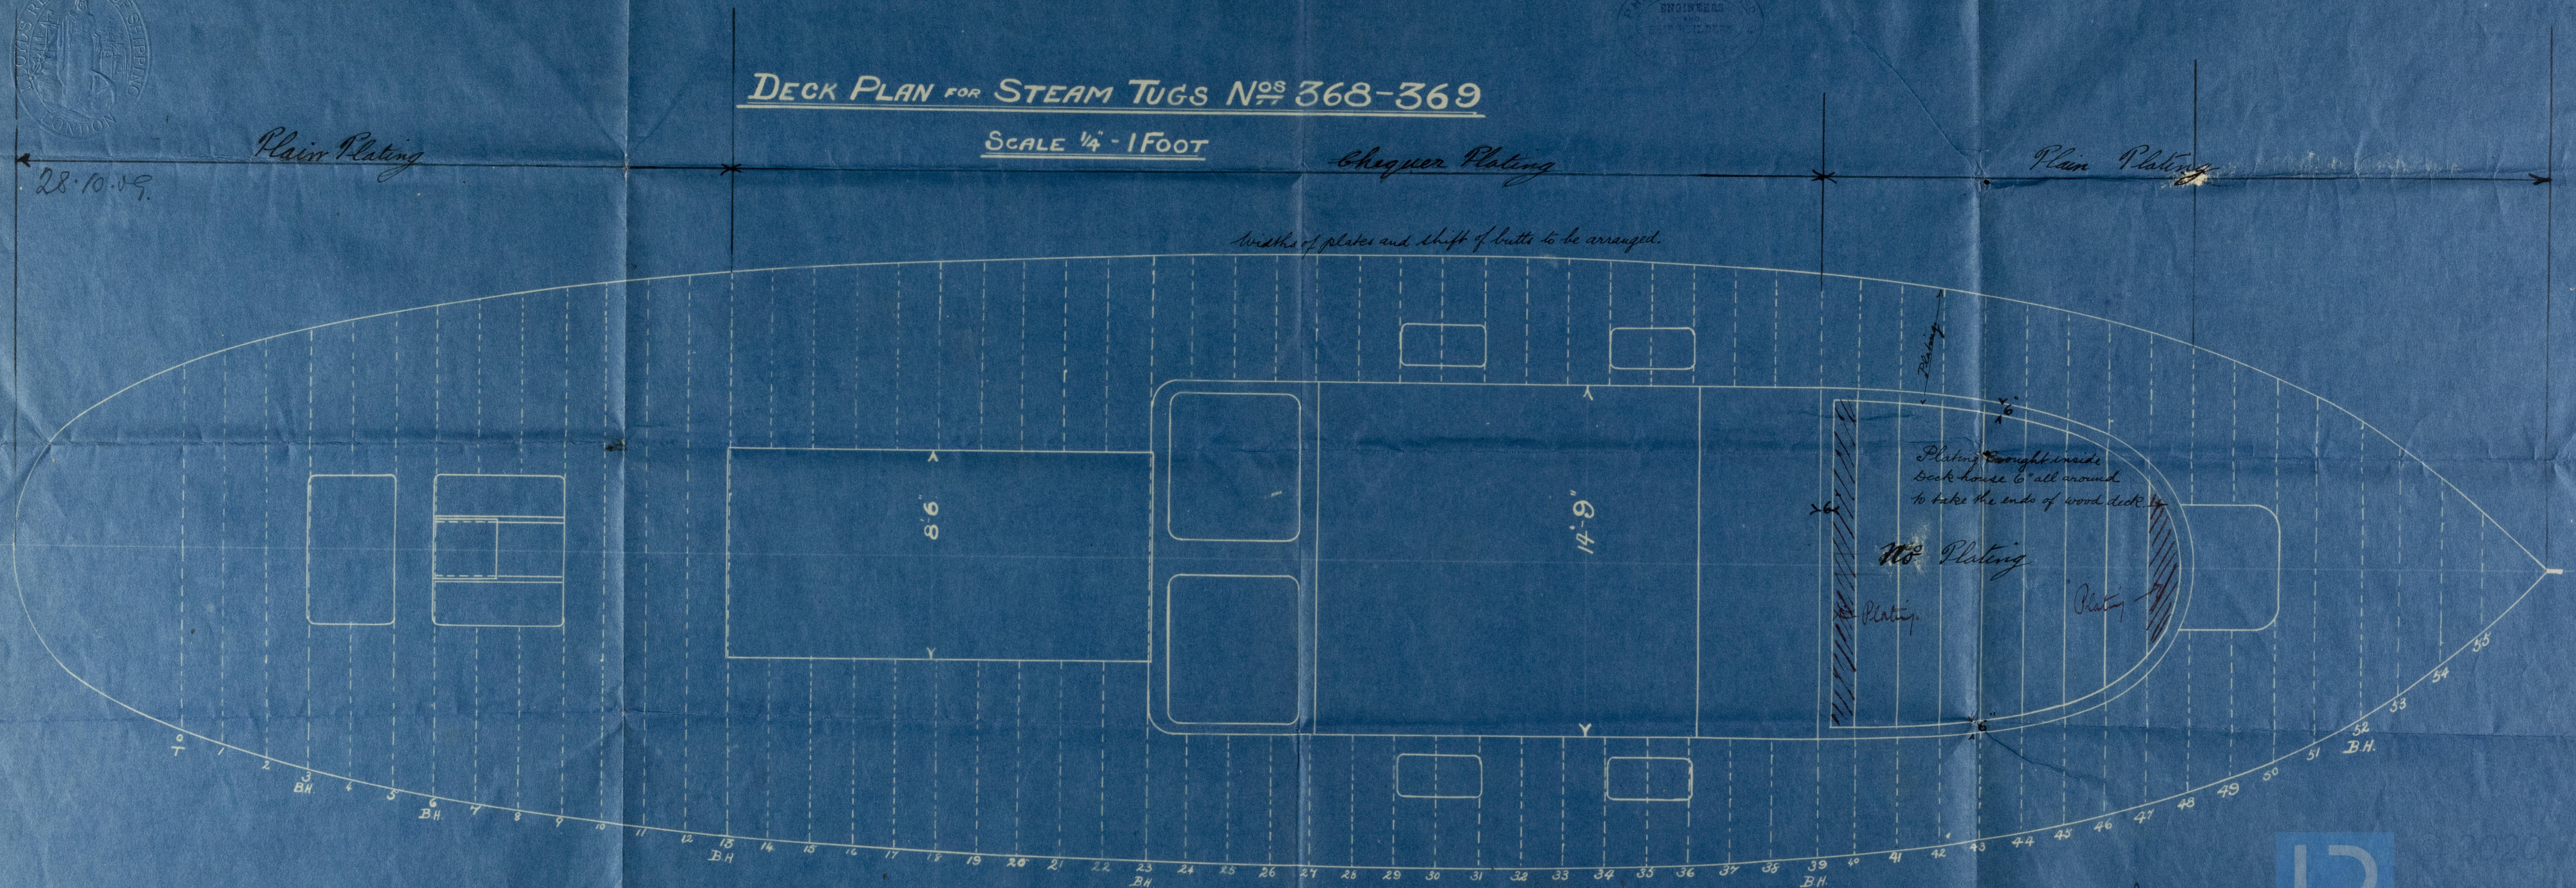


C.F.  
28/10/09.

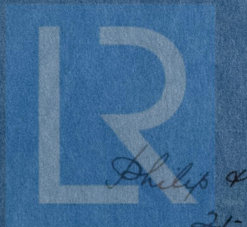

Lloyd's Register of Shipping  
Philip & Son Ltd.  
21-10-09. H




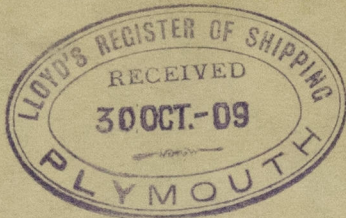

Deck Plate  
Nos 368-9  
Gr L<sup>o</sup> Art

S/s "Danube II" and  
Ply Rpt 5306

S/s "Southampton"  
Ply Rpt 5314

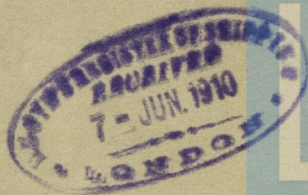

© 2020

Lloyd's Register  
Foundation

002947-002955-0030