


## "G" DECK

✓ Plating and beams over oil  
fuel tankers to be re-considered  
with plan of same, and when  
height of over/low is given

"H" DECK.

\* To be considered with plan 9) after peak when height of overflow is known.

## "H" DECK

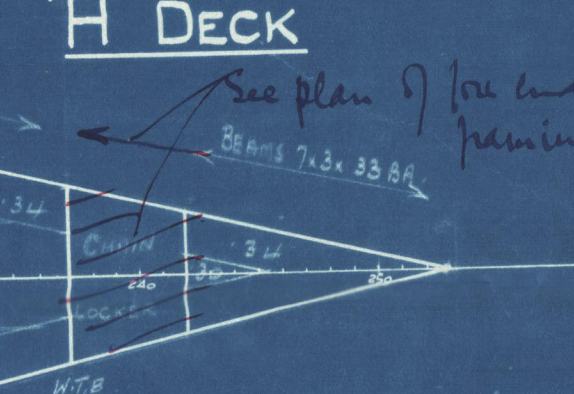

See plan of low end  


TUNNEL FLAT.

SCANTLINGS OF OIL FUEL BUNKERS  
TO BE SUBMITTED:

TANK TOP.

## "J" DECK

TANK TOP.



✓ (11)  
Swan Hunter's No 1547

G. H. & J. Becks  
Tank top.

L.S.M.V. "Dominion  
monarch"  
NEWCASTLE ON TYNE.  
Report No. 97140.



© 2020

Lloyd's Register  
Foundation

602947-002955-0222