


SCALE: $\frac{1}{2}$ INCH = 1 FOOT.

ALL SECTIONS 'NEW BRITISH STANDARD.'

3 BOWER ANCHORS 15 CENTS EACH STOCKLESS.
1 STREAM ANCHOR 46 CENTS. EX. STOCK.
300 D-TIME 2³/₈" TAYLO STUD CHAIN ZABLE
150 " 6" STEEL STREAM WIRE G-24.
150 " 8" STEEL WIRE TONLINE G-30
6 @ 150 " 8" MANILA ROPE WARPS
8 @ 150 " 8" " MOORING.
6 @ 150 " 3¹/₂" STEEL WIRE G-24

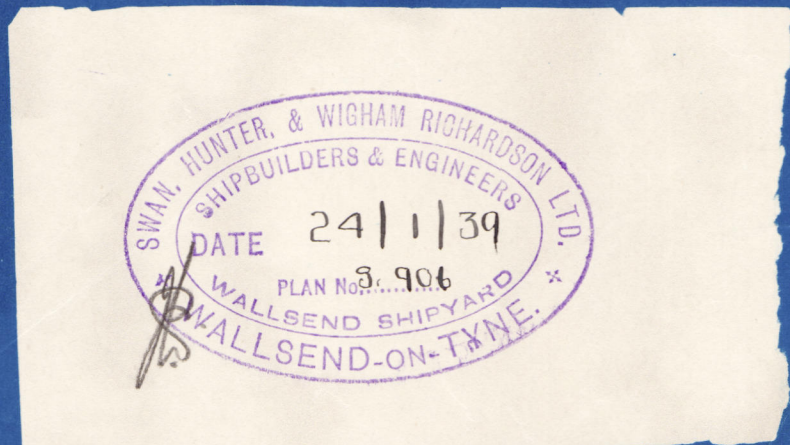

97

Q.S.M.V.
Dominion Monarch

Swan Hunter's No 1547

Midship Section as Built

O.S.M.V. Dominion Monarch

NEWCASTLE ON TYNE.

Report No. 9714a.

RETAIN



© 2020

Lloyd's Register
Foundation

002947-002955-0223