




7.9.10

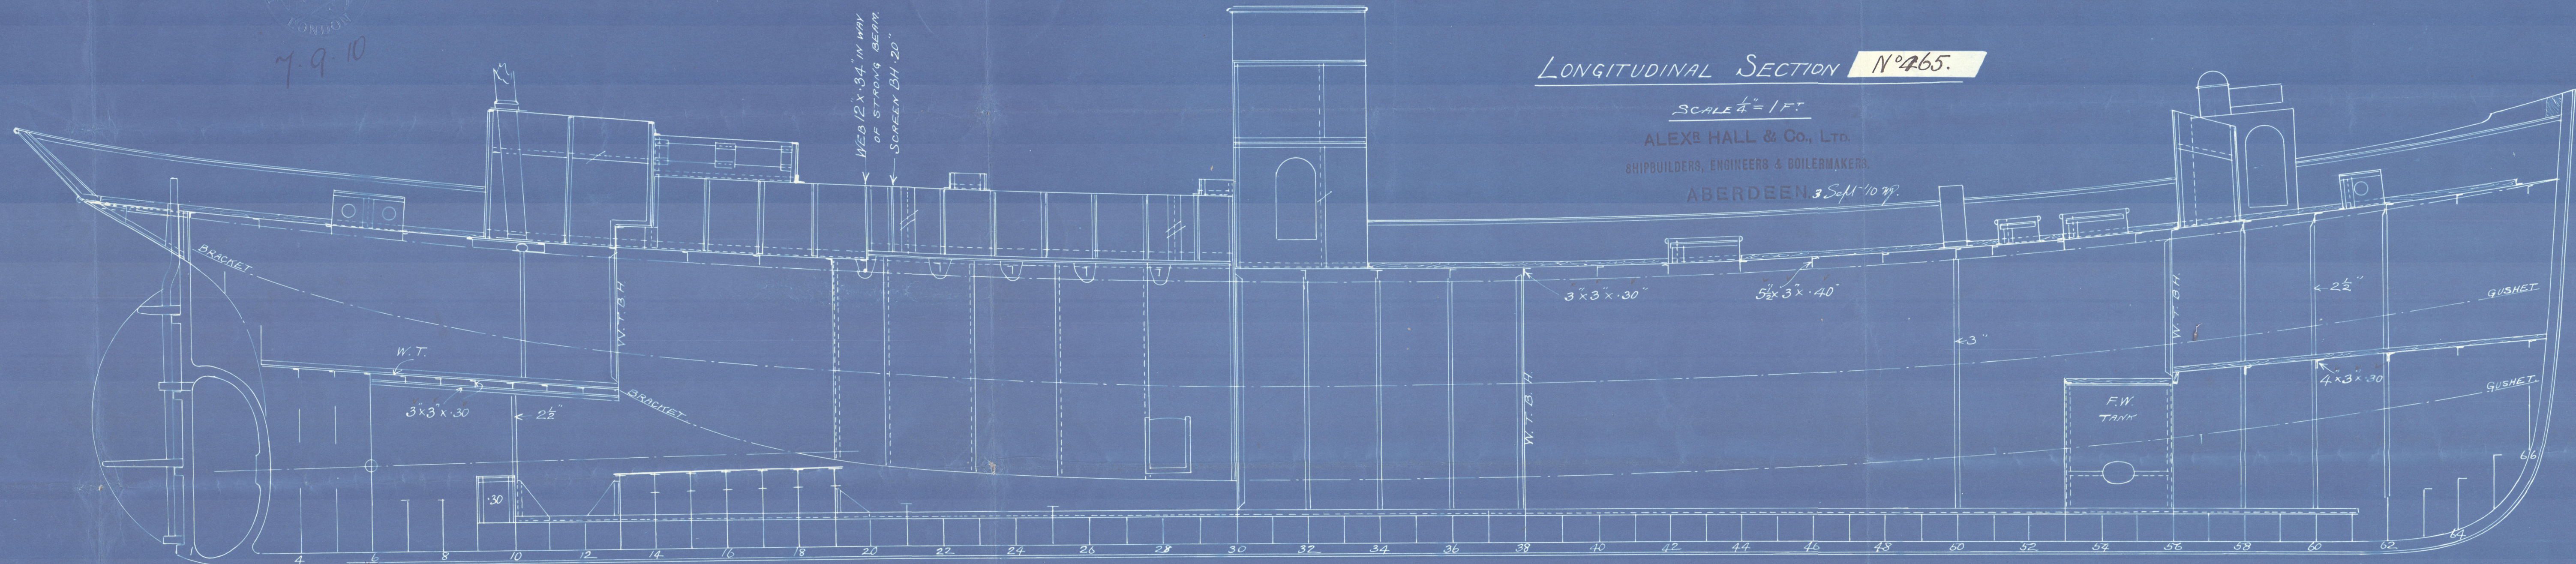

LONGITUDINAL SECTION N°465.

SCALE  $\frac{1}{4}$ " = 1 FT.


ALEX HALL & Co., LTD.

SHIPBUILDERS, ENGINEERS & BOILERMAKERS.

ABERDEEN. 3 Sept '10 779.

*Collaring throughout to Surveyor's satisfaction  
Masts supported to Surveyor's satisfaction*

C.F.  
7.9.10

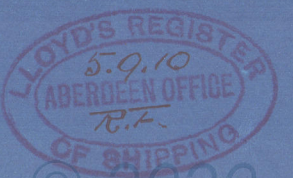


© 2020



Lloyd's Register  
Foundation

002956-002969-0014



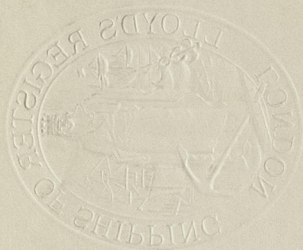


A Hall & Co L<sup>d</sup>

N<sup>o</sup> 465

Profile

S.S. "Ann Ford Melville"

Abn kept. N<sup>o</sup> 10508.

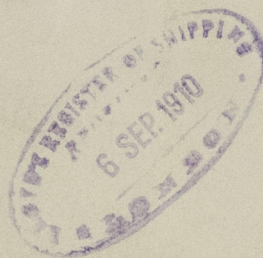

© 2020

Lloyd's Register  
Foundation

002956-002969-0014