



STERN FRAME

S.S. N° 197

SCALE $\frac{3}{4}$ " = 1 FOOT

RIVETS IN STERN FRAME $\frac{1}{8}$ " D. HOLES $\frac{3}{16}$ " DIA. SPACED $5\frac{5}{8}$ " APART C^R TO C^R


TO PASS LLOYDS

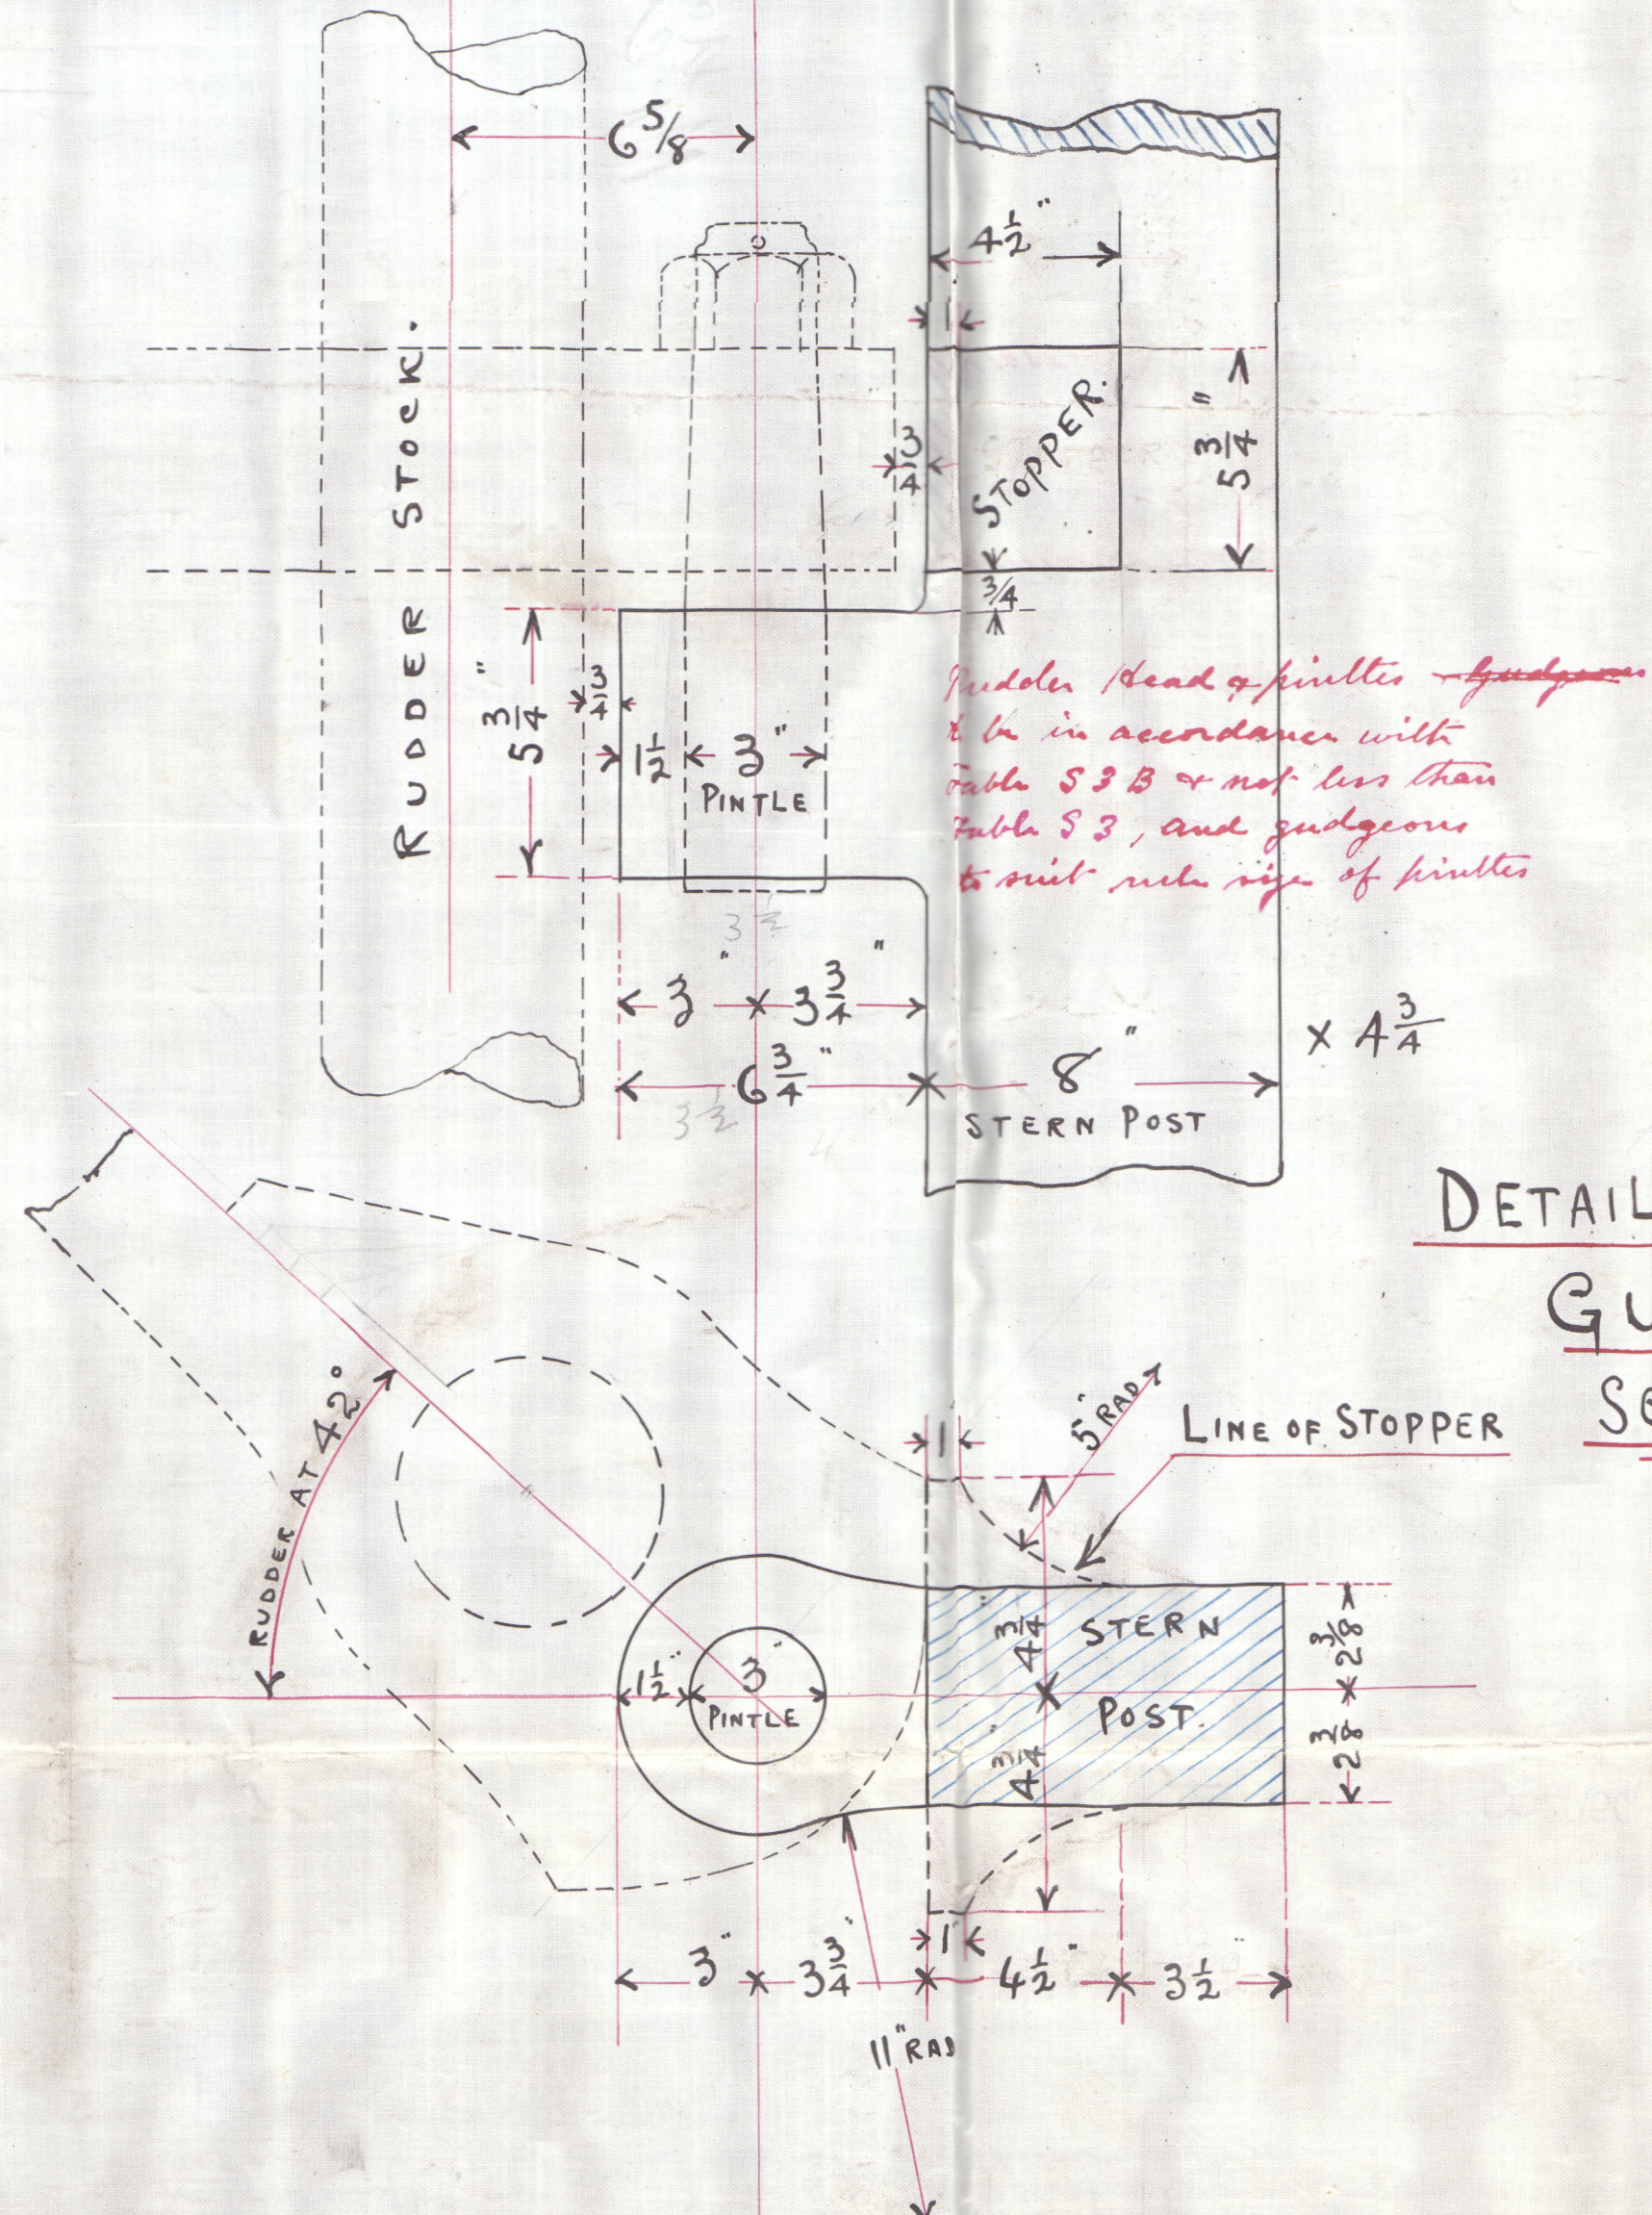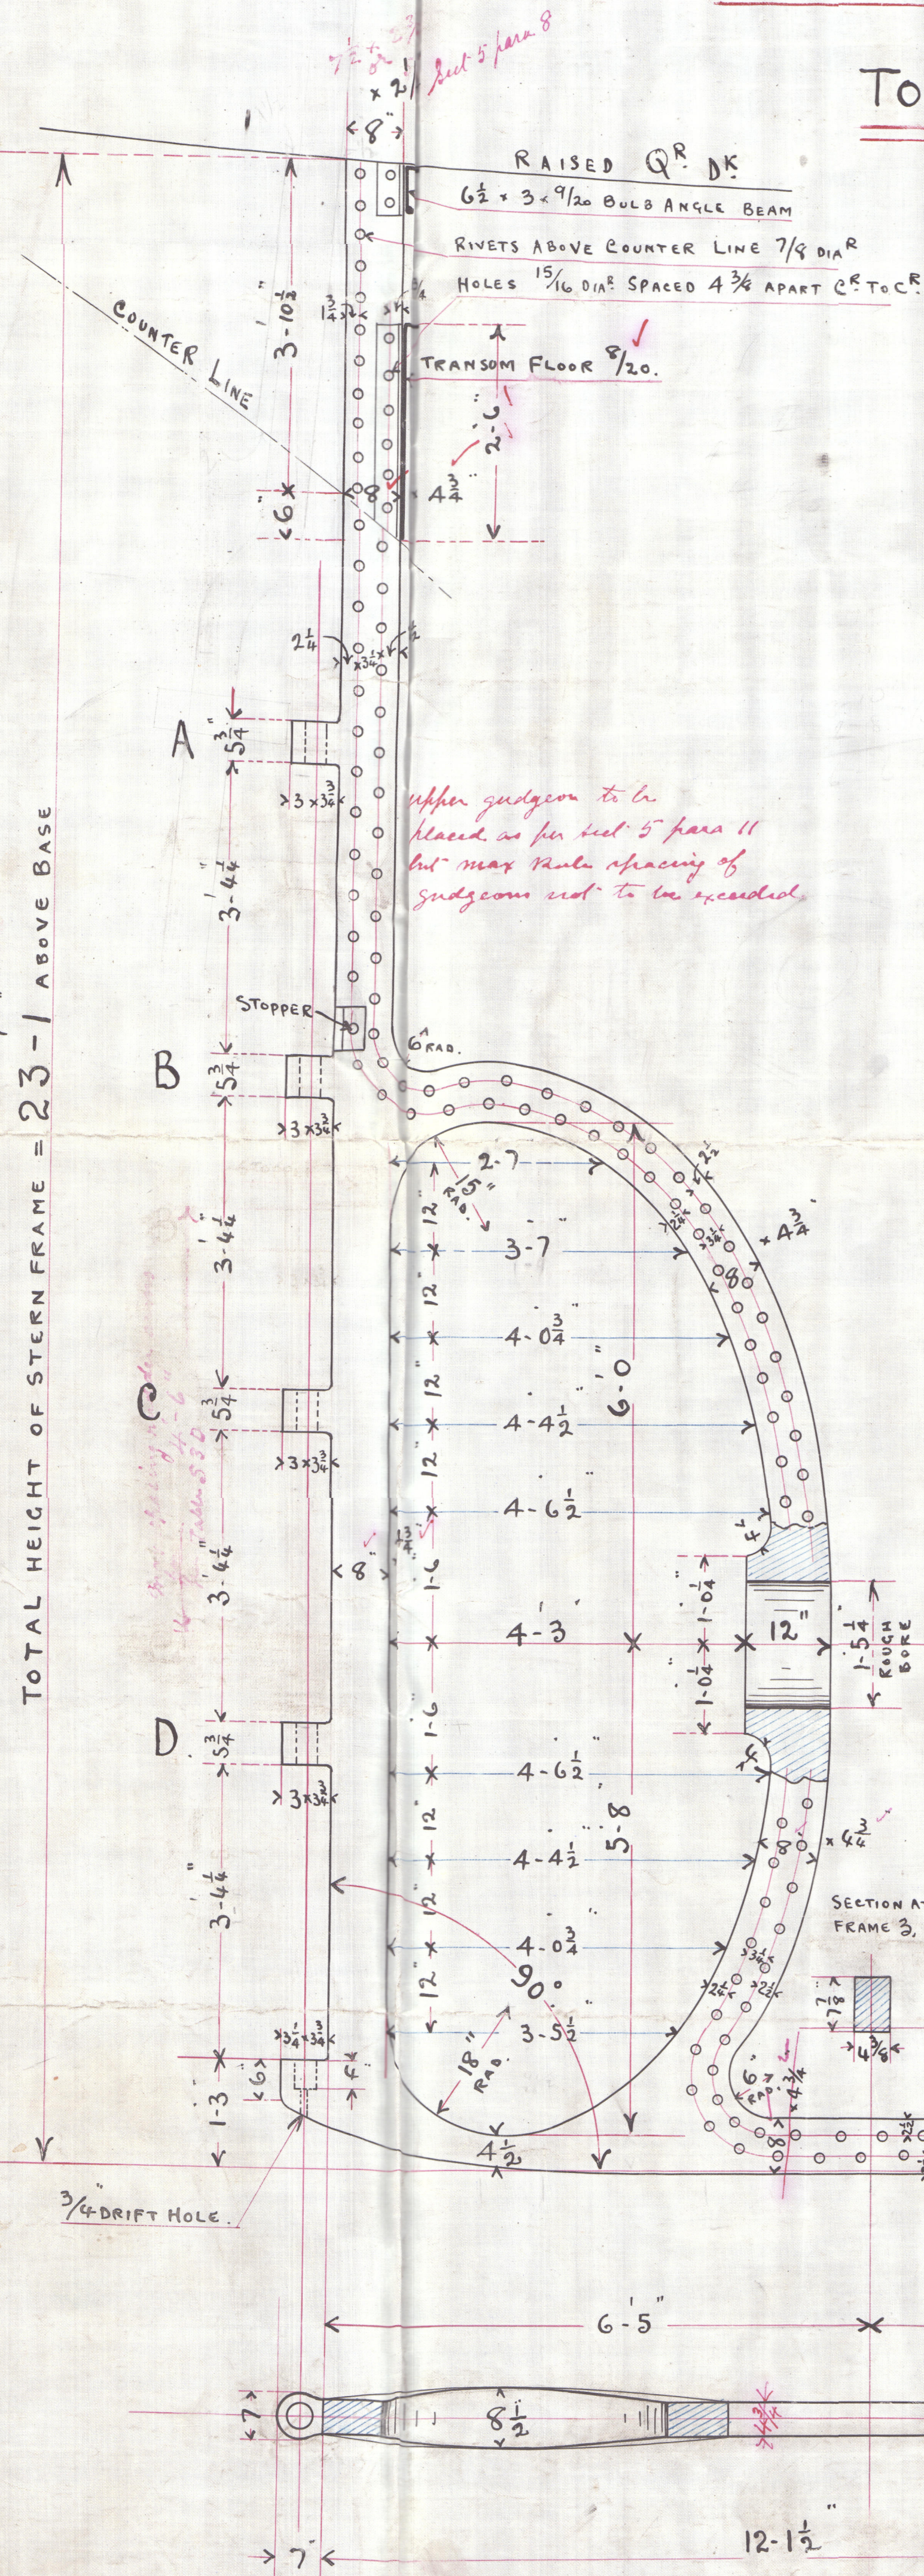

DETAILS OF A.B.C&D.

GUDGEONS

SCALE 3" = 1 FOOT.

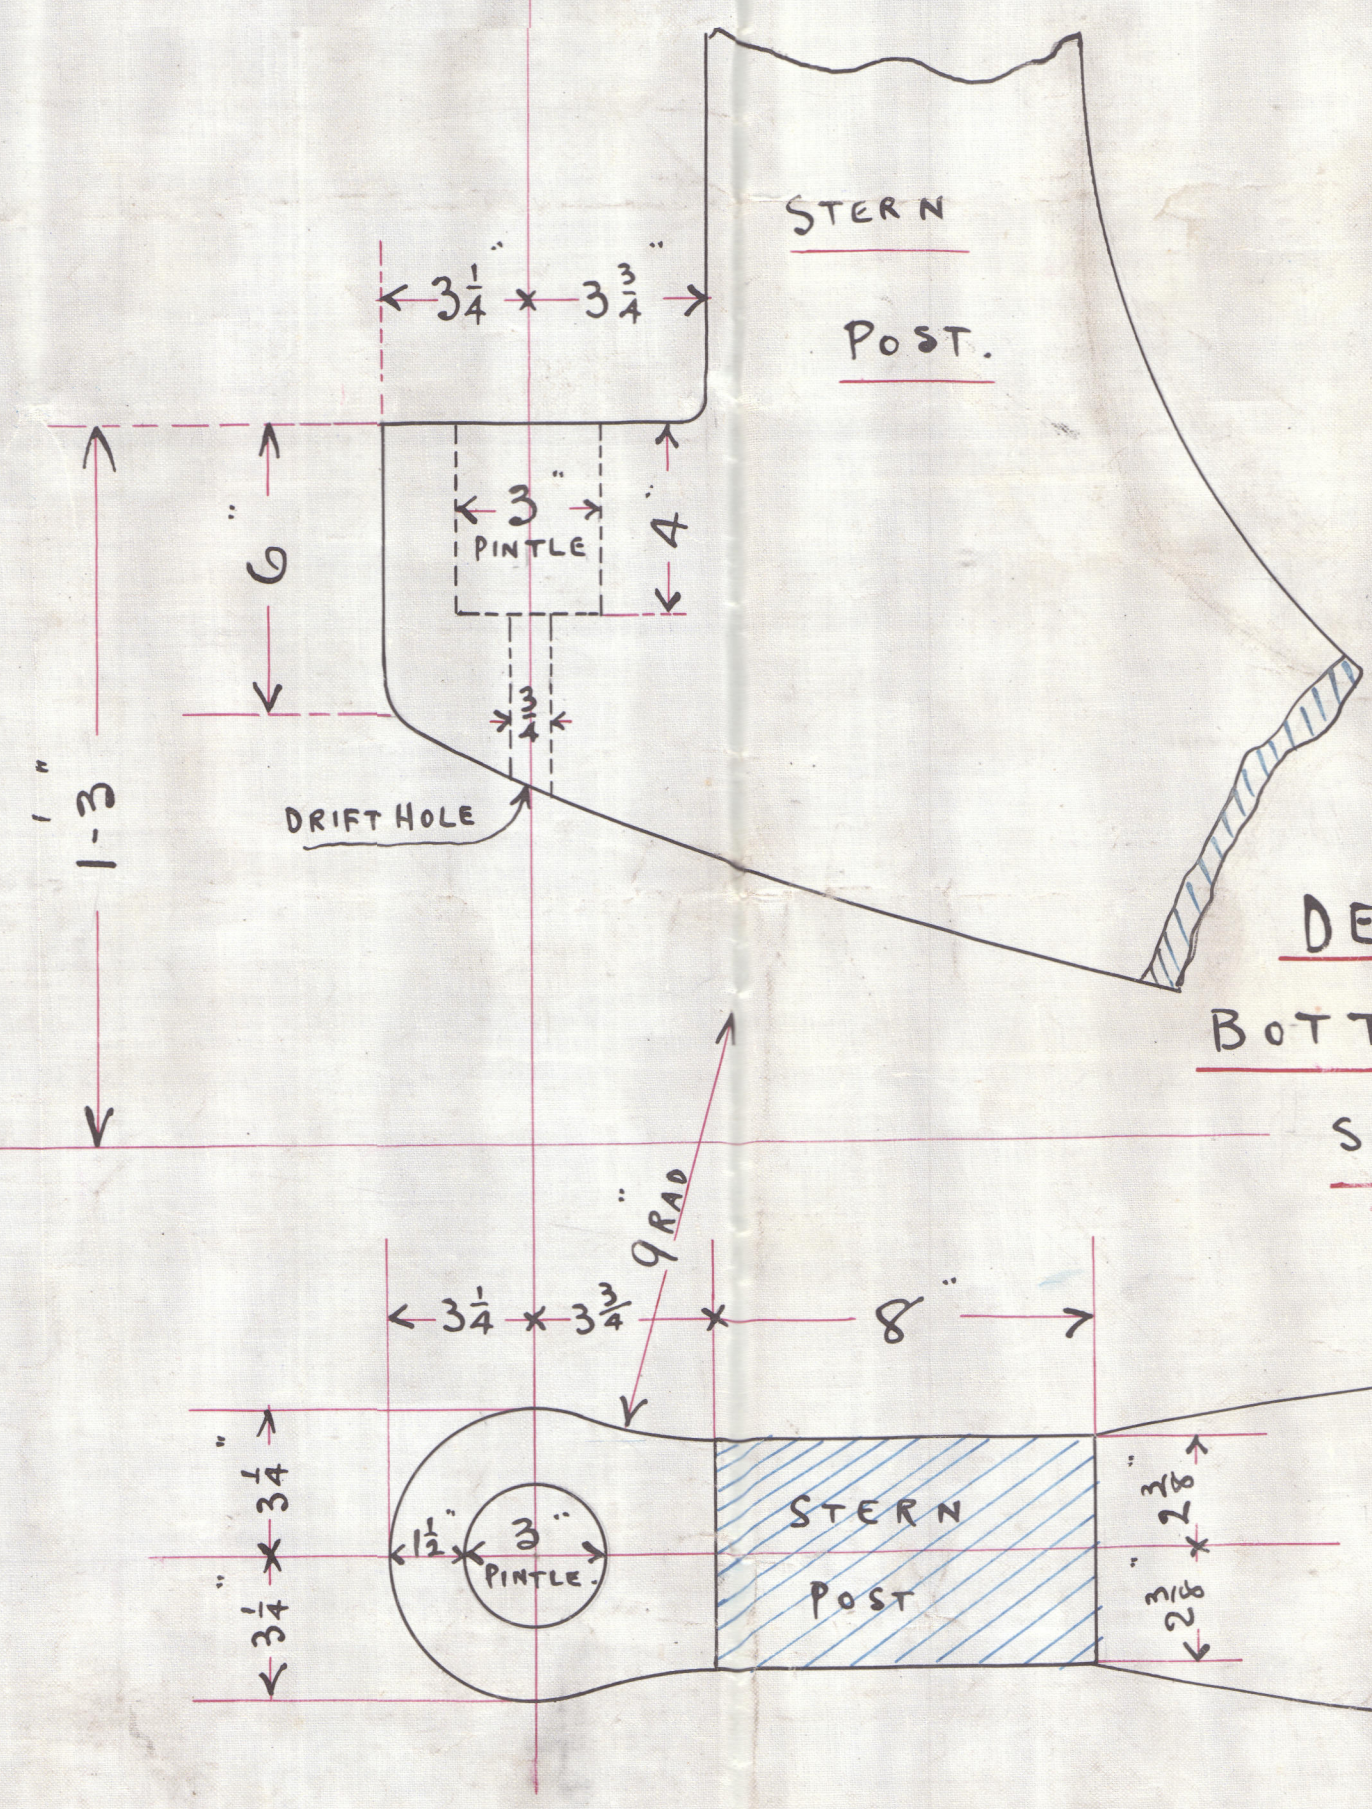

DETAIL OF

BOTTOM GUDGEON

SCALE 3" = 1 FOOT.



Steu. Fraun
Dundee S.P. Co.
N. 197
S. S. "Tropeliro"
Dun Rept. 7361

BOLTON GUDGEON

DELVIG ST



© 2020

Lloyd's Register
Foundation

002956-002969-0184