


Nº 197

SCALE $\frac{1}{8}" = 1 \text{ FOOT}$


TO CLASS 100 A.I. @ LLOYD'S

7.8.07
6.11.07
7.1.08
16.3.08


PROFILE

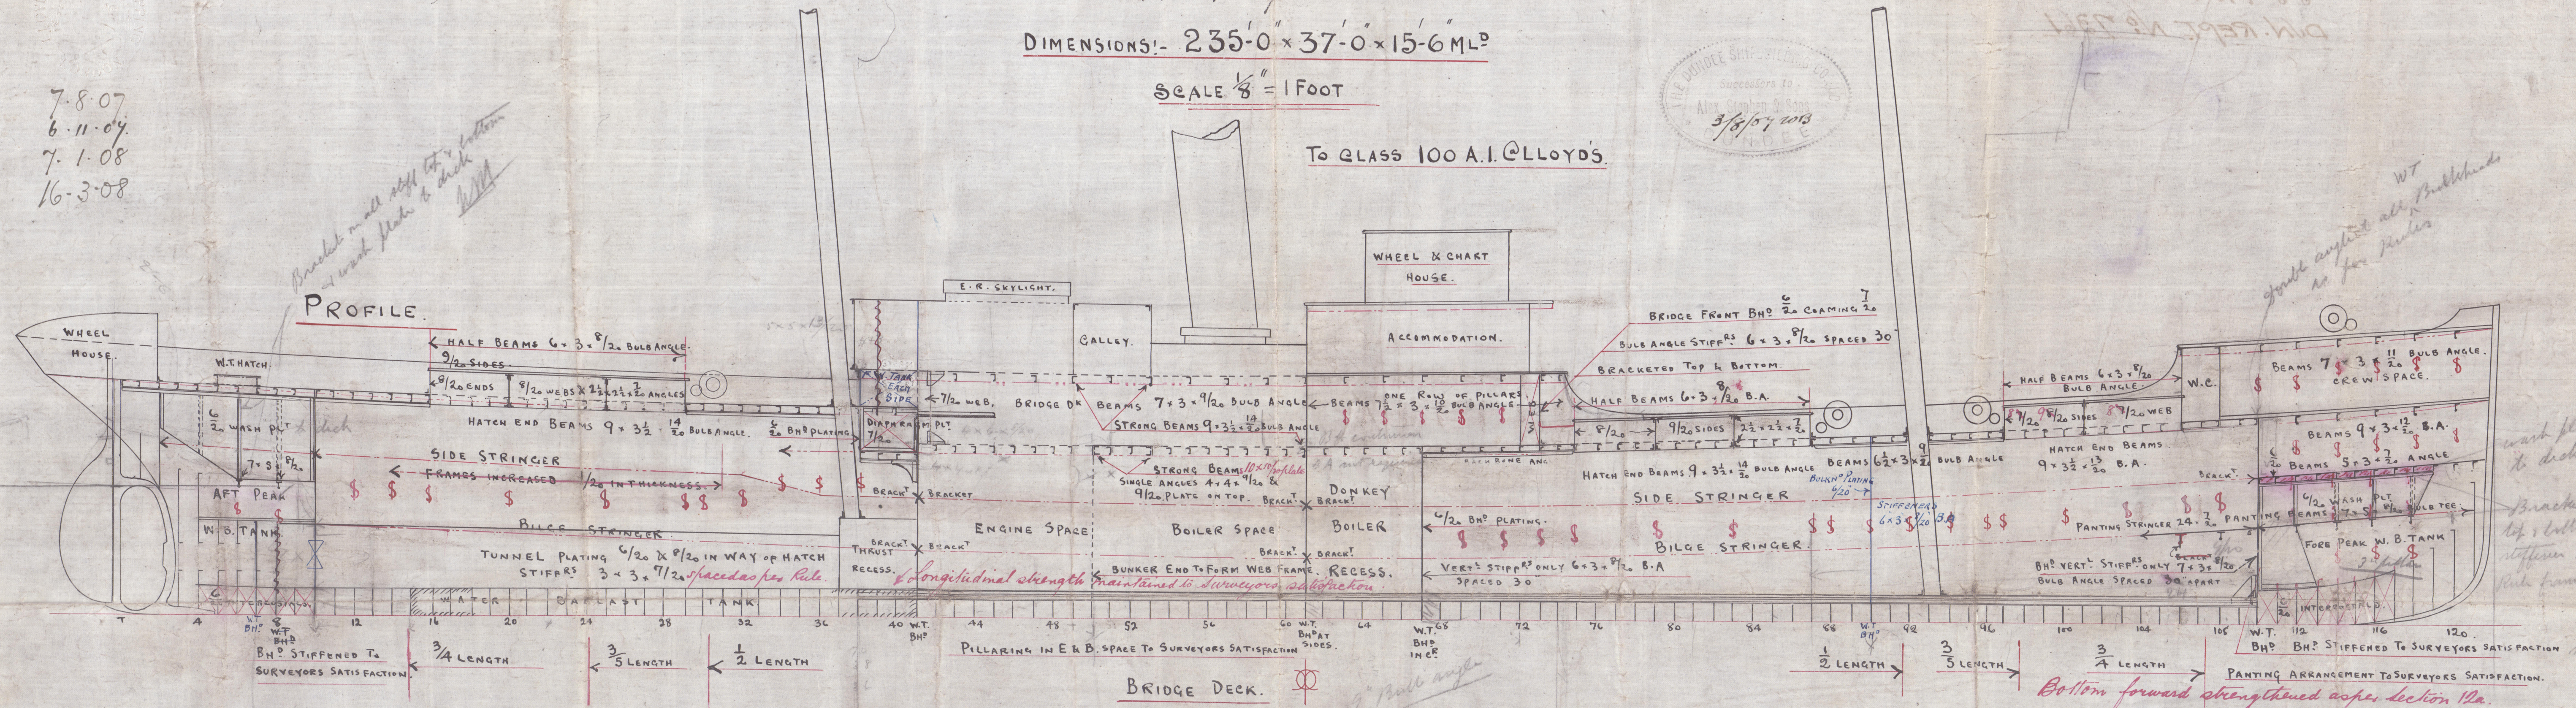


BRIDGE DECK.

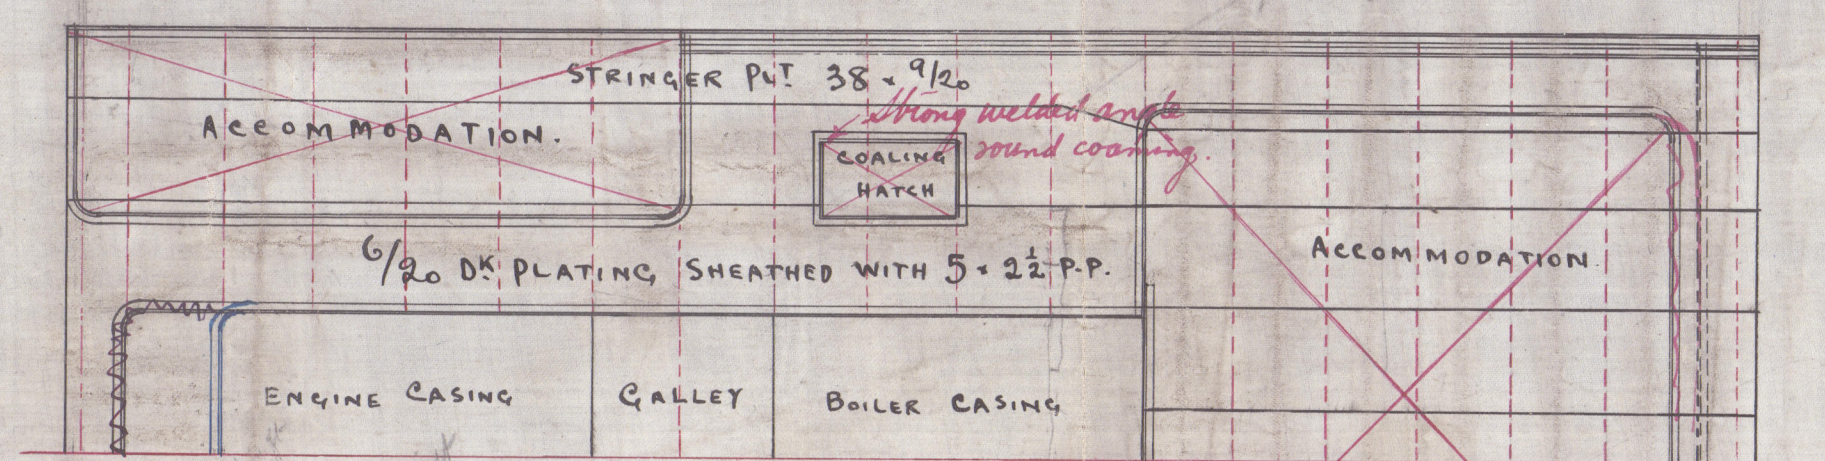

PILLARING UNDER WINCHES TO SURVEYORS SATISFACTION

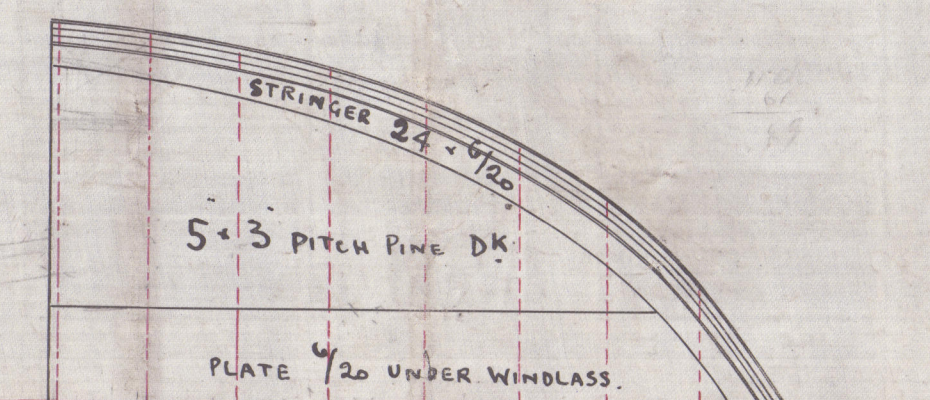FORECASTLE D^K

QUARTER DECK

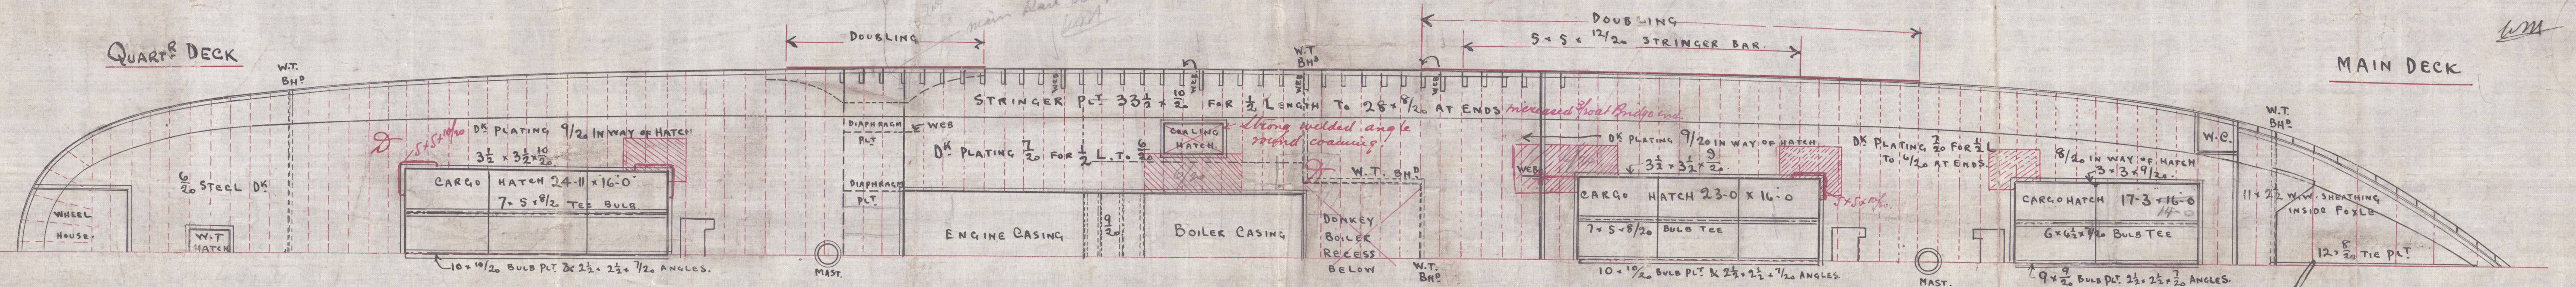

MAIN DECK

C.B.
7.8.07.


Profile Plan

Dunder AB Coy's

S.S. No 197

S.S. "TROPEIRO"

DUN. REPT. No 7361

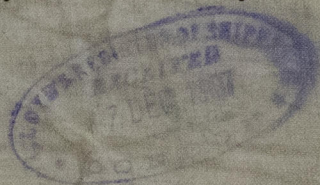

© 2020

Lloyd's Register
Foundation

002956-002969-0186