


PROFILE & DECK PLAN ~ No. 1168 ~ 165'-0" B.P. x 27'-6" MLD. x 15'-0" MLD. ~ TO CLASS 100. A.I. ~ STEAM TRAWLER.

SCALE $\frac{1}{4}$ " = 1 FT.

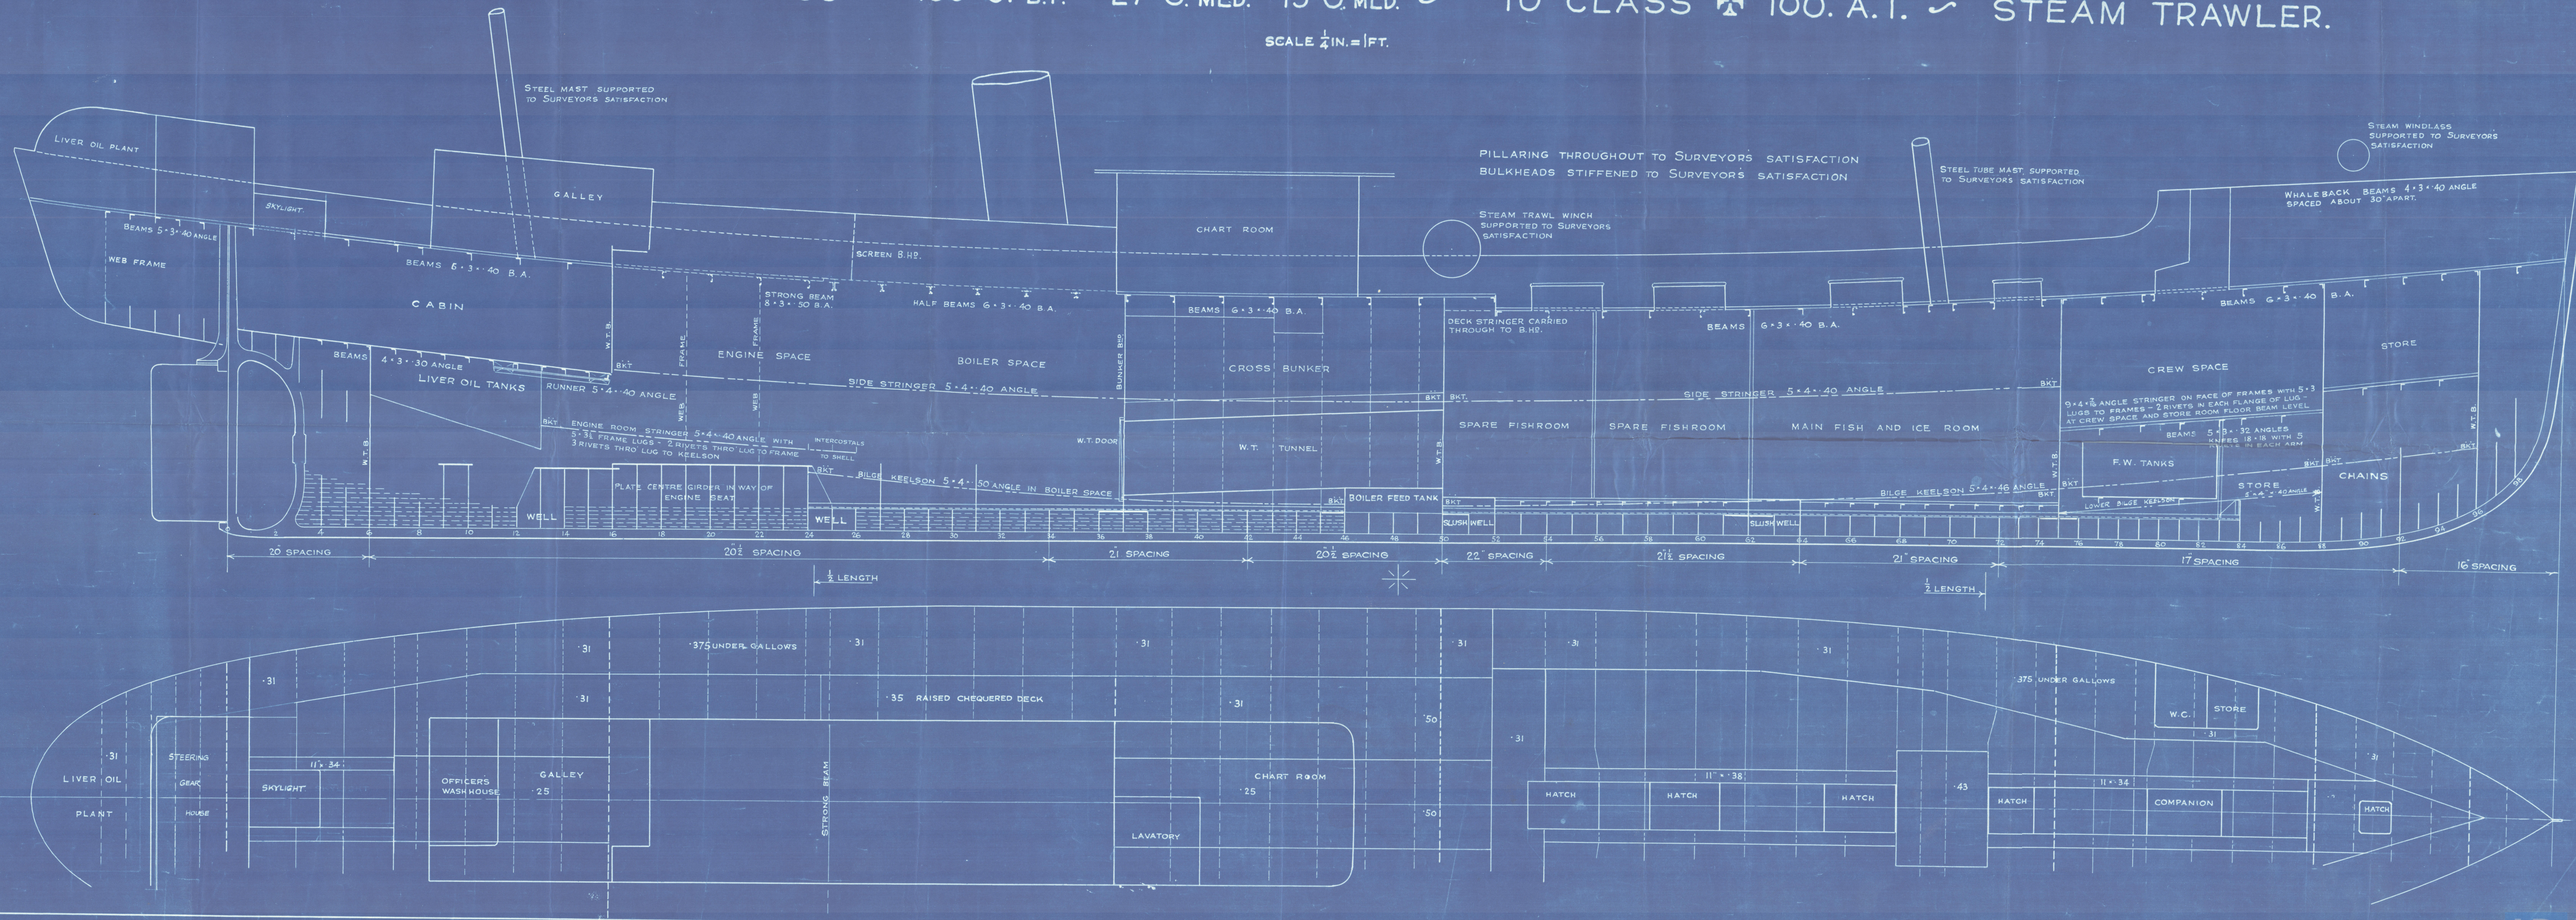


PLAN No. 4784
FOR ENCLOSURE TO
Lloyds Register of Shipping
Hull FROM
COCHRANE & SONS, LTD,
SHIPBUILDERS, SELBY.
DATE *28/1/6*

King Sol

Profile & Deck (as built)

S.S. *K "King Sol"*
HULL REPORT No. *47183*

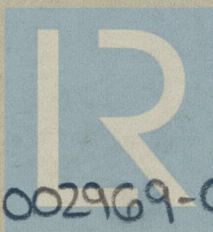

© 2020

Lloyd's Register
Foundation

002956-002969-0284