
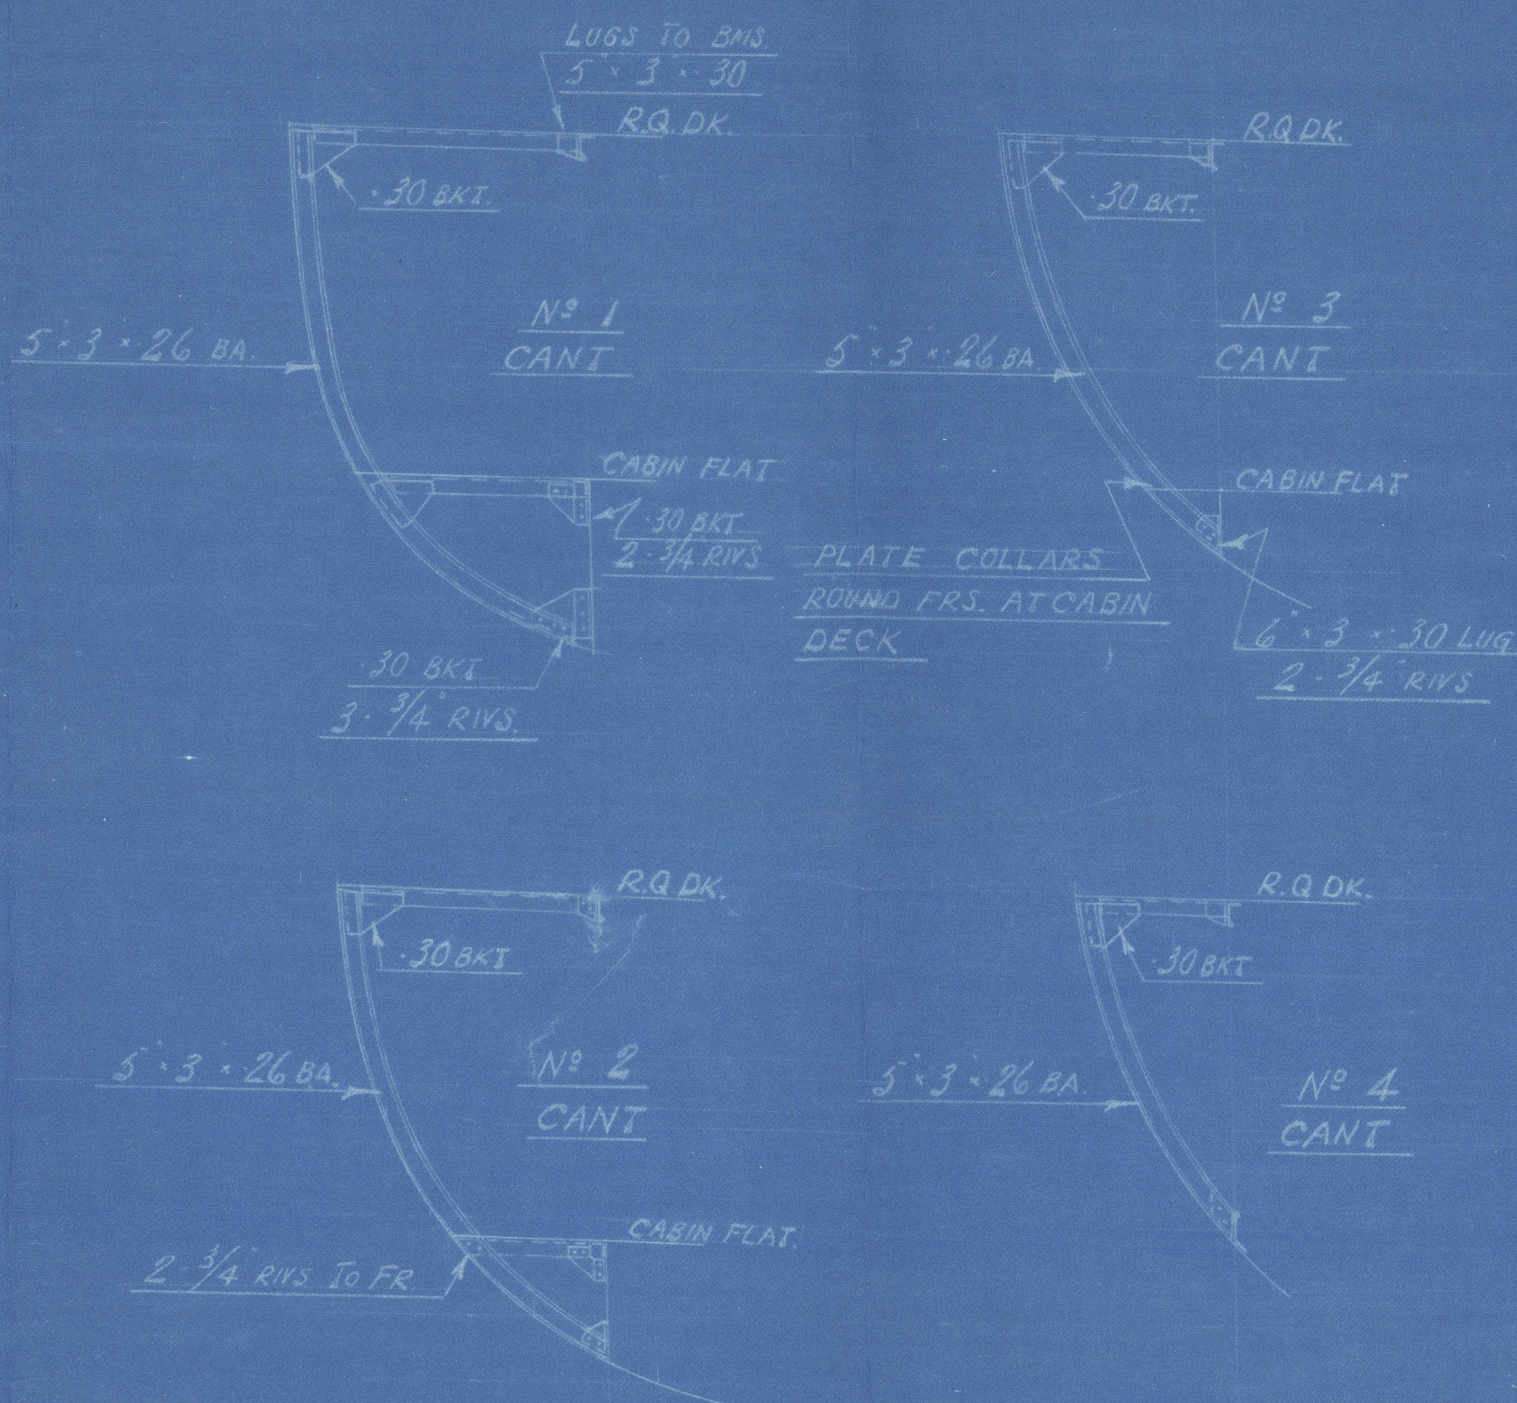
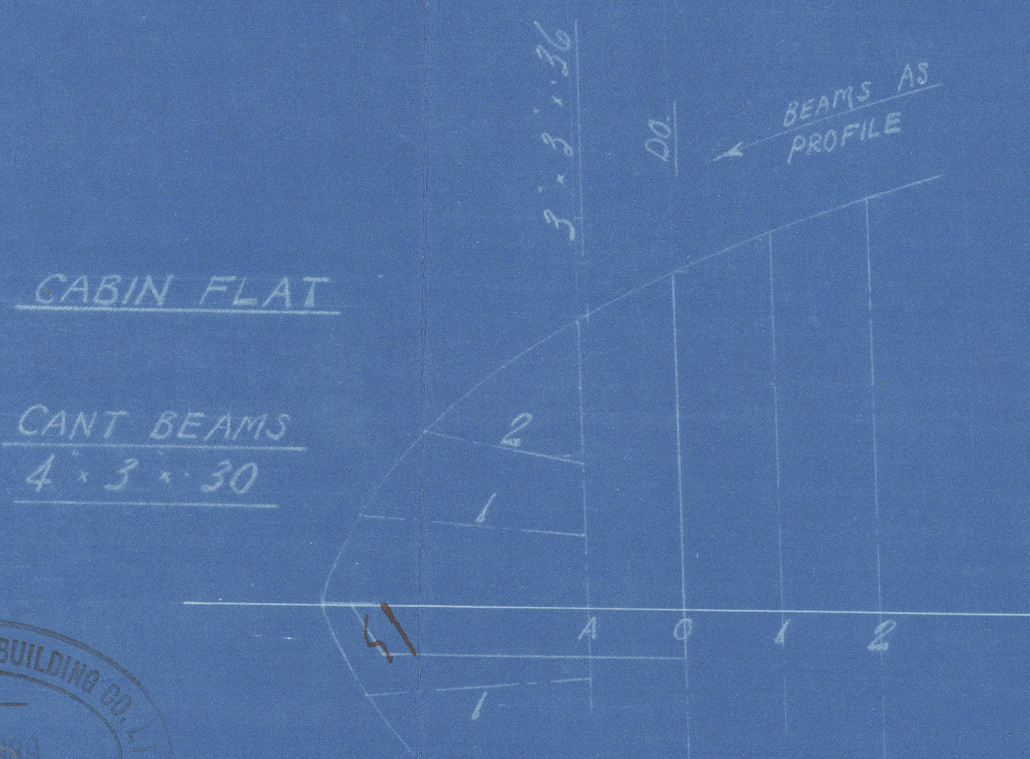
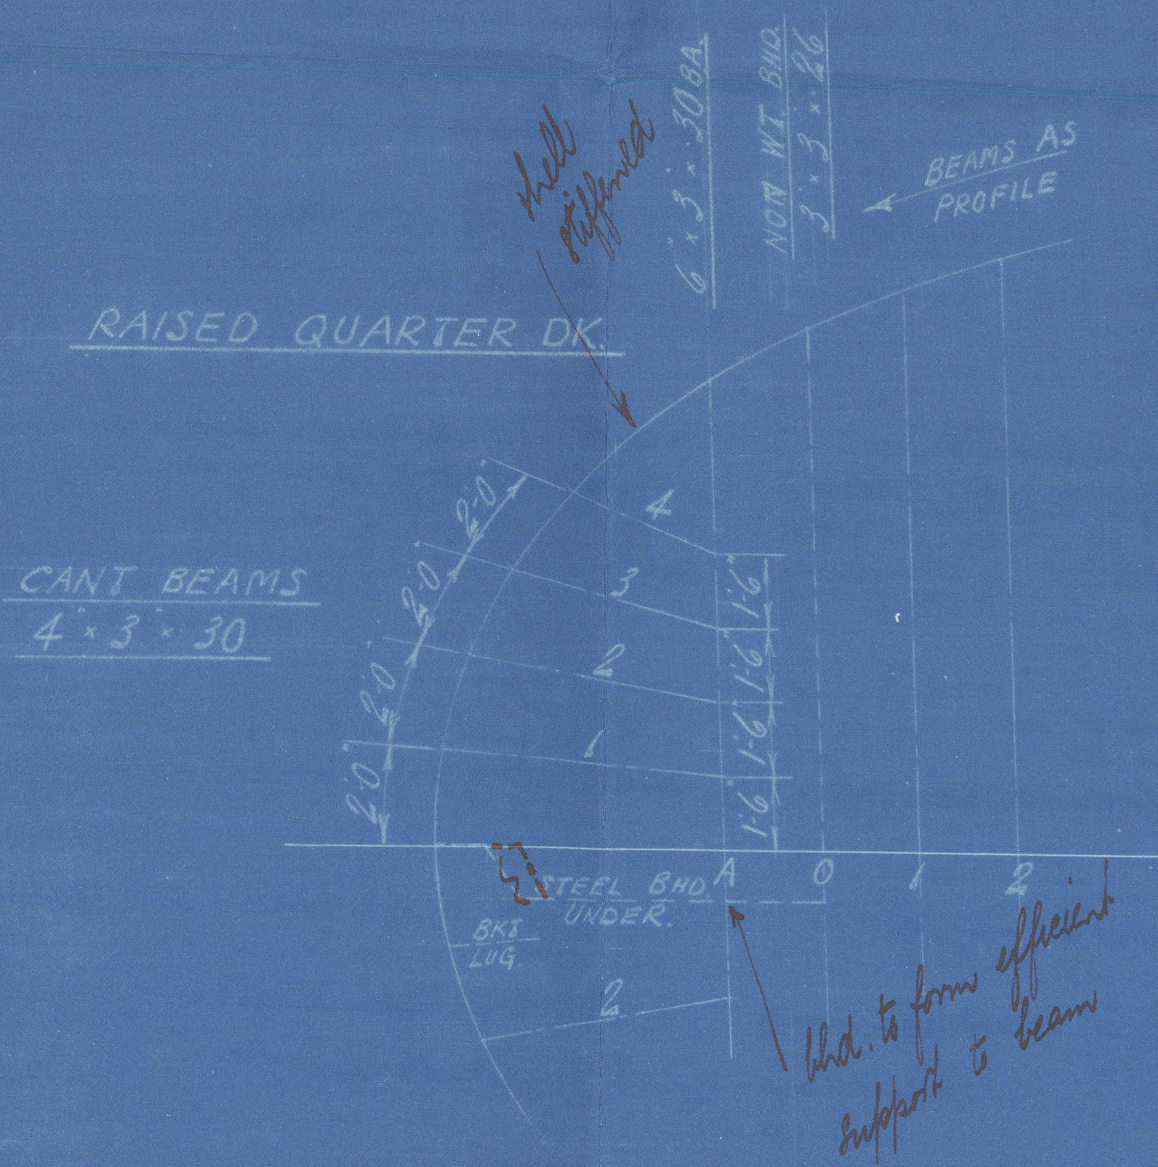
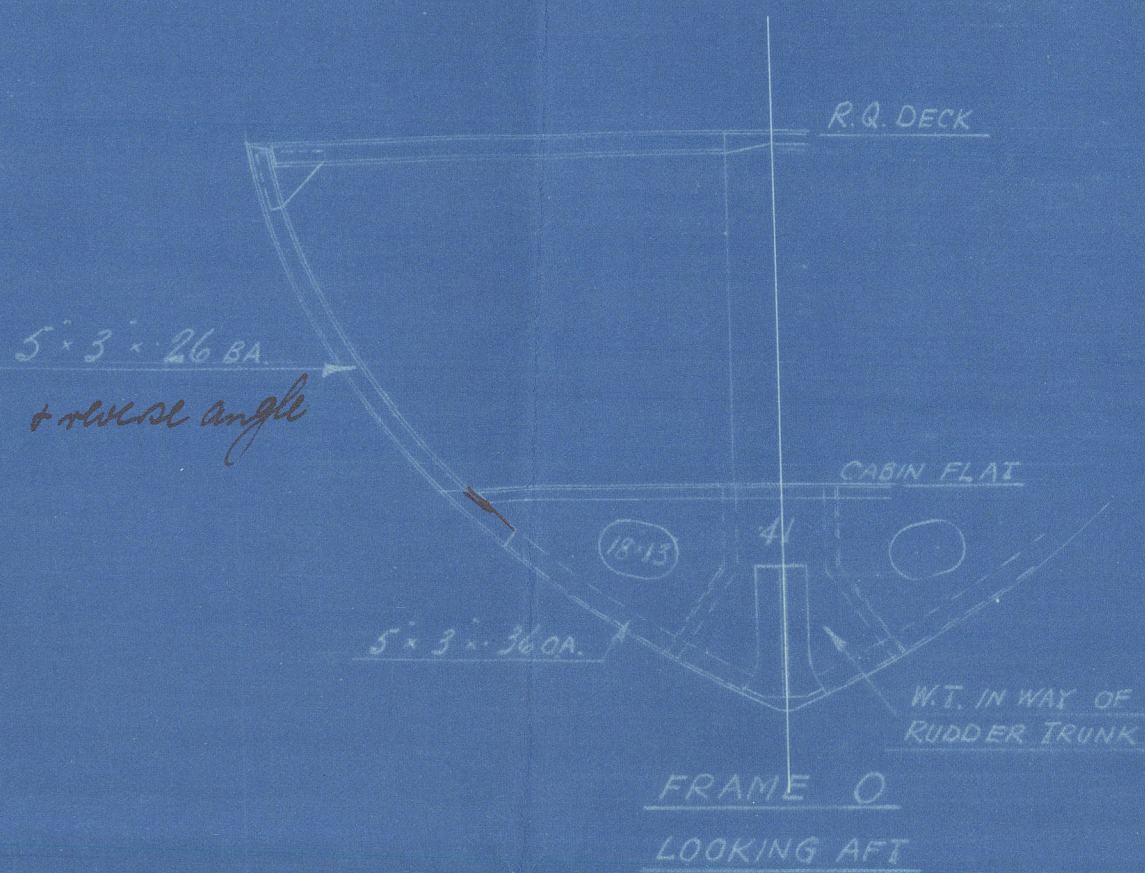
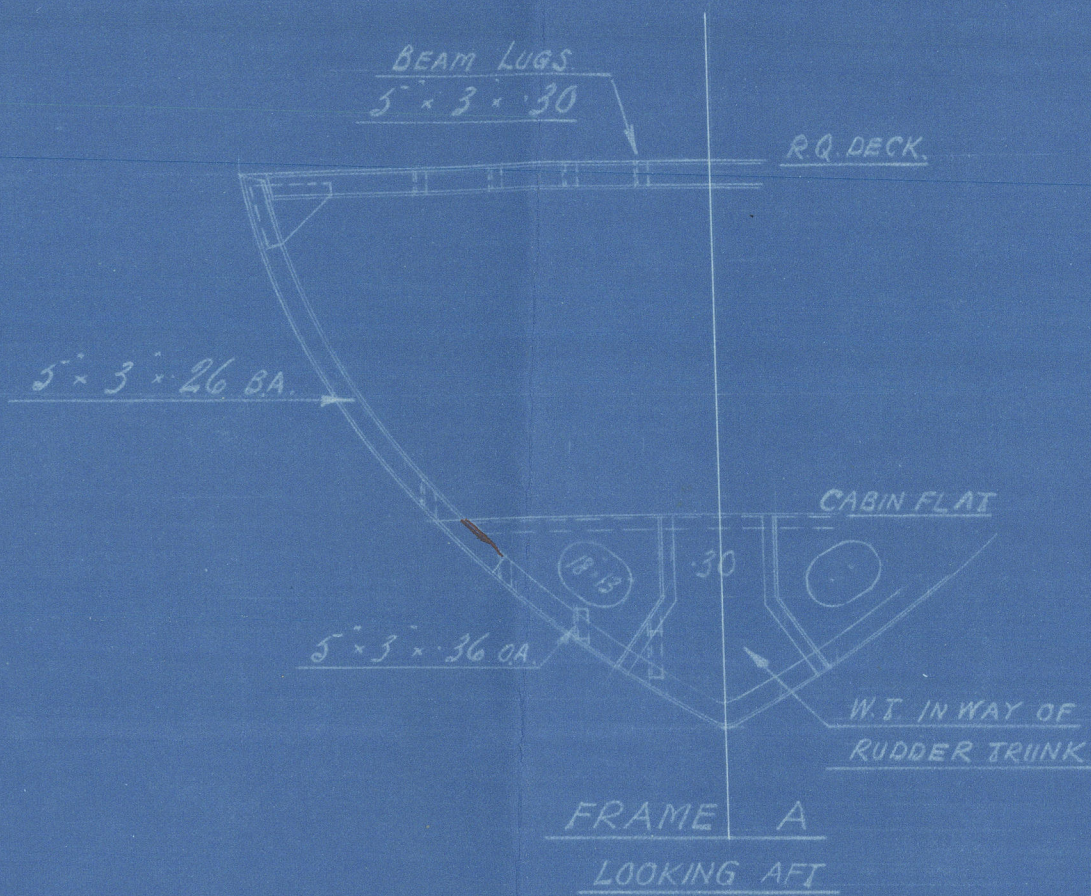


SHIP N^o 247 STERN FRAMING

SCALE $\frac{1}{4}" = 1'-0"$

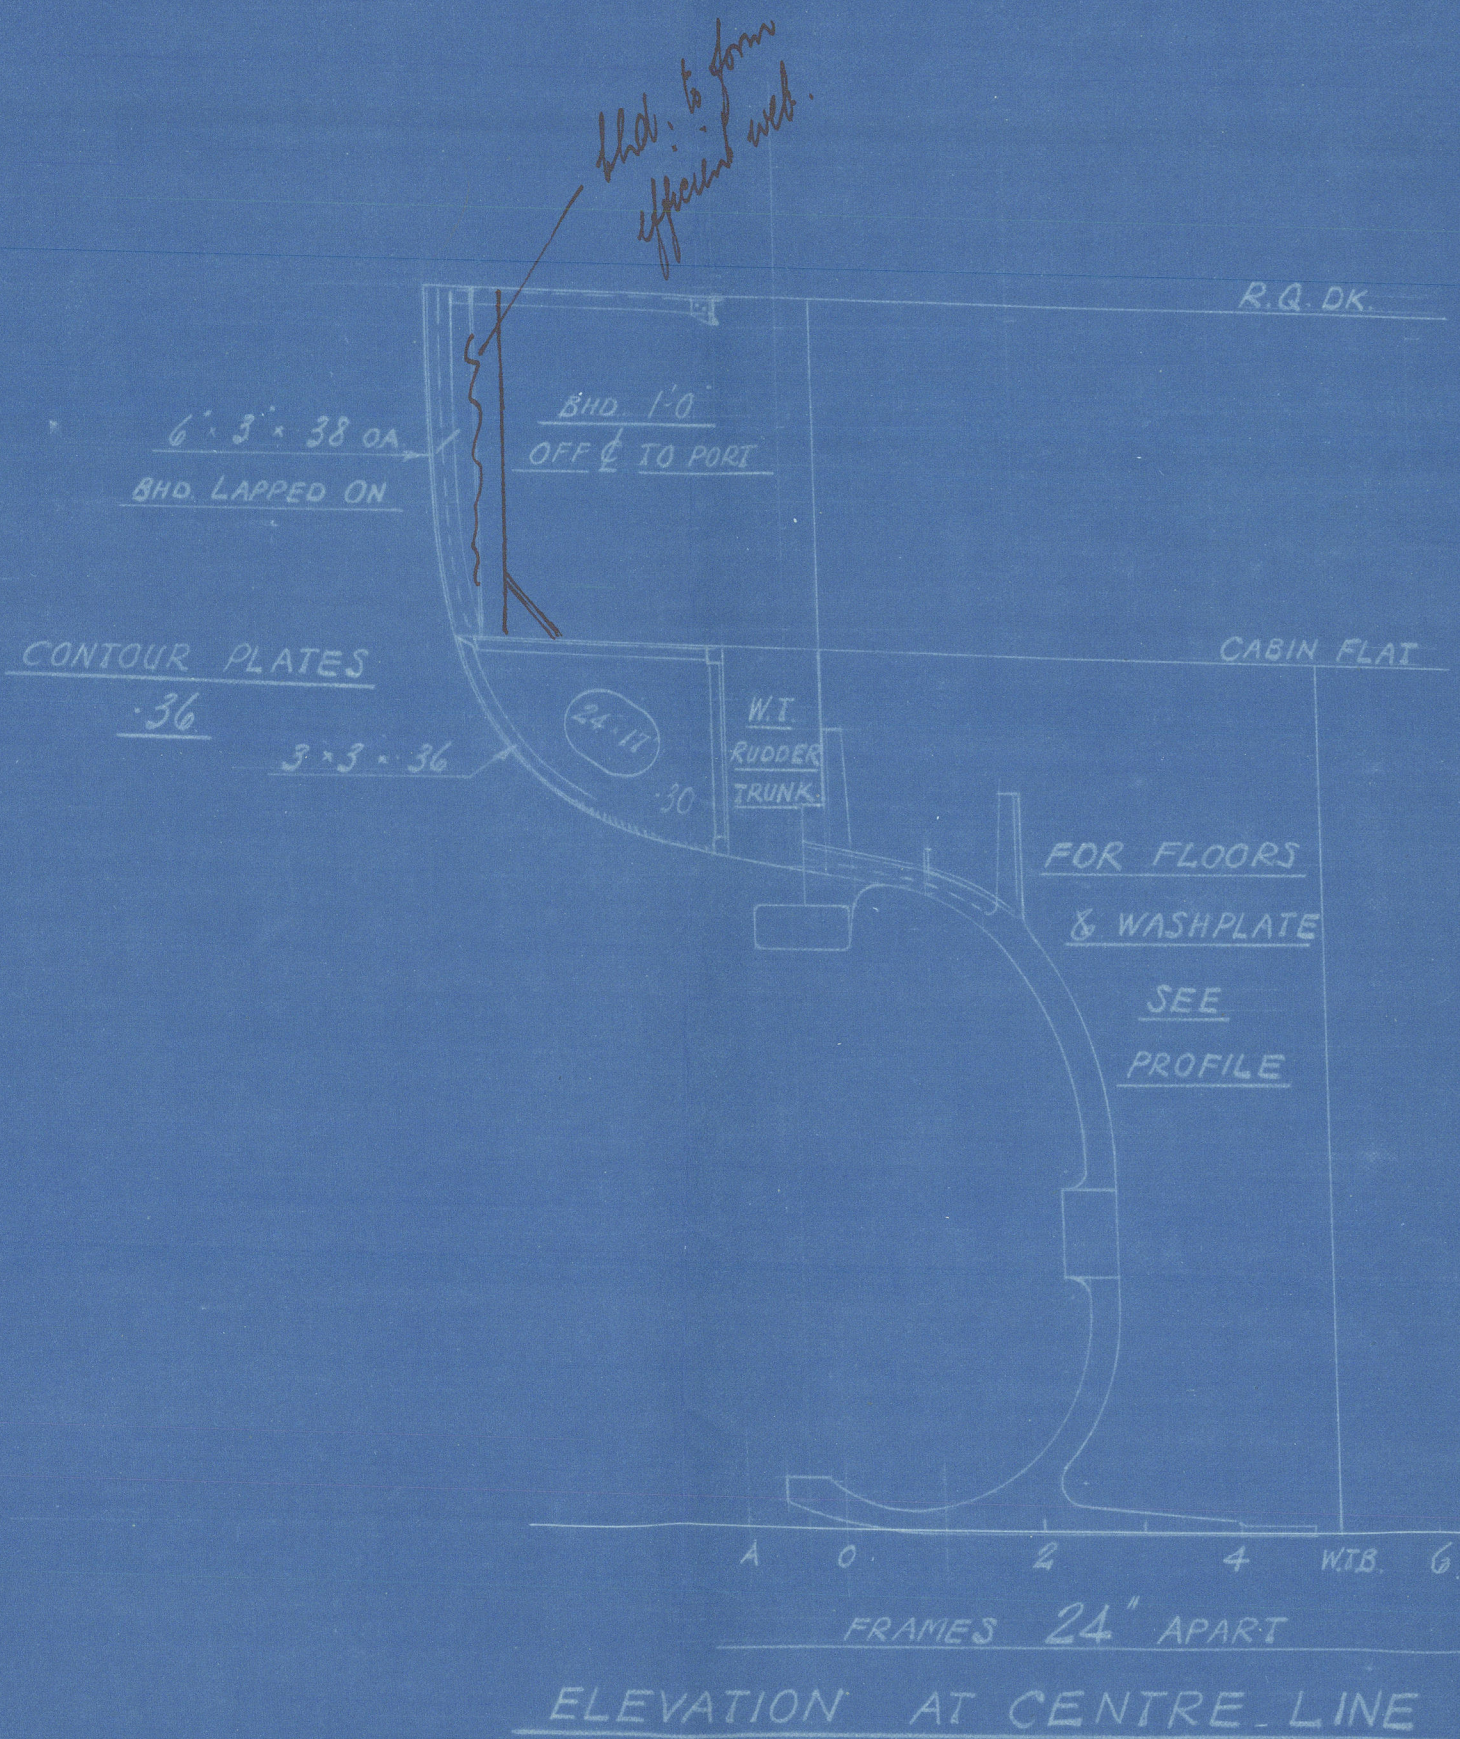

PLAN N^o P12

APPROVED
LLOYD'S REGISTER OF SHIPPING



© 2020
Lloyd's Register
Foundation

002970-002977-0029


BURNTISLAND

N^o 247

Stern framing

" S.S. TUDOR QUEEN "

Lth Report N^o 20330.

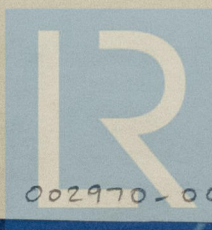

© 2020

Lloyd's Register

002970-002977-0029

Foundation