


SHIP N° 247.

MODIFICATION TO PROFILE & DECKS.

HOLD PILLARS.

SCALE:-  $\frac{1}{8}$ " = ONE FOOT.

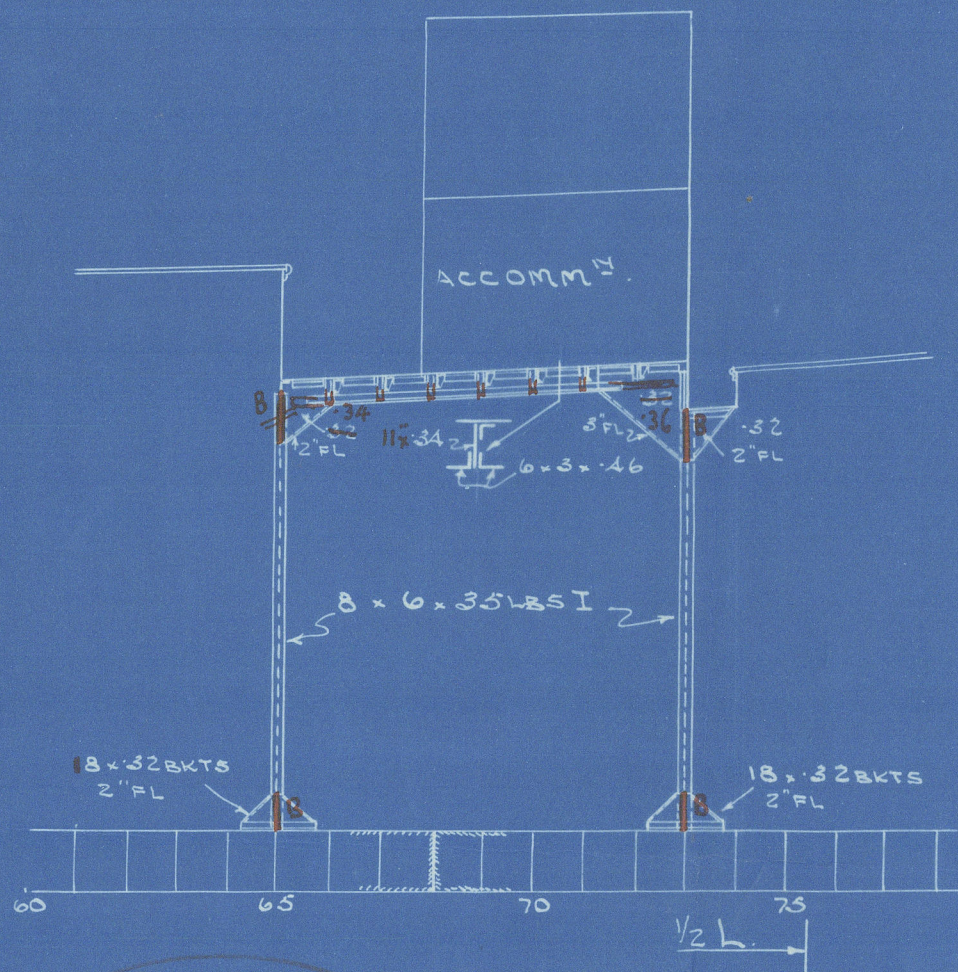

SHIP N° 247.


PLAN NO. P 10.

DESIGNED BY J. CREEVY.

CHECKED

ISSUED

DATE 20TH DEC. 1939.

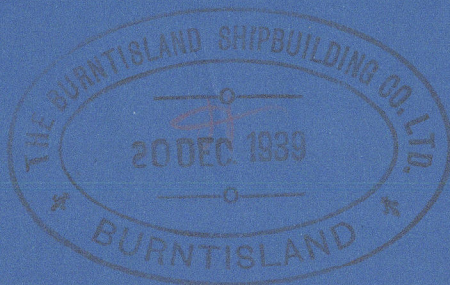

APPROVED  
LLOYD'S REGISTER OF SHIPPING  
Lloyd's Register  
Foundation  
DATE 28.12.39

002970-002977-0031



BURNTISLAND

Nº 347

Modification to  
Profile & Dicks

S.S. TUDOR QUEEN

Lth Report Nº 20330.



© 2020

Lloyd's Register  
Foundation

002970-002977-0031