
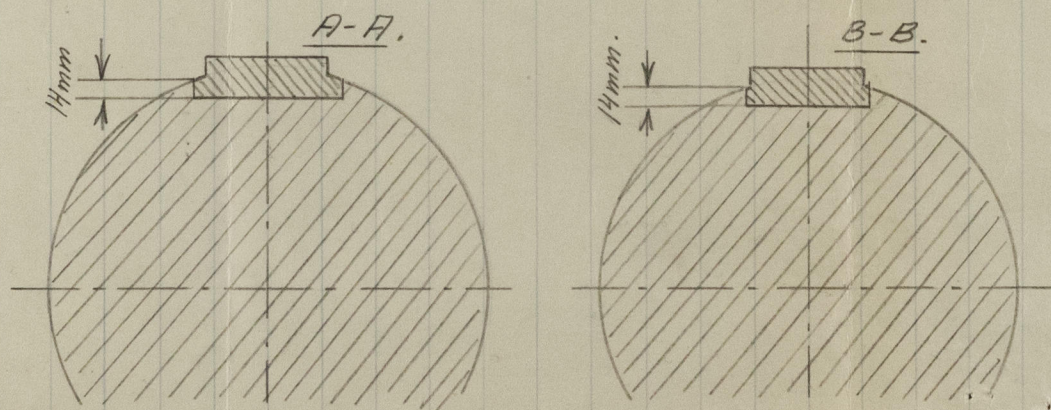


55 "Kuurtanes" of Vasa.

Repair carried out at Falborg 12/3 to 15/3-57.

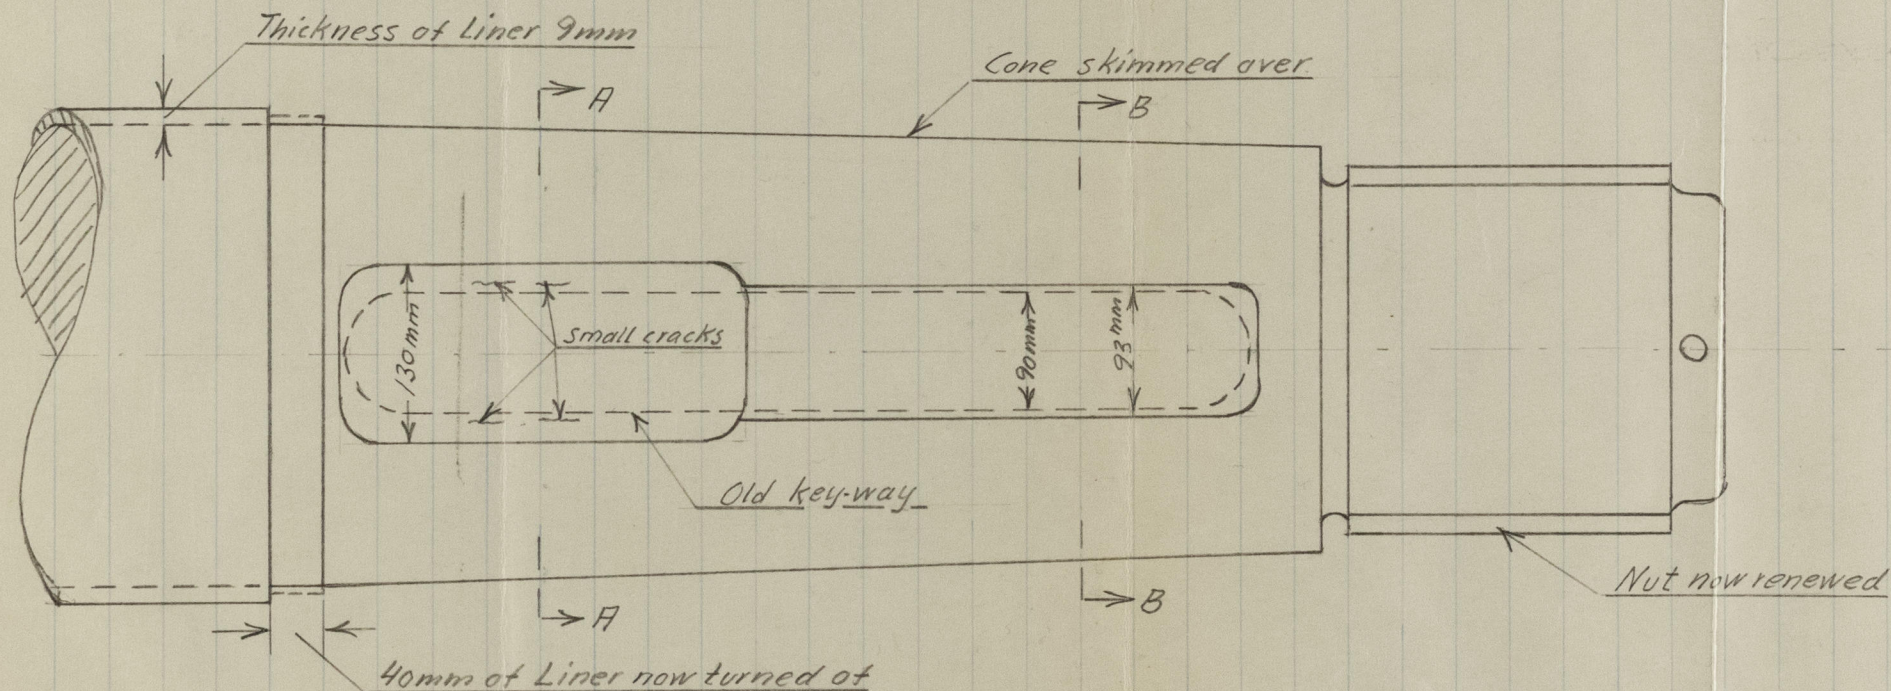

Propeller shaft stamped:

Lloyds No. 4454 ? 5-10-06.

"Kivertanes"

Repair to propeller.

Cpu. rept-No. 16274.



© 2020

Lloyd's Register
Foundation