

EQUIPMENT

1 STOCKLESS ANCHOR $9\frac{3}{4}$ CWTs
 1 Do. Do. $9\frac{1}{4}$ CWTs
 1 RODGERS ANCHOR $3\frac{3}{4}$ CWTs
 (EX STOCK)
 135 FATHOMS $1\frac{3}{16}$ " STUD LINK CABLE
 60 Do. 6" HAWSER
 60 Do. $5\frac{1}{2}$ " WARP

MIDSHIP SECTION

N^{os} 607, 8, 9 AND 10 SHIPS

DIM.:— 160'-6" B.P. x 26'-6" B.MLD. x 15'-3" DEPTH MLD.

SCALE $\frac{1}{2}$ "=1FOOT

LLOYDS NUMERALS


D.	15.25
B+D	41.75
L x D	2,447.62
L x [B+D]	6,700.87
"d"	13.67
L/D	10.52
L/B	6.05

COOK, WELTON & GEMMELL, L^{td},

SHIPBUILDERS

BEVERLEY

18.11.35

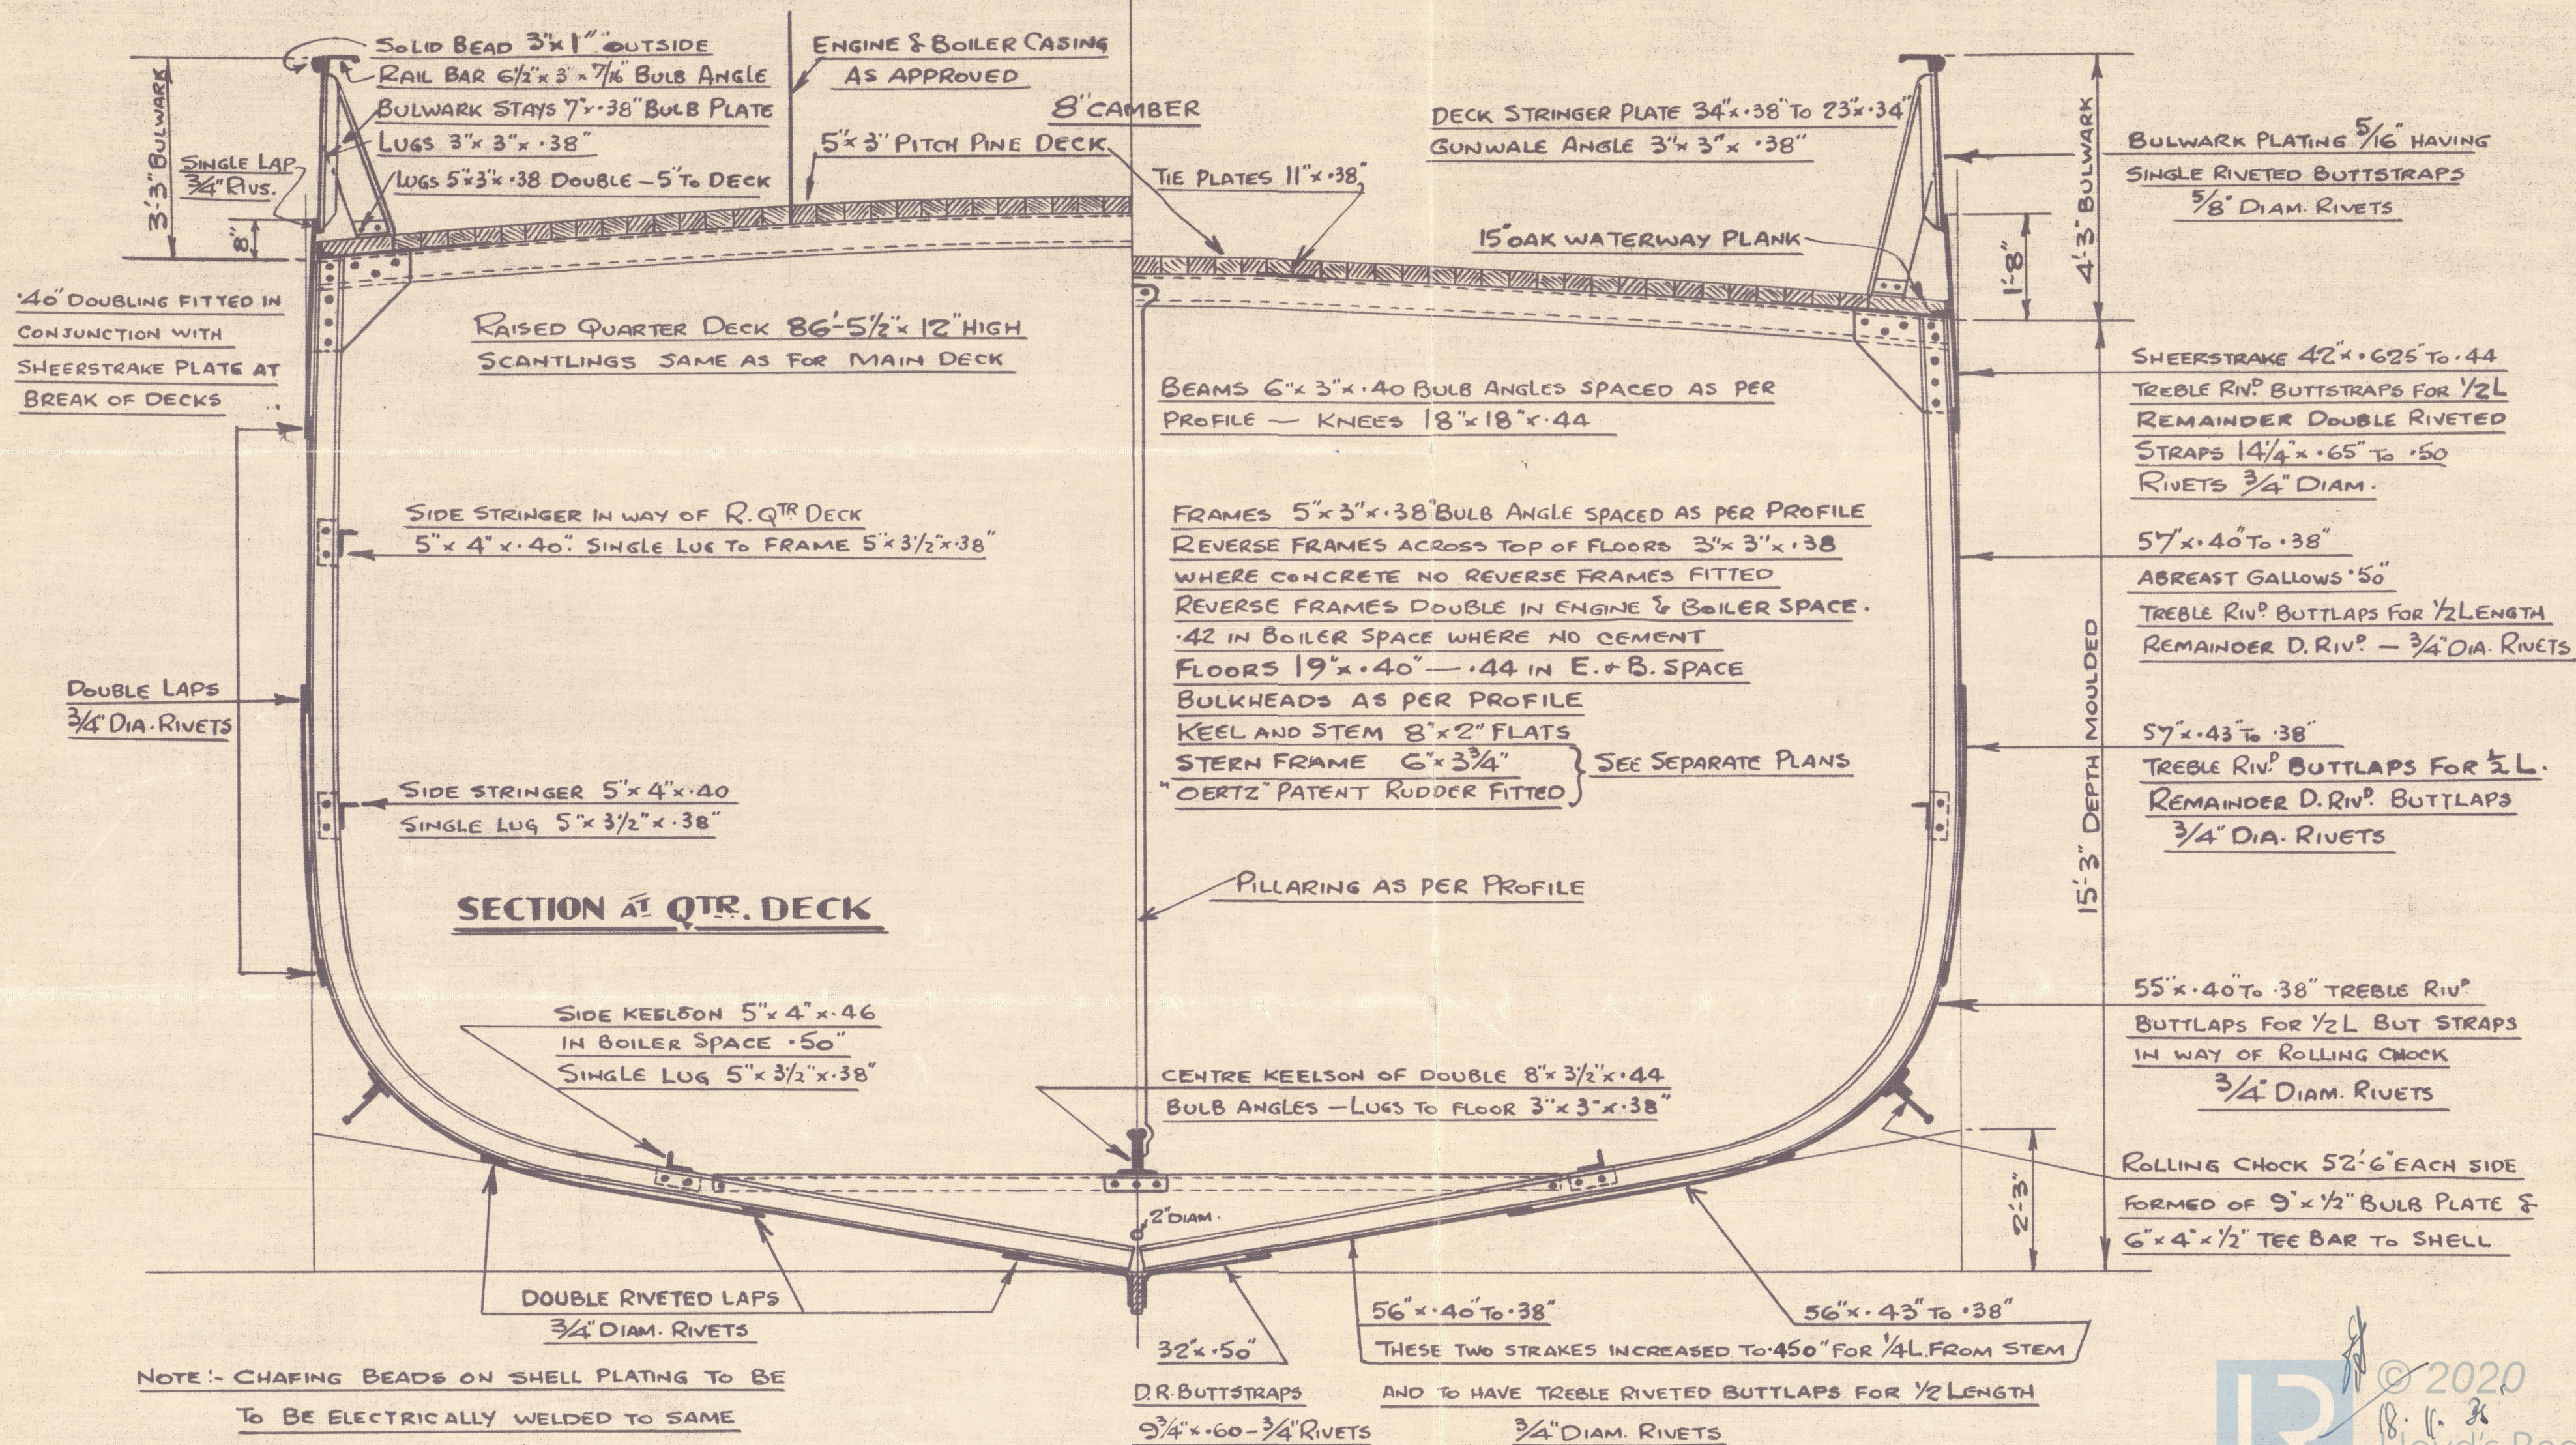

APPROVED BY LLOYDS

11-35

HULL

COOK, WELTON & GEMMELL LTD

YARD Nos 607-8-9-10

MIDSHIP SECTION.

S.S. Kingston Crystal

HULL DEPOT 46787

607 Kingston byanite *

608 Kingston coral

609 Kingston Cameo

610. Kingston Crystal.

*last entry
of argon*



© 2020

Lloyd's Register
Foundation

002970-002977-0085