

6.

For the information of Surveyors and the Committee only.

Received at

Office

19



Lloyd's Register of Shipping.

(Report on Vessel No. 43937 Port Hull)

No.

SHIP FORGINGS OR CASTINGS.

3 Cape Bathurst

I have to report that the undermentioned Iron or Steel Forgings or Castings, manufactured by Messrs J.S. Forster & son Ltd. of Sunderland for the Vessel No. 1112, being built by Messrs Cochran & son Ltd of Selly have been inspected by me as set forth below and found to be, so far as can be seen, Sound.

on Forgings or Castings.


Lloyd's
No. 6822
JD. 20.4.33

X

*J Dale
Sunderland*

	STERN FRAME.	RUDDER FRAME.	STEM.
Material*	<i>Scrap iron</i>		
How made	<i>Forged & smithed</i>		
Annealed			
Dimensions	<i>6 x 3 1/2 - 7 3/4 x 3 1/2</i>		
Progress on Inspection	<i>Forging & Smithing</i>		
Date when Inspected	<i>20.4.33</i>		
CASTINGS.			
Tests on Standard Test Pieces.			
Wedge Test—			
Tons per square inch			
Extension per cent.			
Charpy Bending Test—			
Angle before fracture			
Drop Test—			
Height from ground			
Hammering Test—			
If made according to Rules and found satisfactory ...			

SKETCHES OF FRAMES SHOWING POSITION AND DESCRIPTION OF WELDS OF FORGINGS.

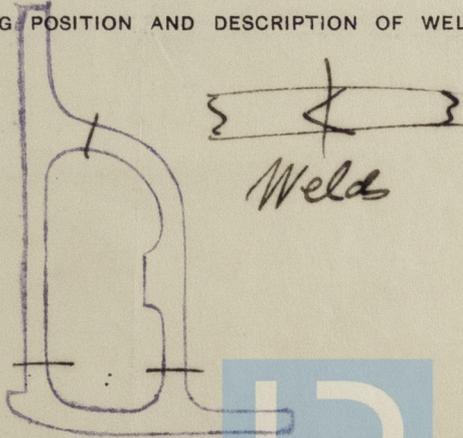

Fee (if any chargeable) £

To be paid at

© 2020

If of Iron, state whether scrap or puddled Iron. If of Steel, state whether made on the Open Hearth process.

29. T.

002970-002977-0172

