

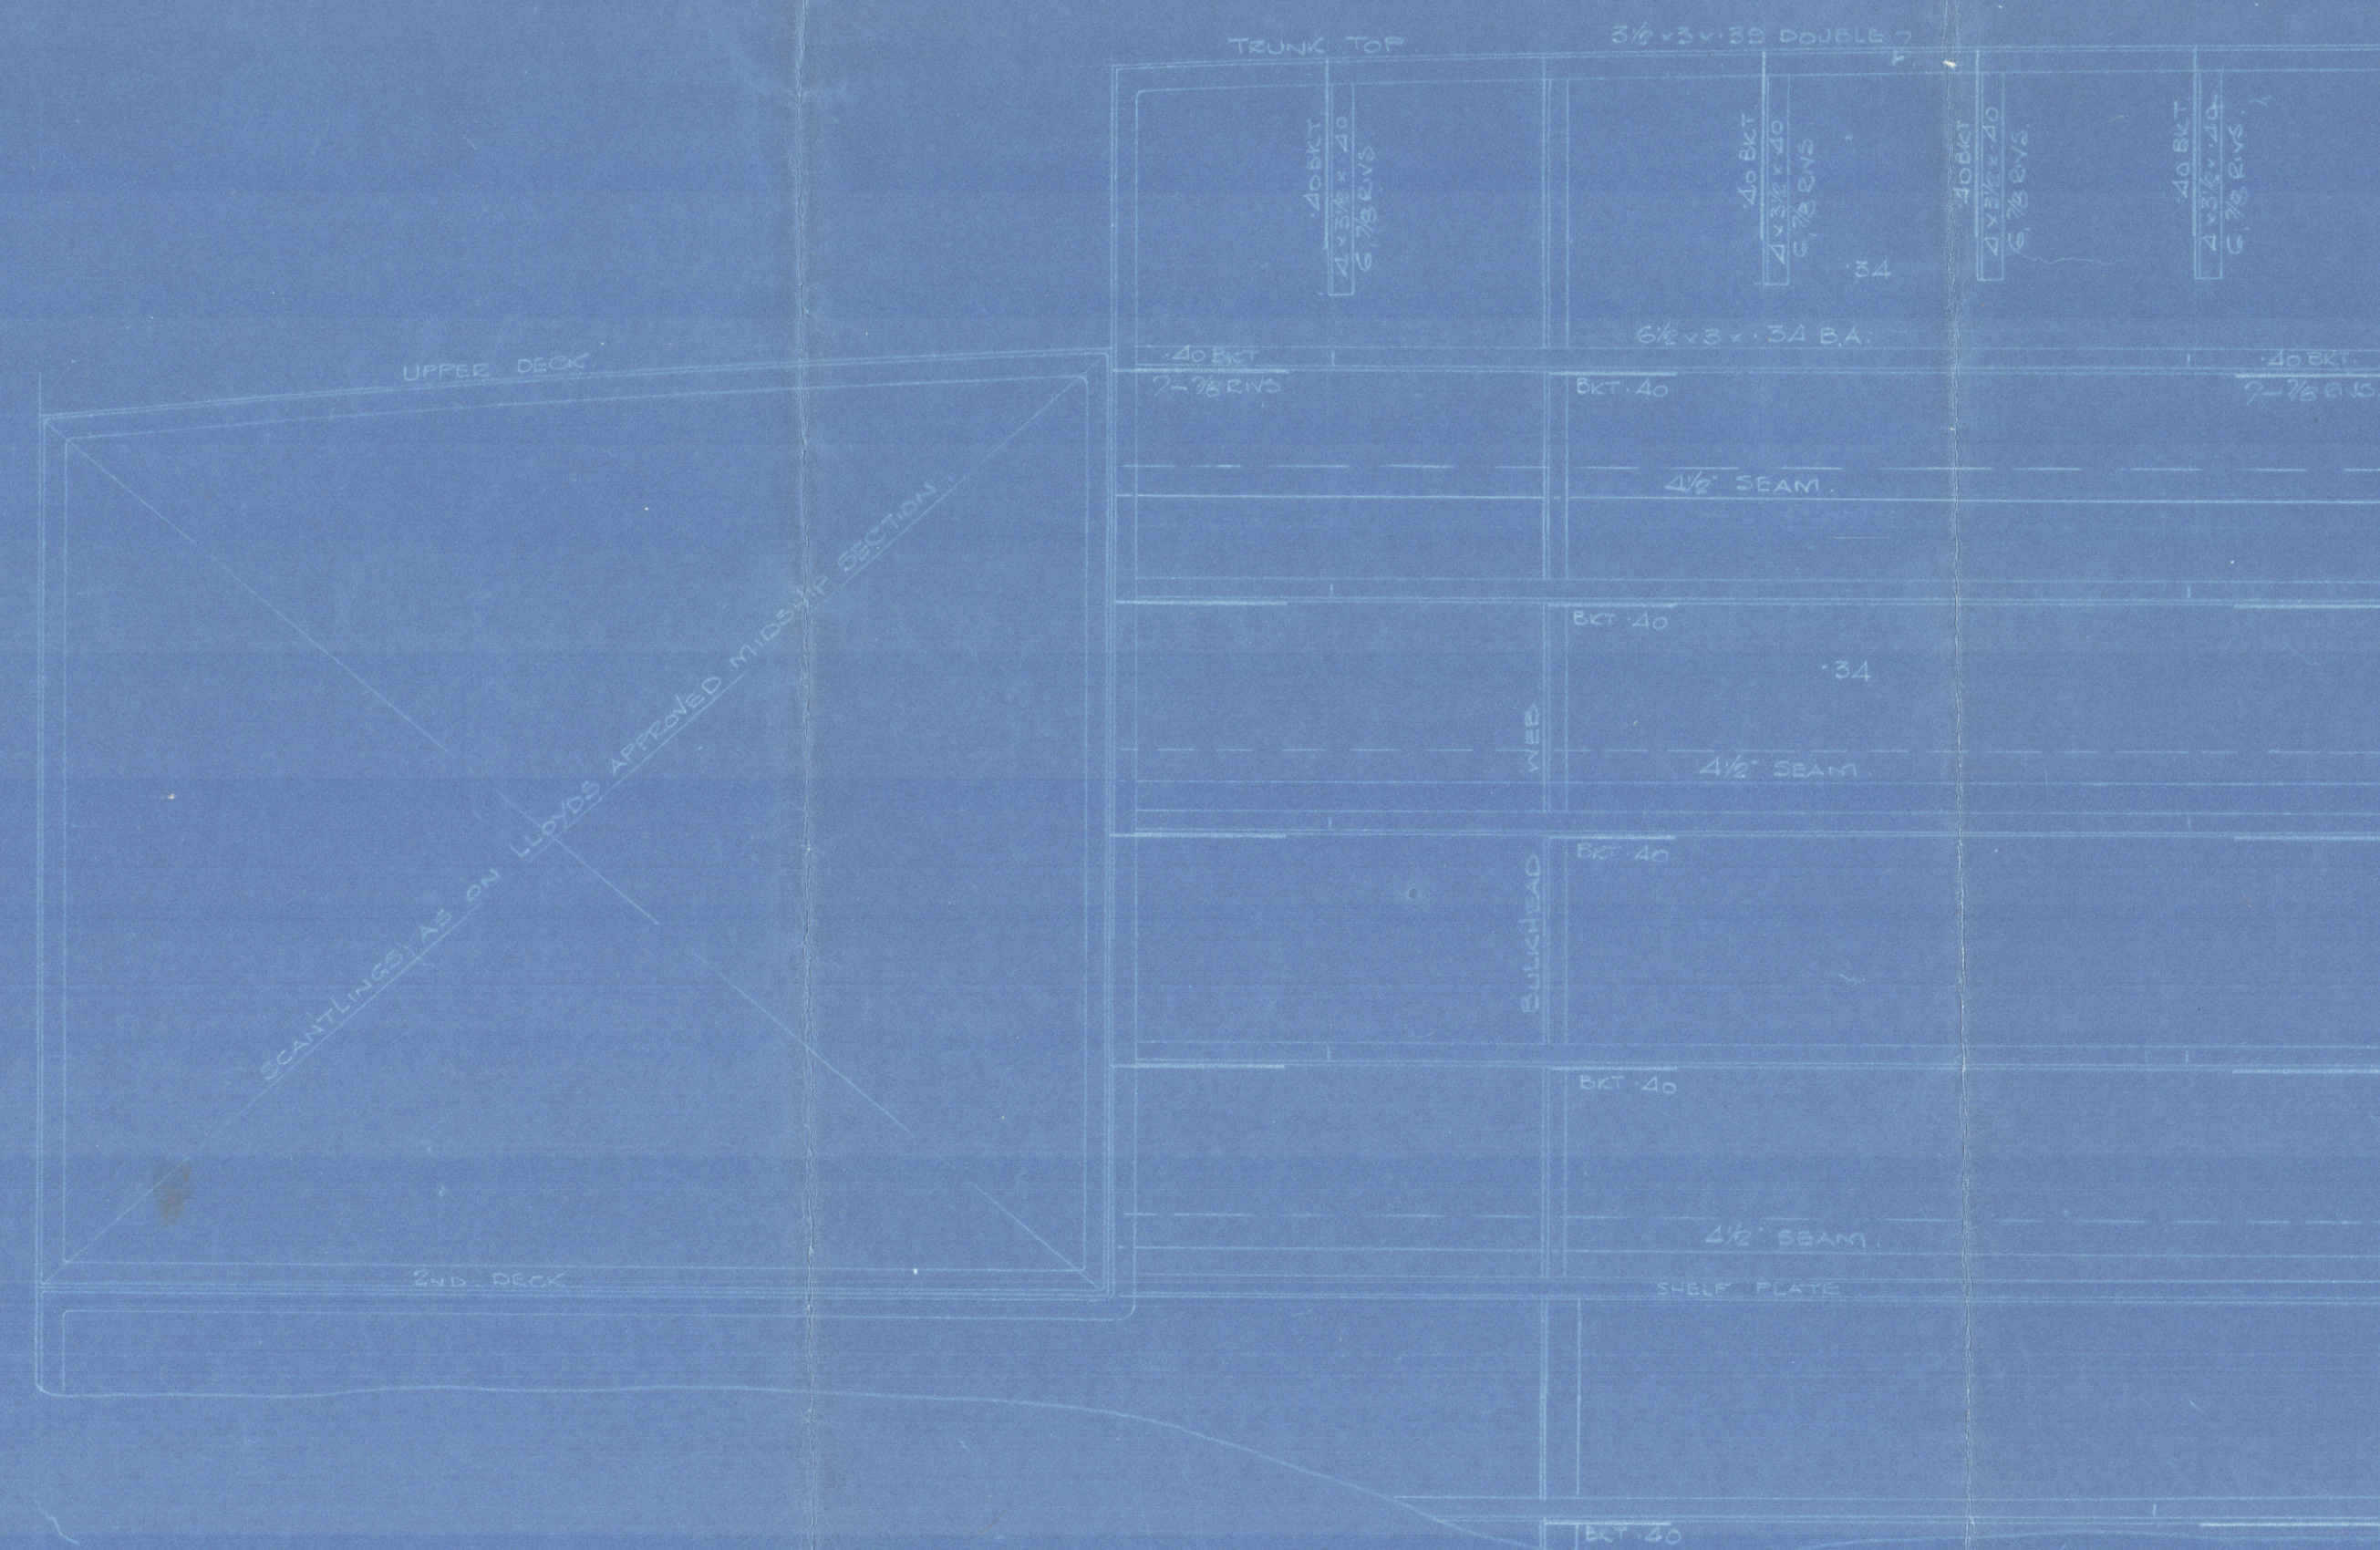


N<sup>o</sup> 1057, 61, 23 & 4 SHIPS  
— MIDSHIP SECTION —  
PLAN SHOWING AMENDMENTS DUE TO TRUNK ON DECK

SCALE  $\frac{1}{2}$ " = 1 FOOT

NOTE — ANY SCANTLINGS NOT SHOWN ARE TO BE AS  
ON LLOYDS APPROVED MIDSHIP SECTION N<sup>o</sup> 1058 SHIP

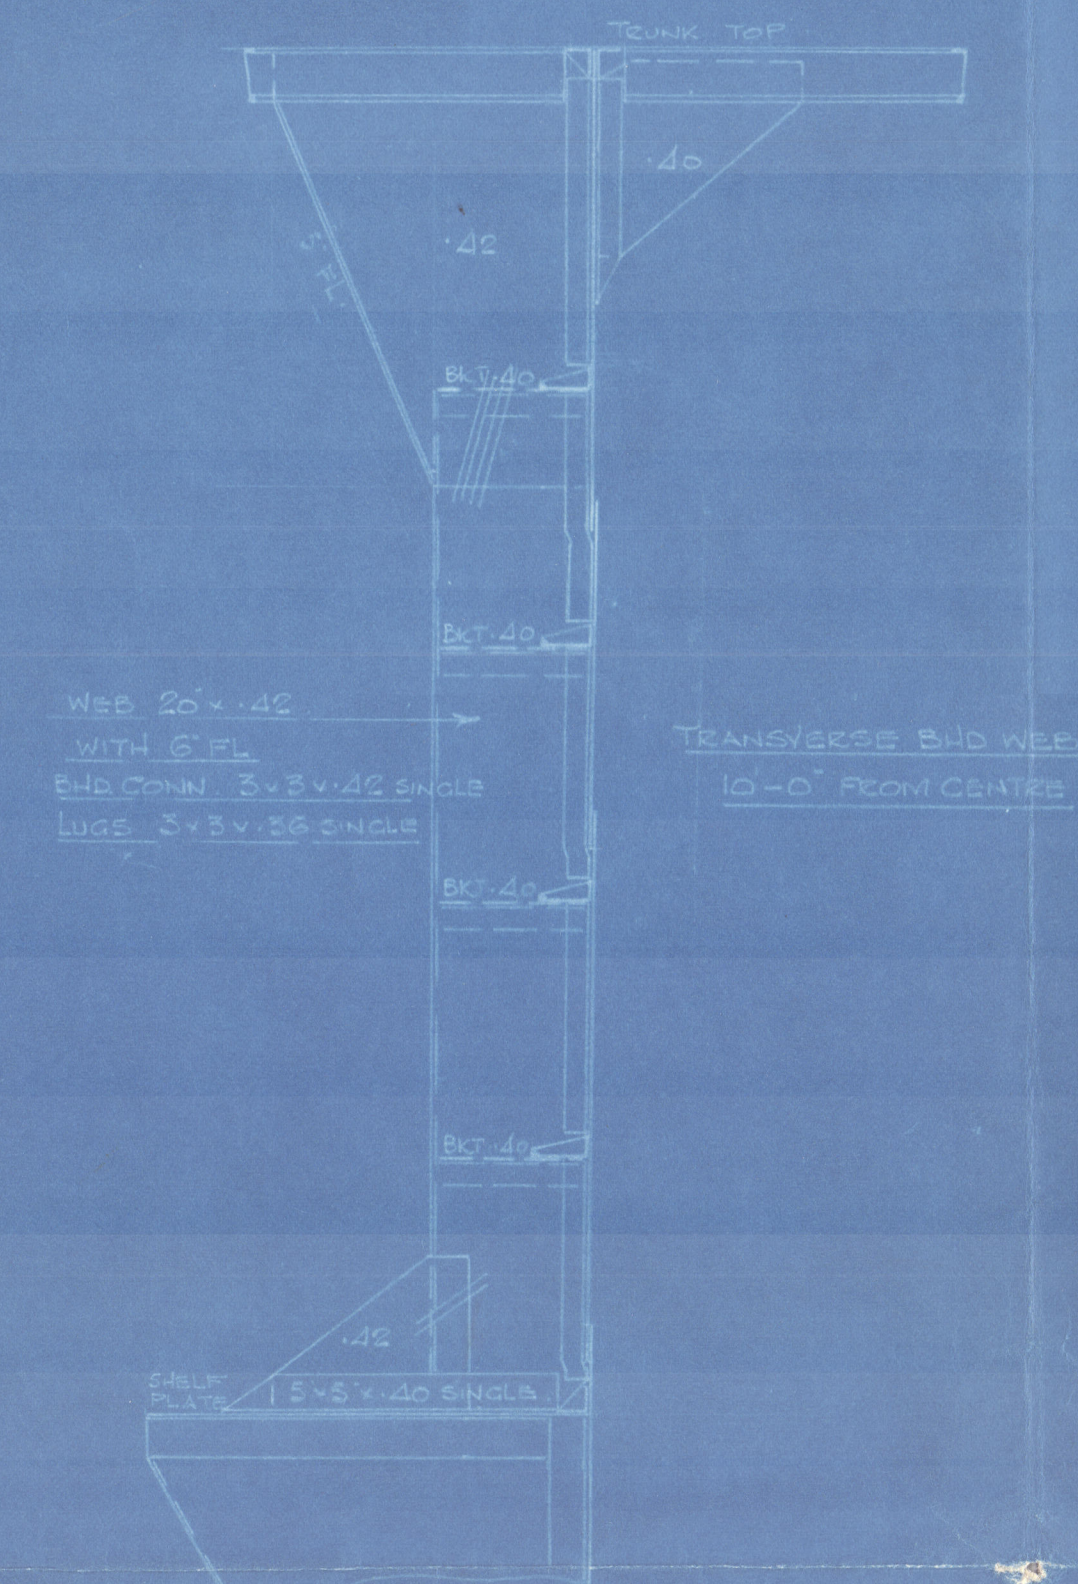

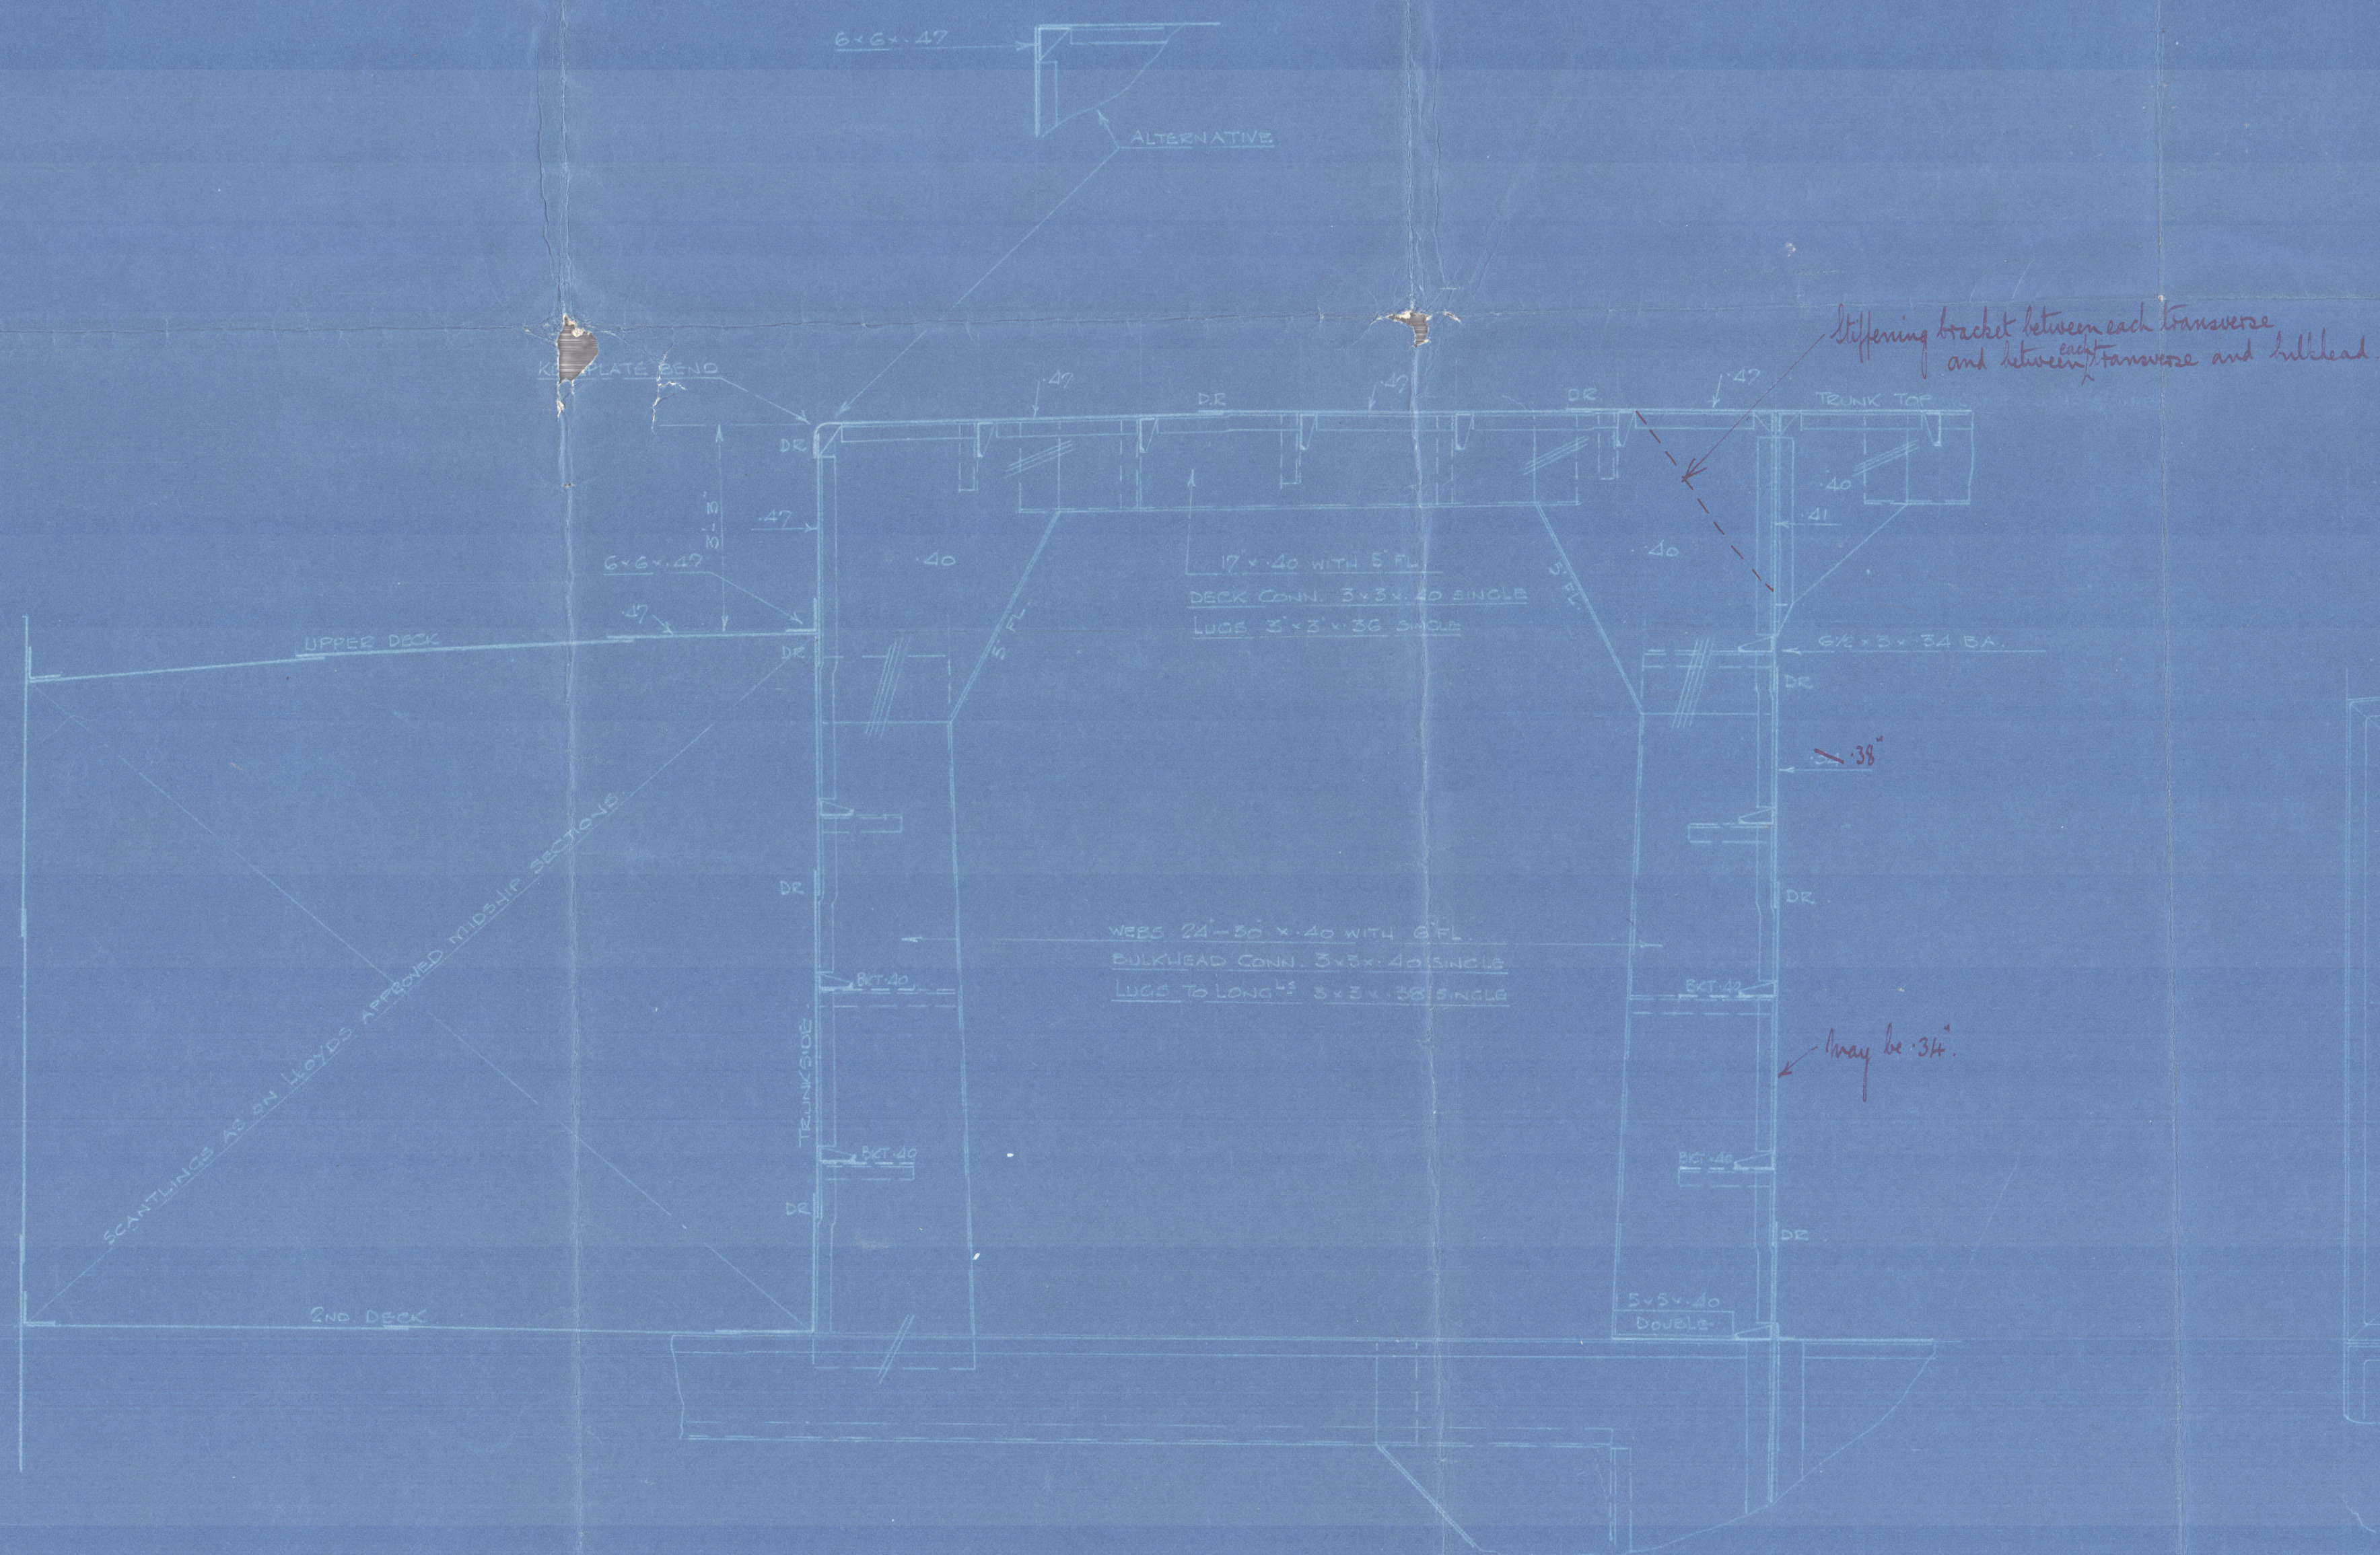

8.

Six u.s. Armstrong, whitewashed p.c.s

Nos 1057. 61. 62. 63. 64

Missip Section Showing Tank on  
deck, added.

1069 -

M.V. "ASHMORE"

NEWCASTLE ON TYNE.

Report No.

File with

1057. Reik

Inc. 86253.  
NN Galna X.

AINO



© 2020

Lloyd's Register  
Foundation

002970-002977-0188