


25.702

S.S. No 286

CAST STEEL STERN FRAME.

SCALE 1/2" = 1 FOOT.


NUMERAL 17393.

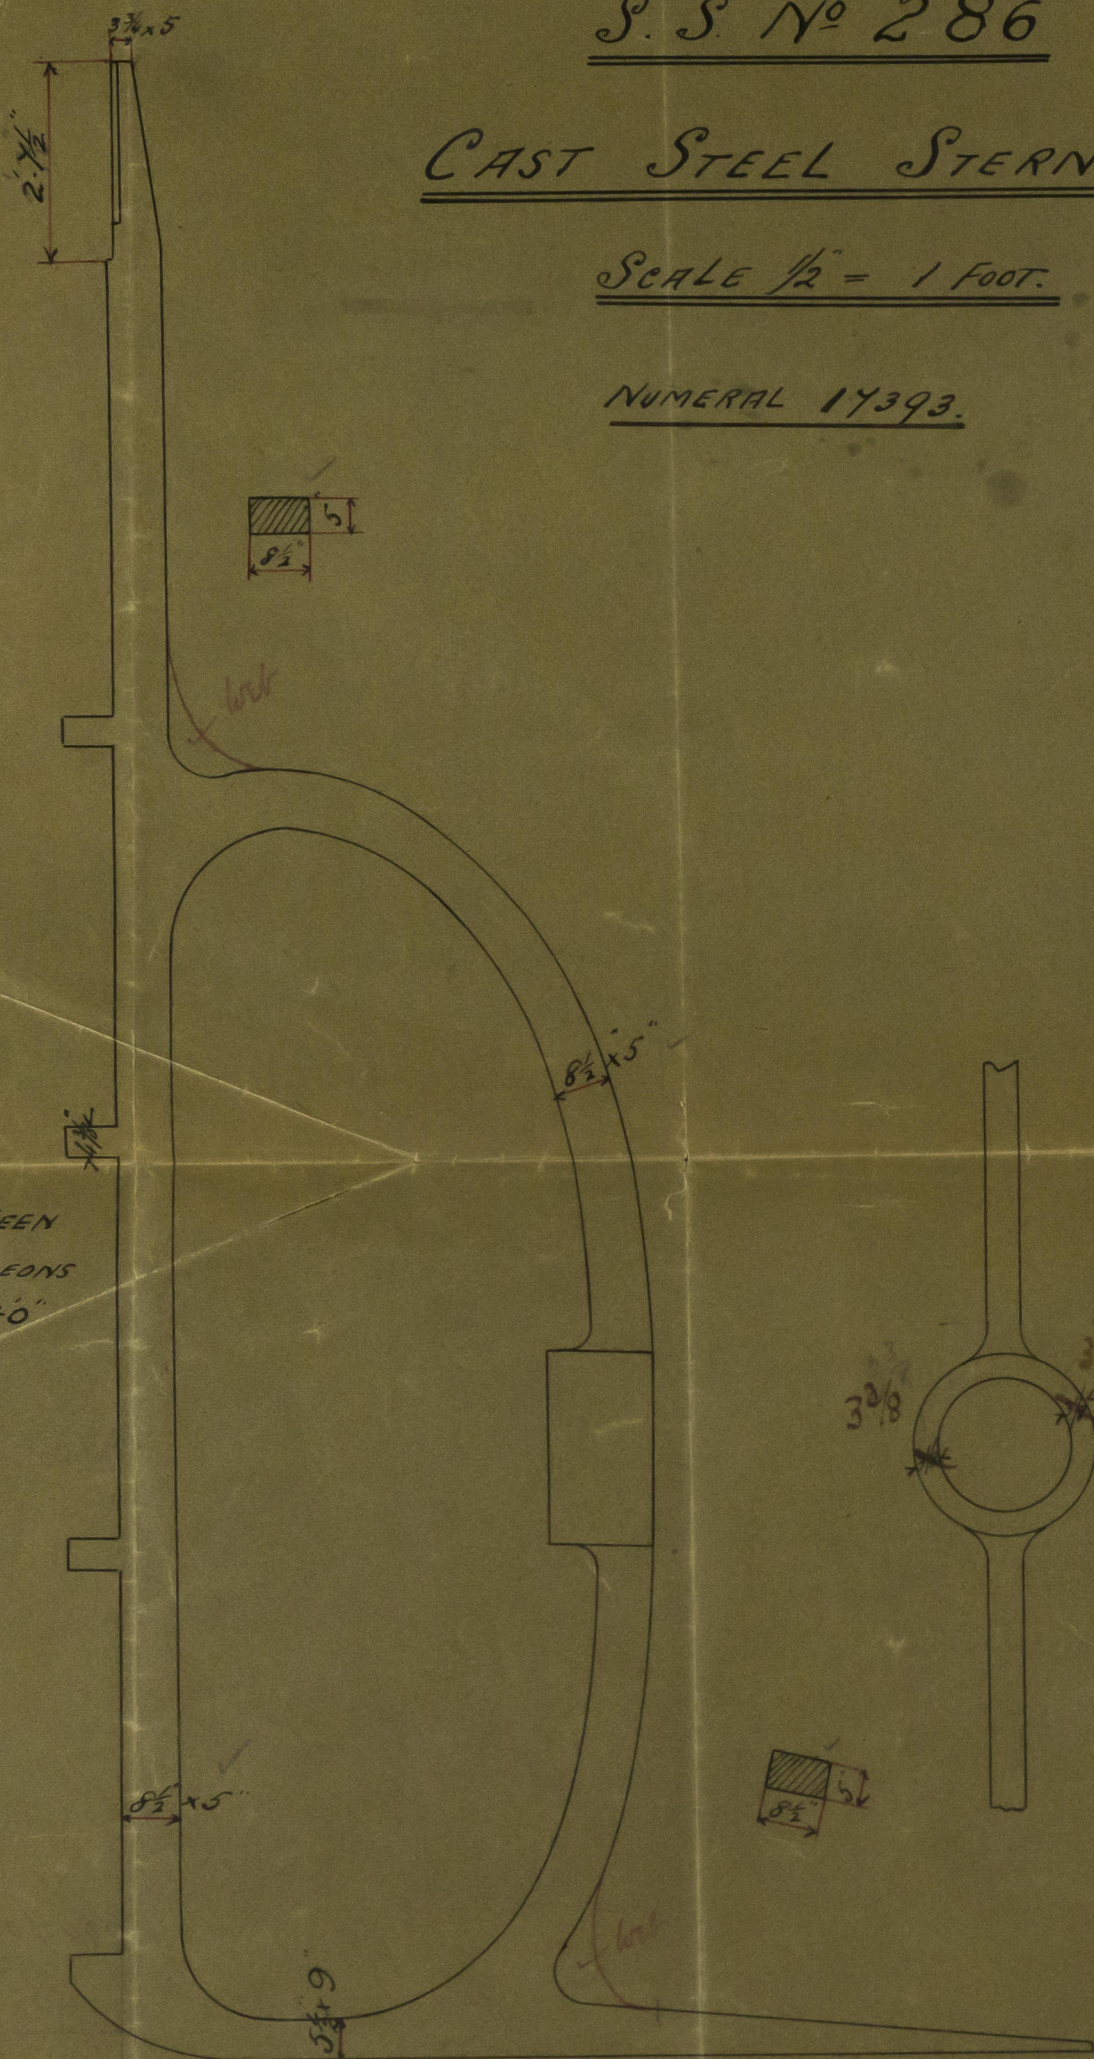

DISTANCE BETWEEN  
CENTRES OF GUDGEONS  
NOT TO EXCEED 5'-0"

Stern post if Scarphed  
Length of Scarph 2-1/2  
Breadth 1-0/4  
4 Rows of Rivets

DRAWN BY B.V.  
CHECKED BY H.B.

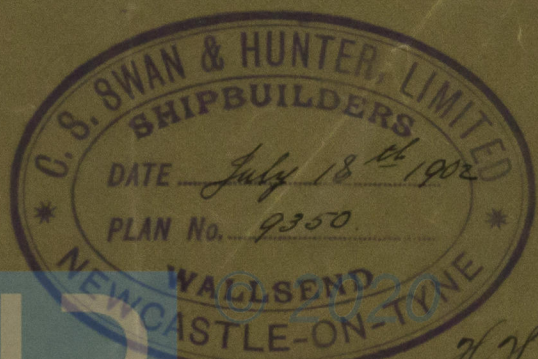

Lloyd's Register  
Foundation

00278-002988-0002




Swan & Hunter  
No 286  
C.S. Sternframe.

J.F. Camopus  
Newcastle Report  
No 45348

002978-002988-0002


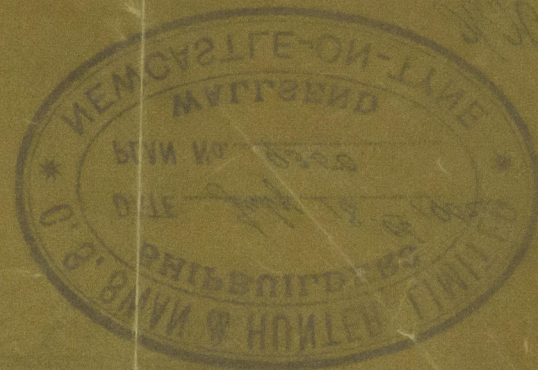

CHECKED BY  
DRAWN BY



© 2020  
Lloyd's Register  
Foundation