


28.8.02
30.8.02
16.9.02

— S.S. NO 286 —

— PROFILE & DECK PLANS —

— SCALE $\frac{1}{8}$ " = ONE FOOT —

— 250' x 35'2" x 18'5" M.L.D. —

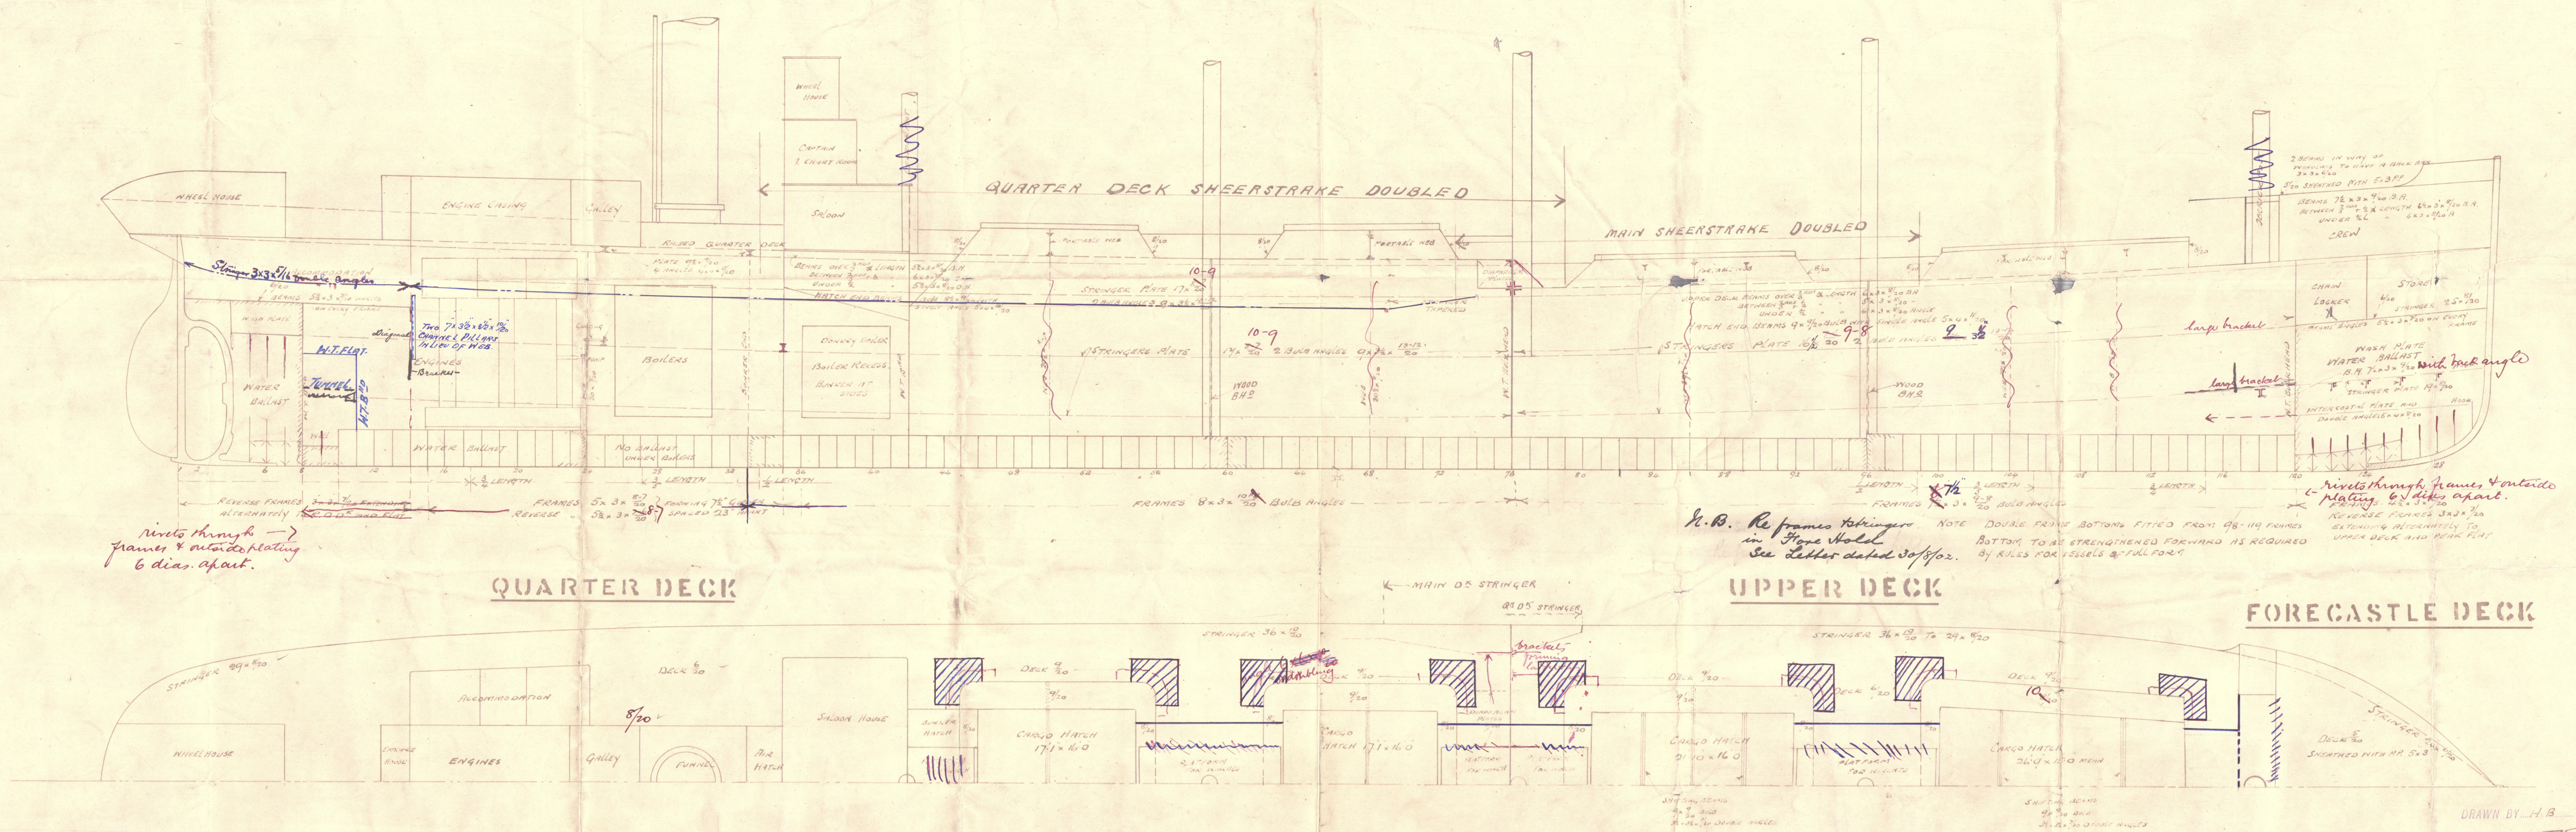

C. S. SWAN & HUNTER LTD.,

SHIPBUILDERS,


WALLSEND ON TYNE.

DRAWN BY H.B.
CHECKED BY T.O.




Swan & Hunters
S/S. No. 286.

Profile & Deck Plans

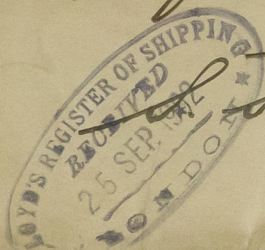

~~S. Canopus~~

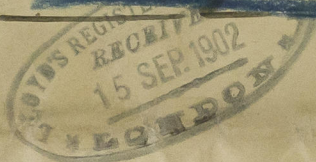


Newcastle Report

N^o 145348

5

D. 5-13.

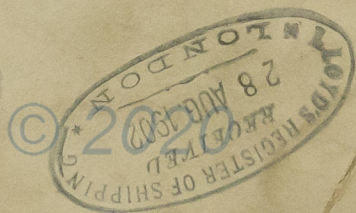

Lloyd's Register
Foundation

002978-002988-0003