

21.7.12
6.3.12
1.4.12
16.5.12




No 350 PROFILE & DECK PLANS

TO GLASS 100 A.I. AT LLOYDS ANKING DECK
DIMENSIONS 28' 0" x 38' 4" MID x 26' 0" TO ANK DK, 12' 3" TO UPPER DECK
SCALE 1/8" = 1 FOOT




THE SCANTLINES SHOWN ARE TO BE THE MINIMUM, ANY REDUCTIONS TO BE INDICATED ON PLAN
ERRORS & OMISSIONS EXCEPTED

8/2/12

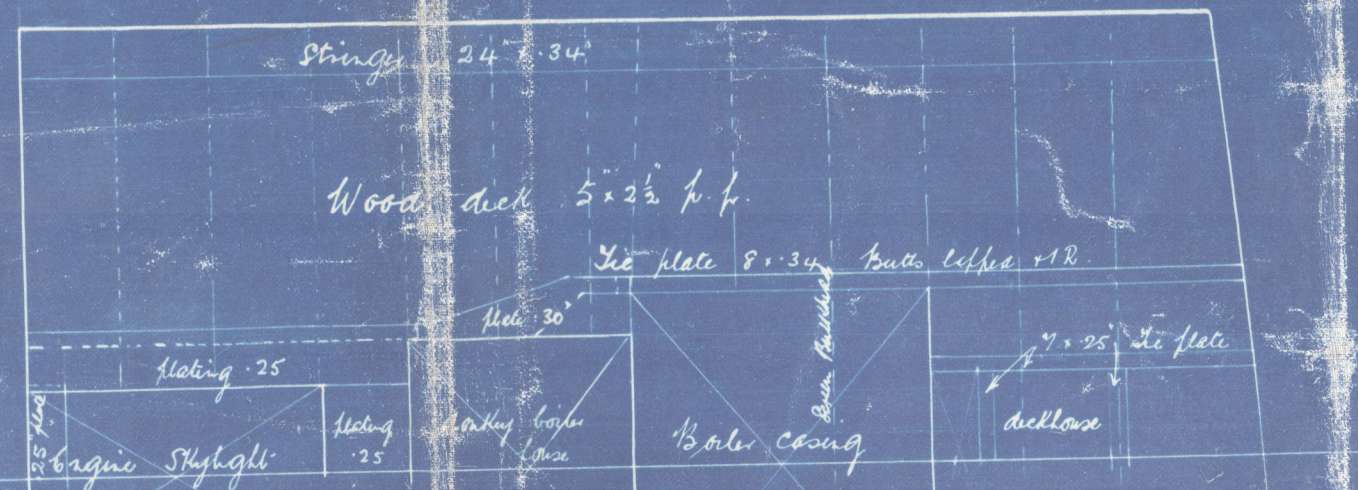

Upper deck
Beams 5 1/2 x 5 x 40 agts




1/4" web frames and partial bulkheads
to upper lower deck in line of every
full angle frame carried up to anking deck

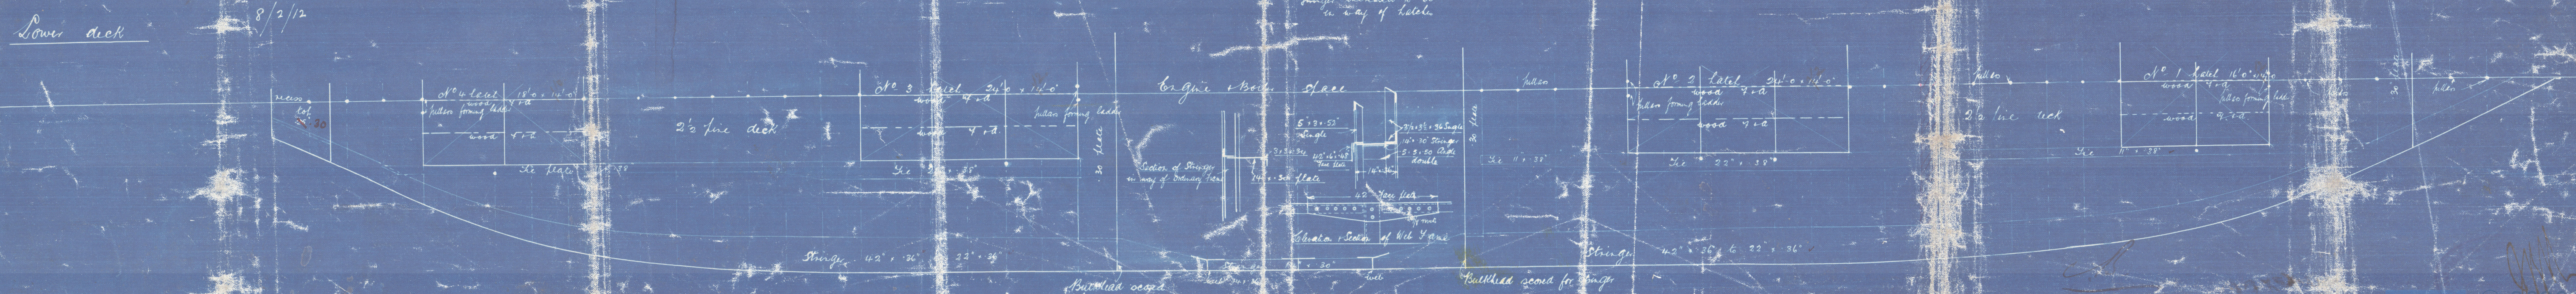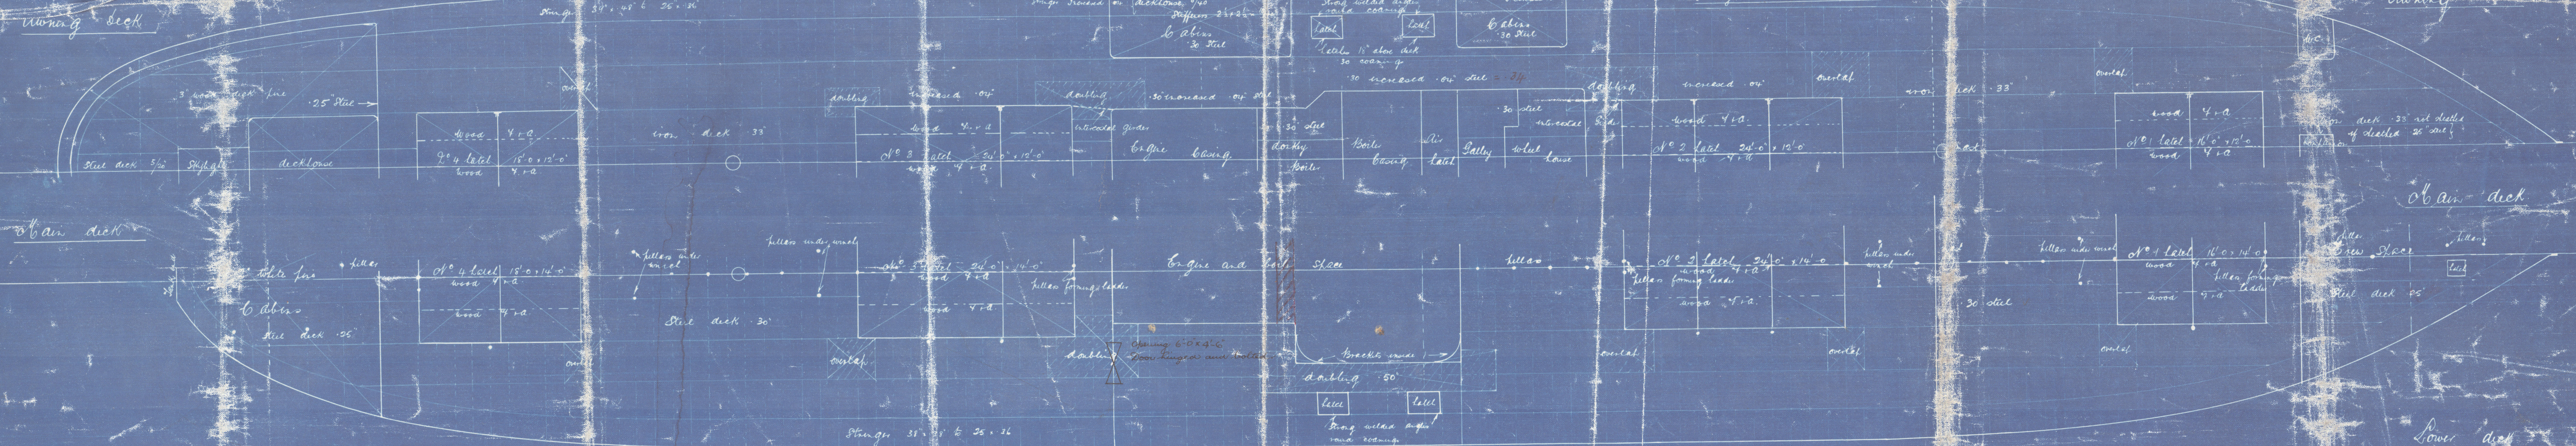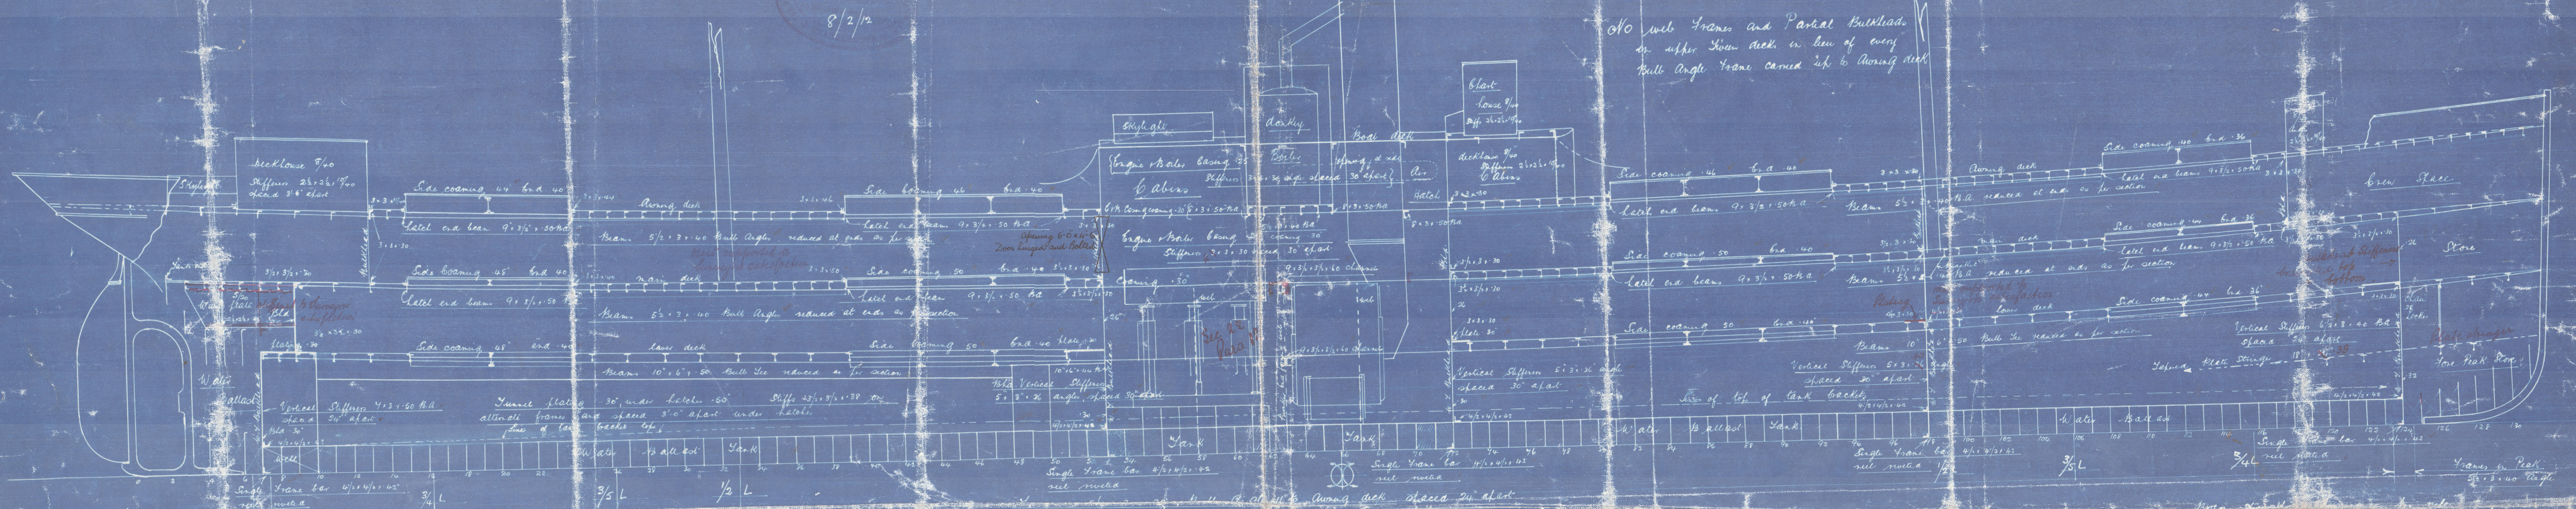

8/8 "Cabo Menor" Lth 13816
No. 350.

Amended Profile Plan.

The Greenock & Grangemouth
Dockyard Coy., Ltd.
Grangemouth.

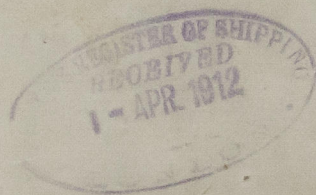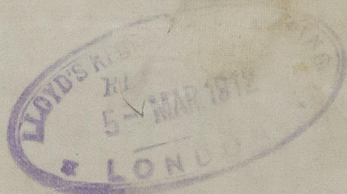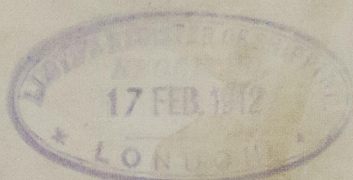

RETAIN



© 2020

Lloyd's Register
Foundation

002978-002988-0025