


PROFILE FOR BUILD. № 546.

SCALE : $\frac{1}{4}" = 1'-0"$

BREADTH MOULDED 34'-6"

TO BE BUILT TO "THE BRITISH CORPORATION" B5 * ✓

TYPE: SINGLE DECK VESSEL WITH DISCONNECTED POOP & FORECASTLE.

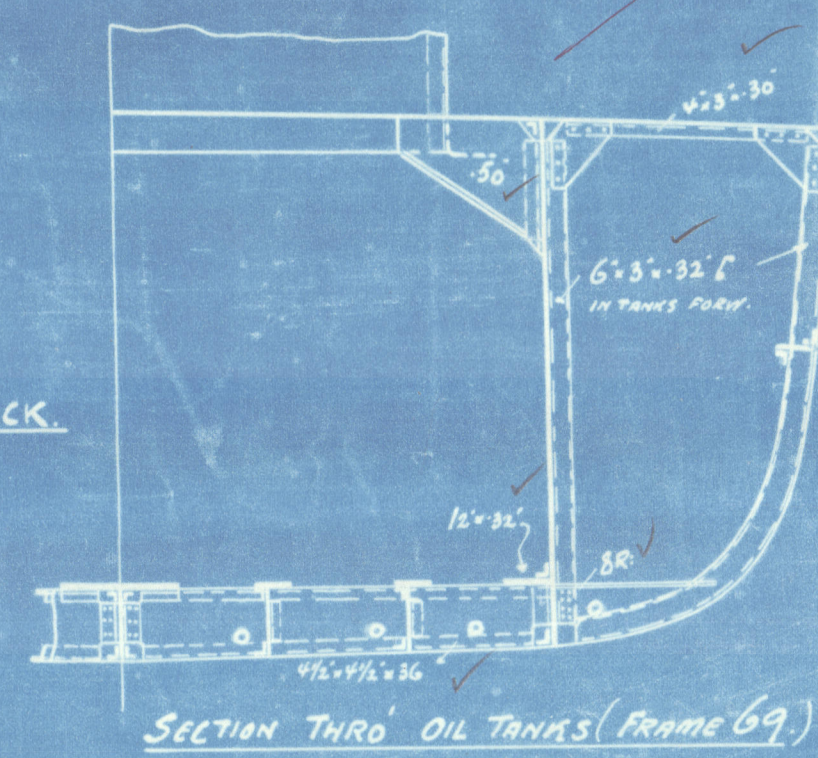

E. P. Boudreau
MAIN DECK

AKTIESSCHABET
BURMEISTER & WAISS
PROFILE

8

And. Profile & Deck

Burmeister & Wain

546.

Bag

ET MOR

27-10-27

"Melingar"^{EX}

002978-002983-0069



© 2020

Lloyd's Register
Foundation