
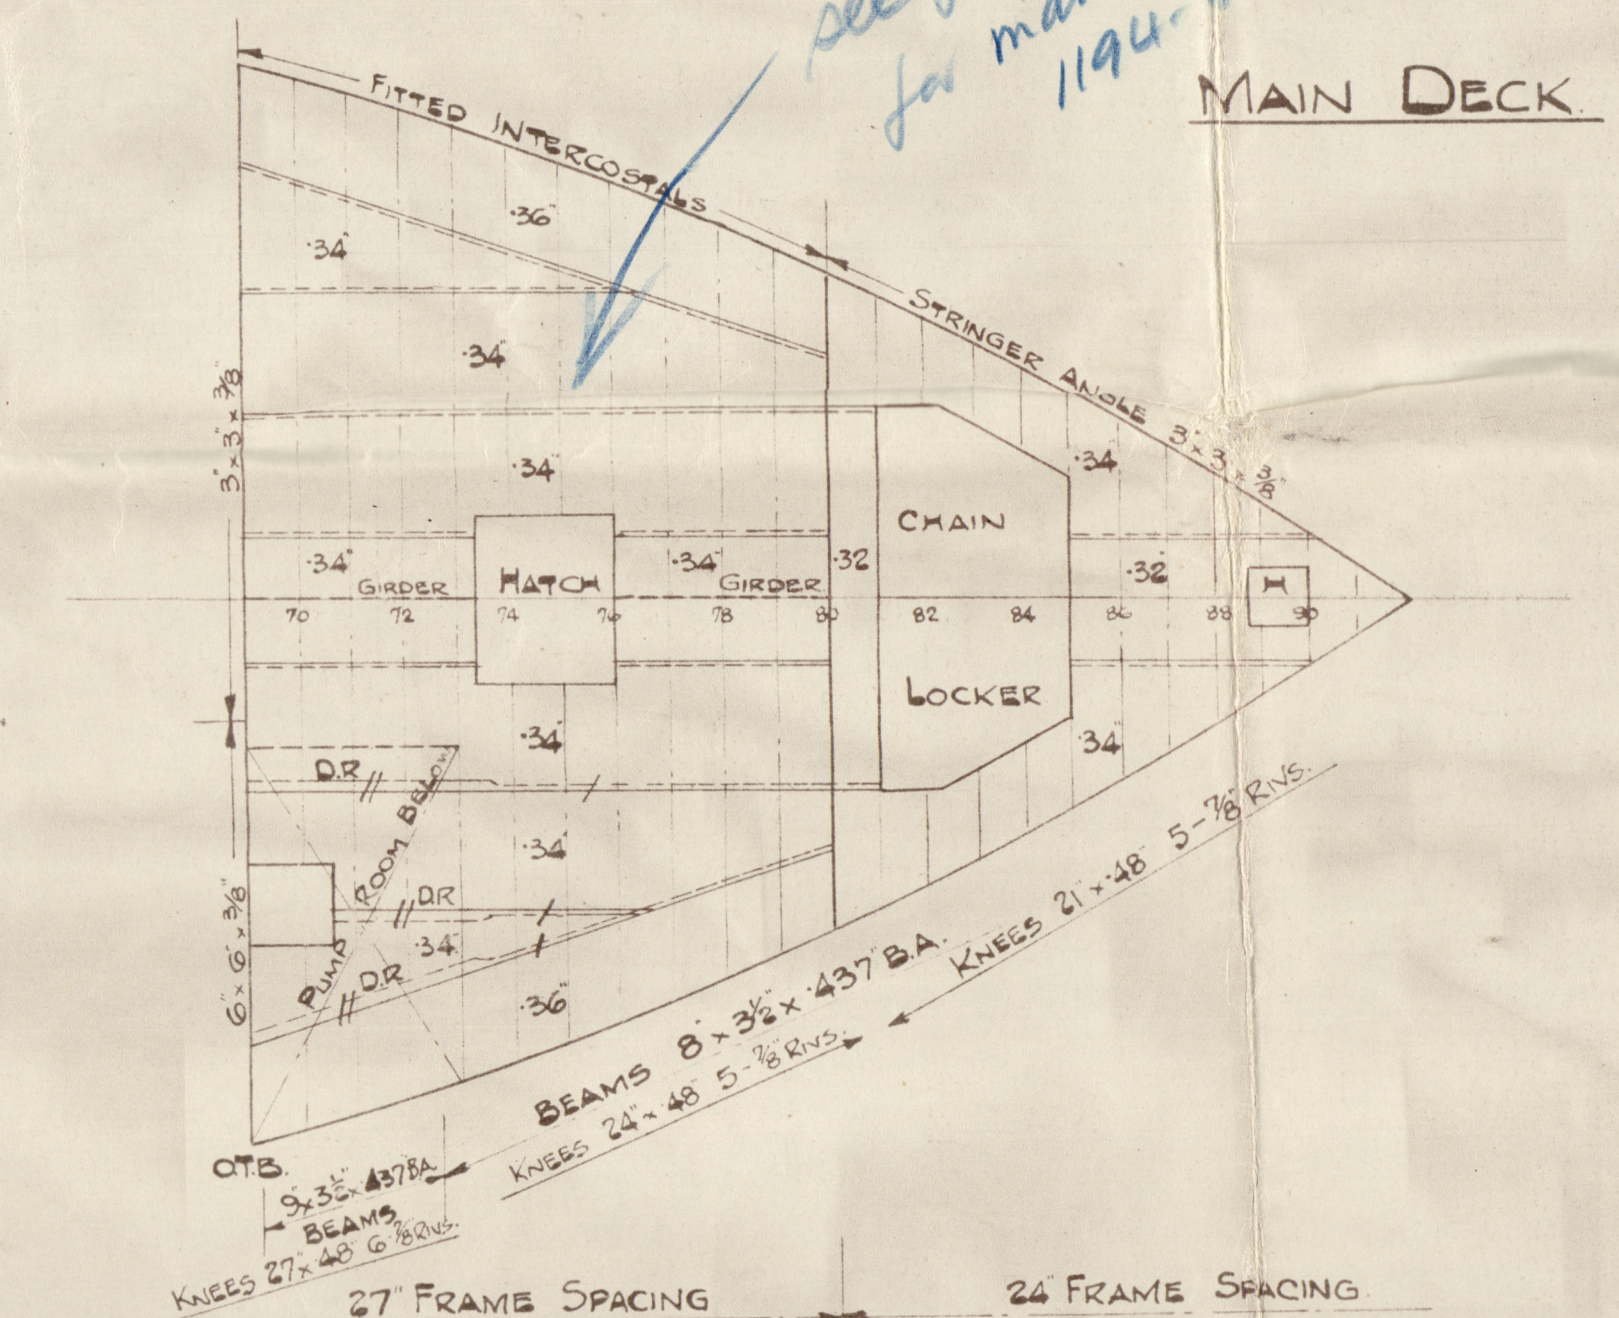
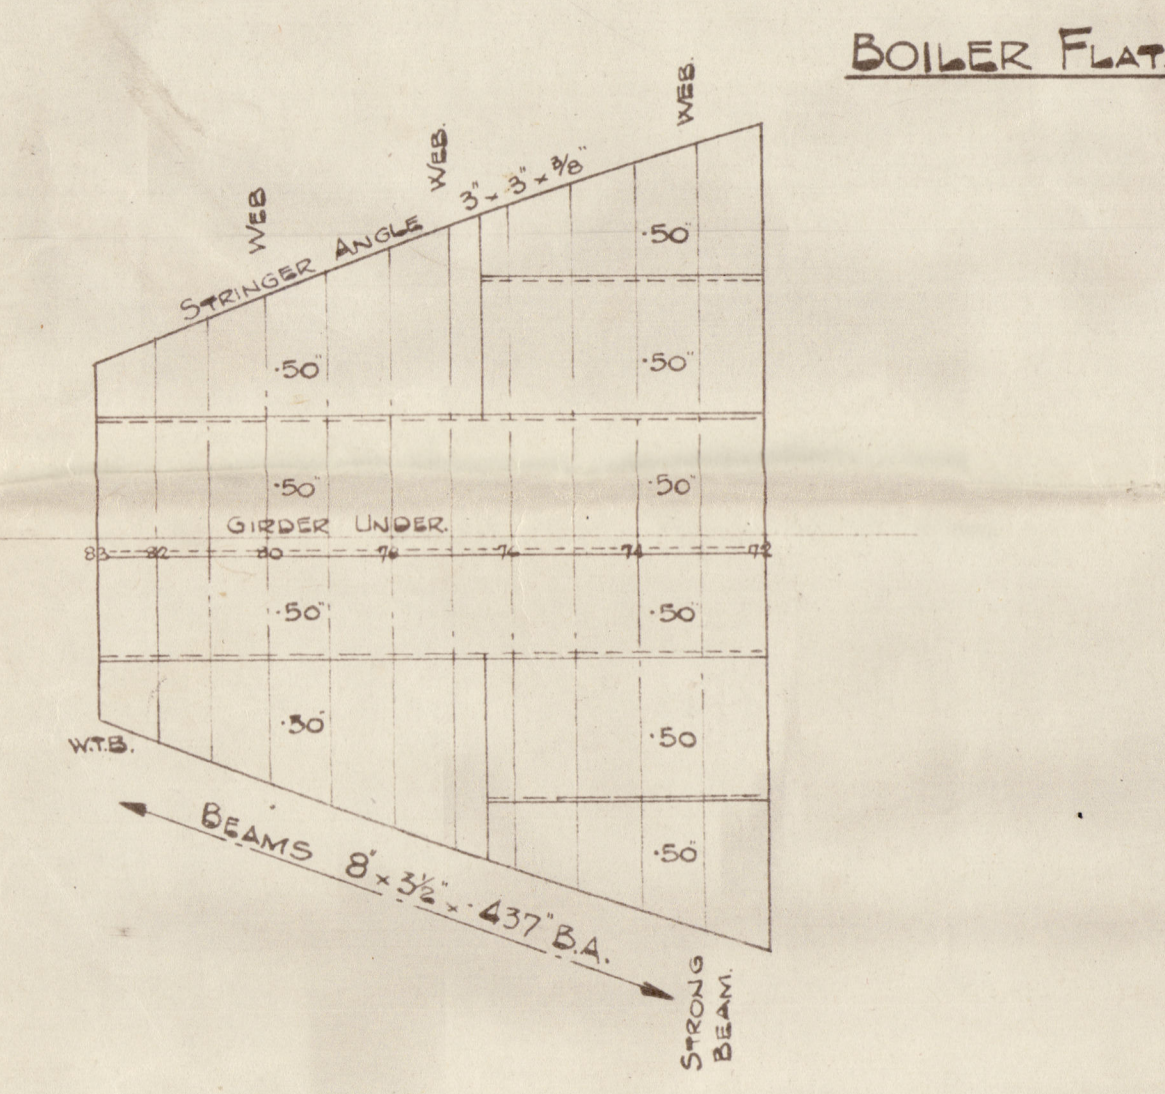
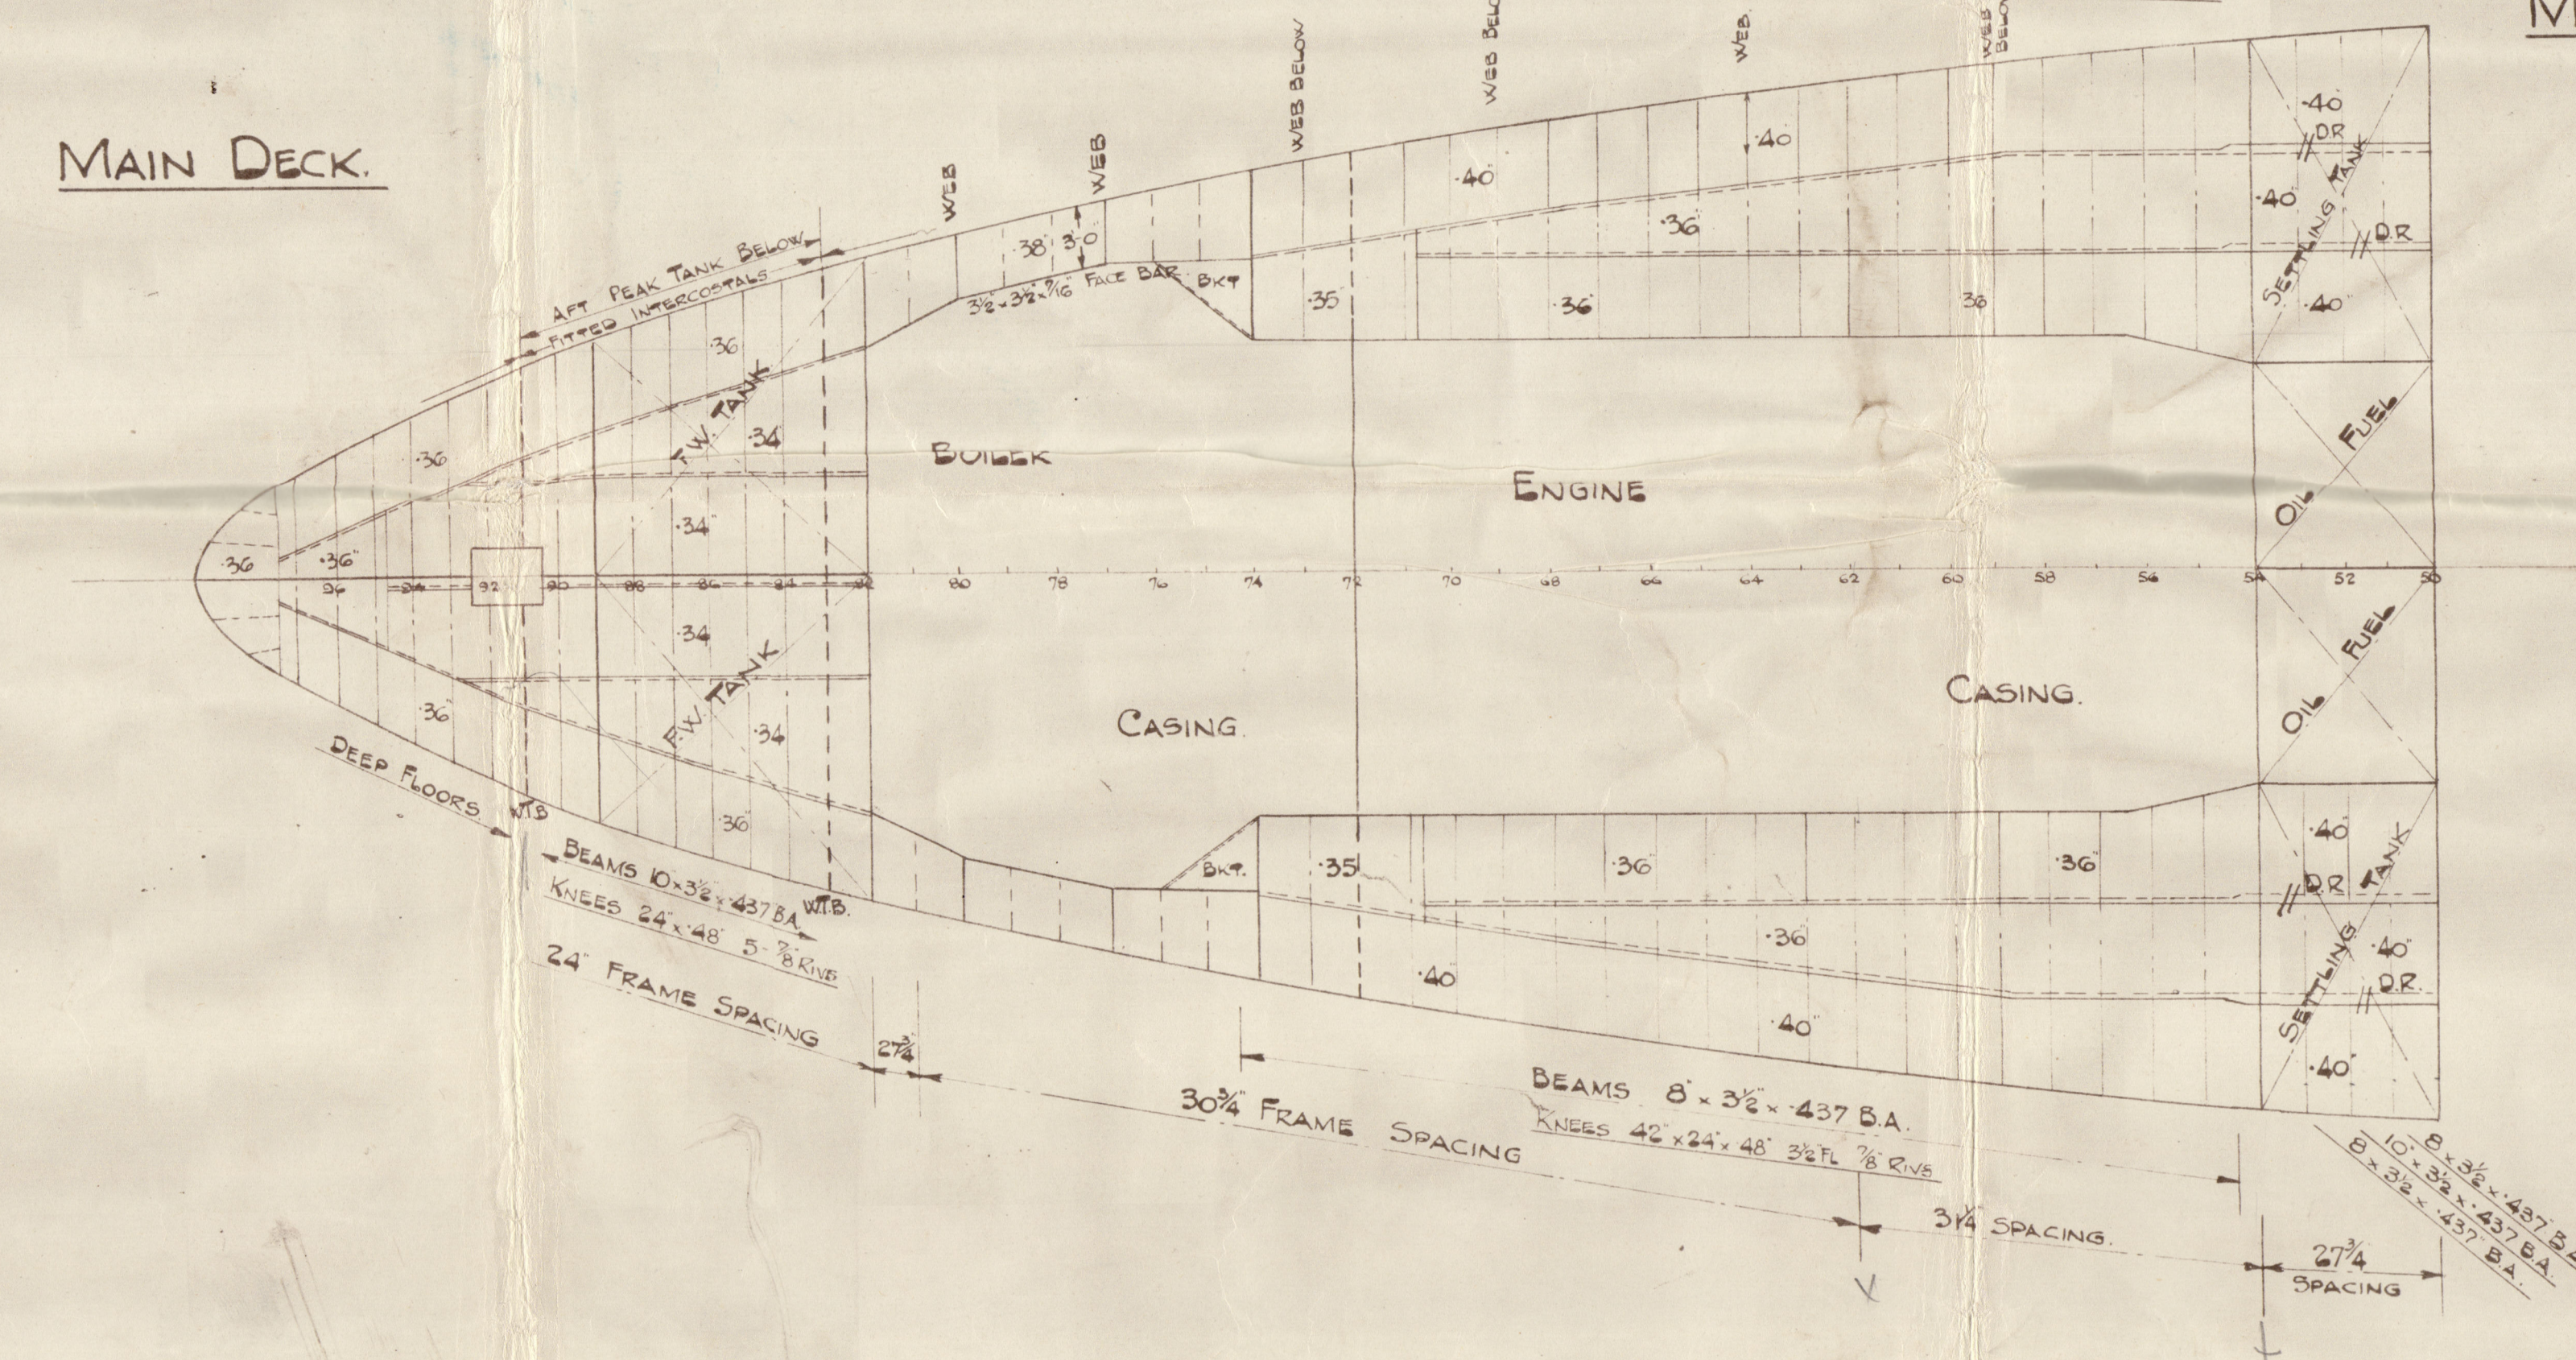
 
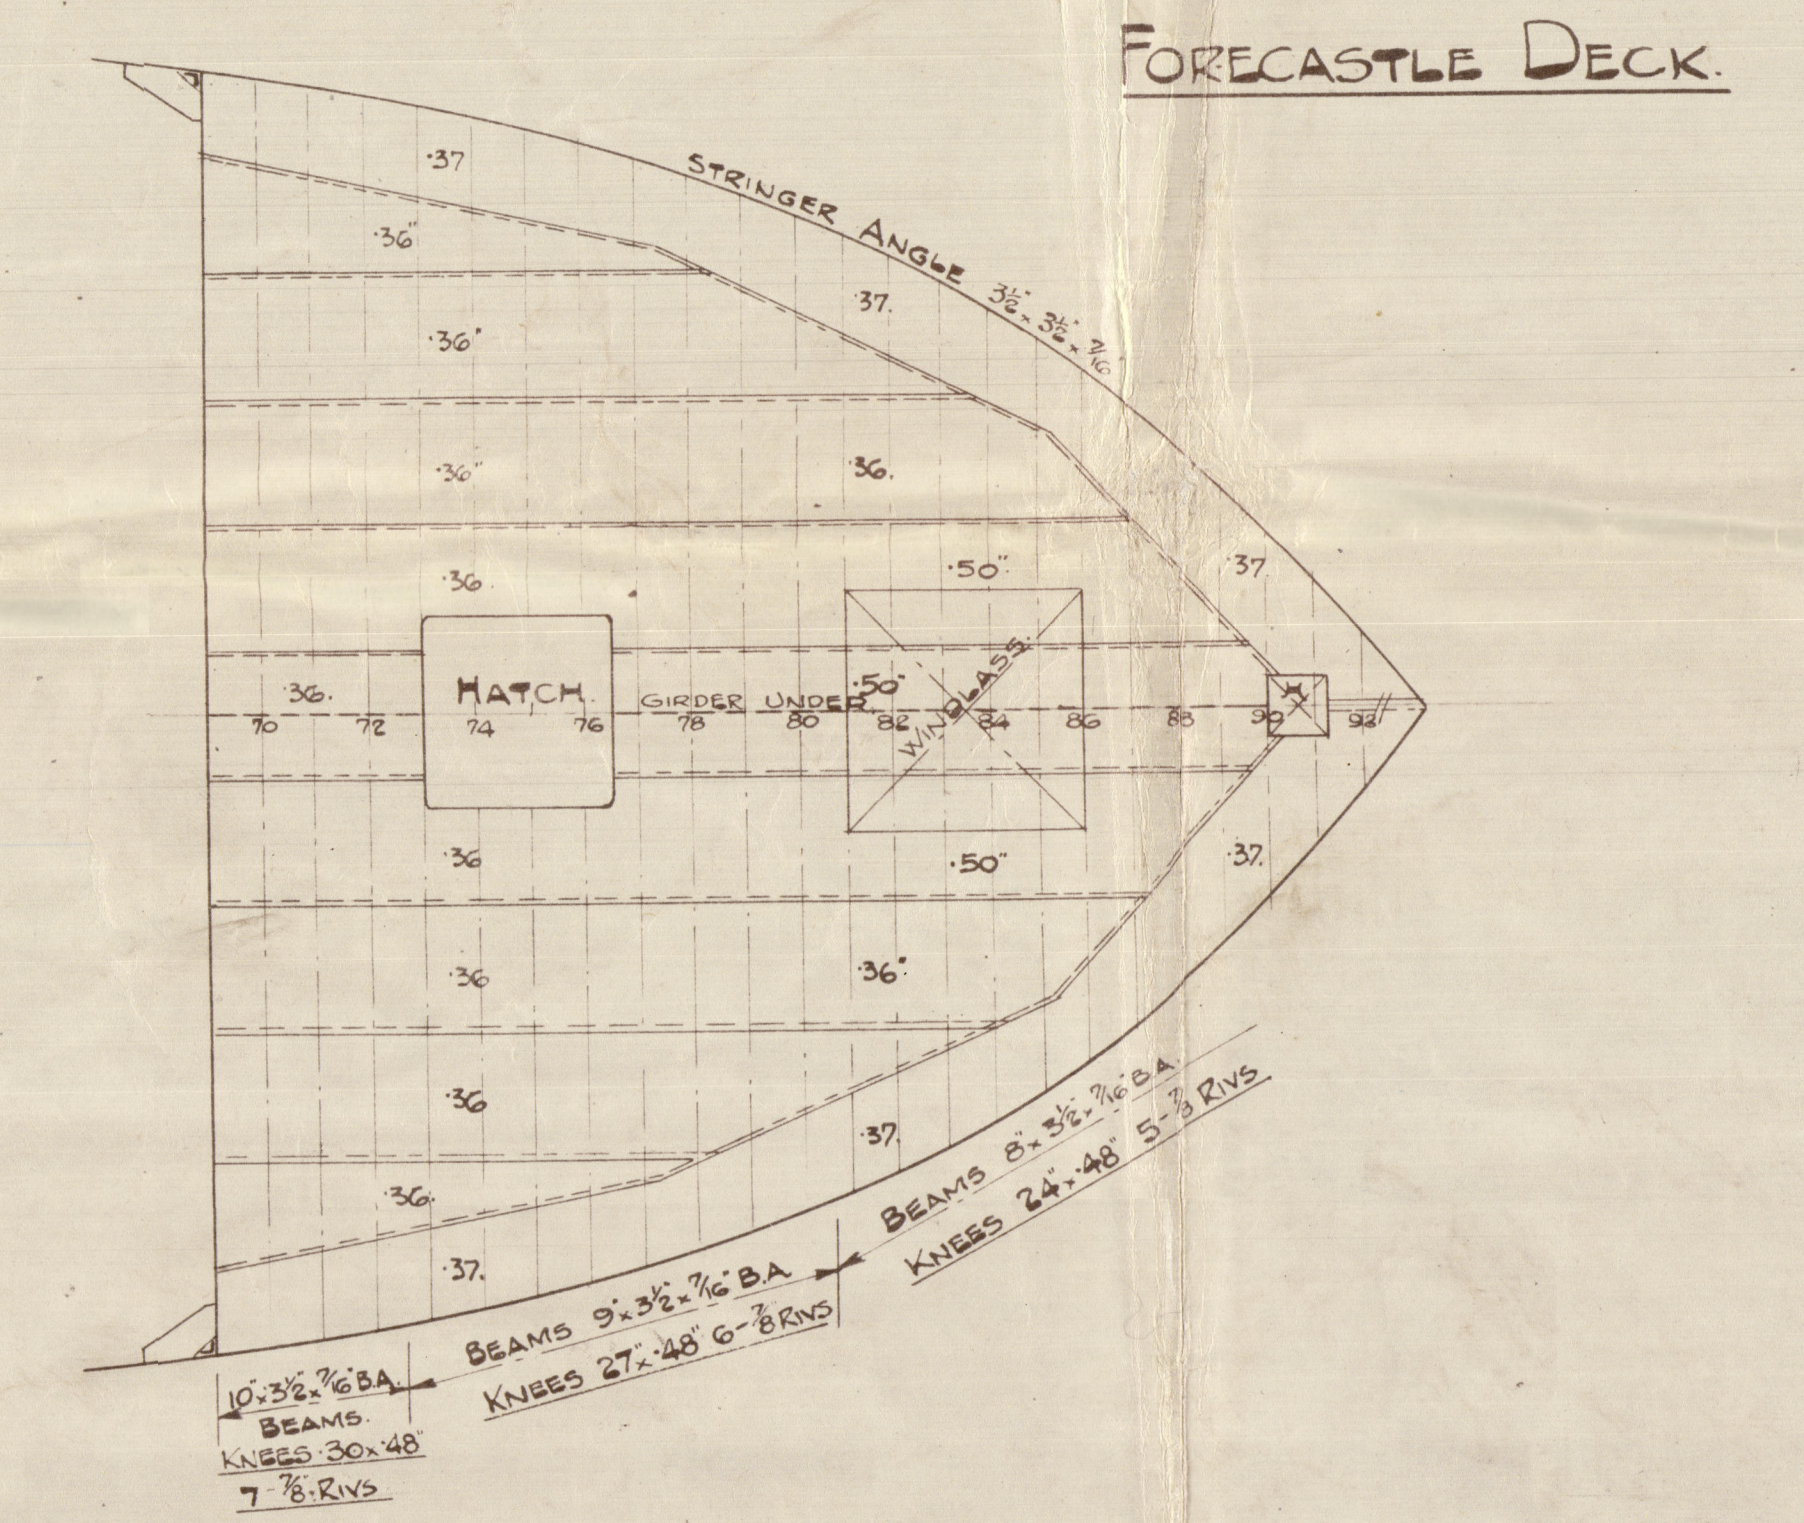
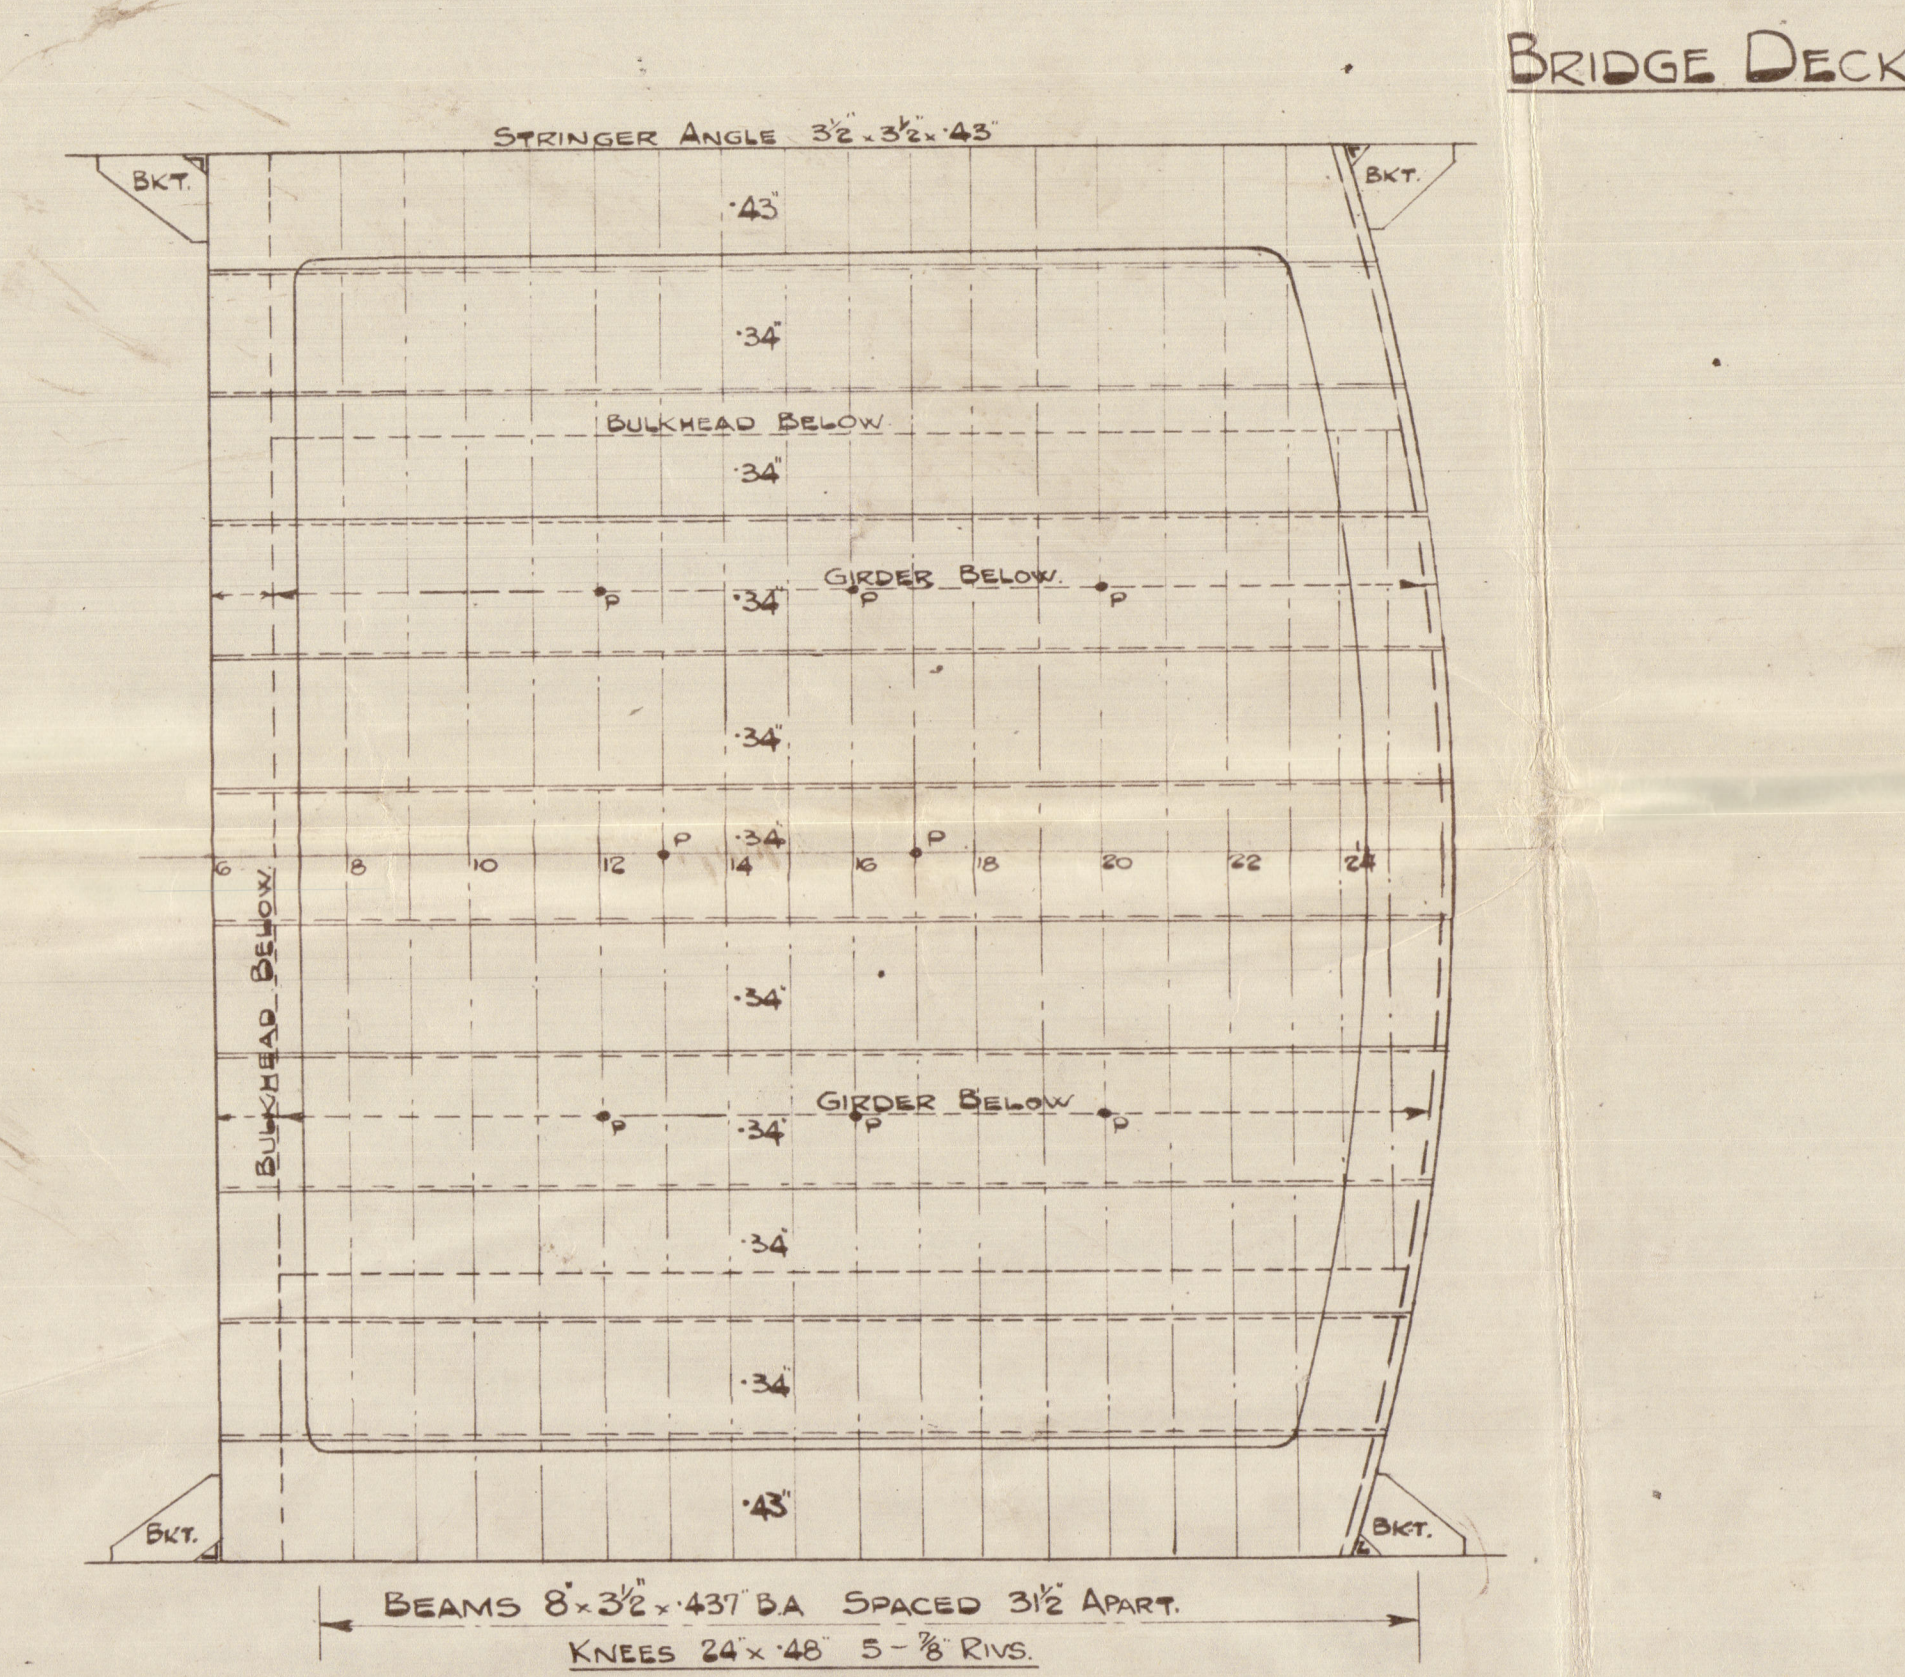


Nº 1173.
PLAN OF STEEL DECKS.

DIMENSIONS 460'-0" B.P x 59'-0" MLD. x 34'-0" MLD.

SCALE $\frac{1}{8}'' = 1 \text{ FOOT.}$

TO CLASS LLOYDS 100A.1 "CARRYING PETROLEUM IN BULK"

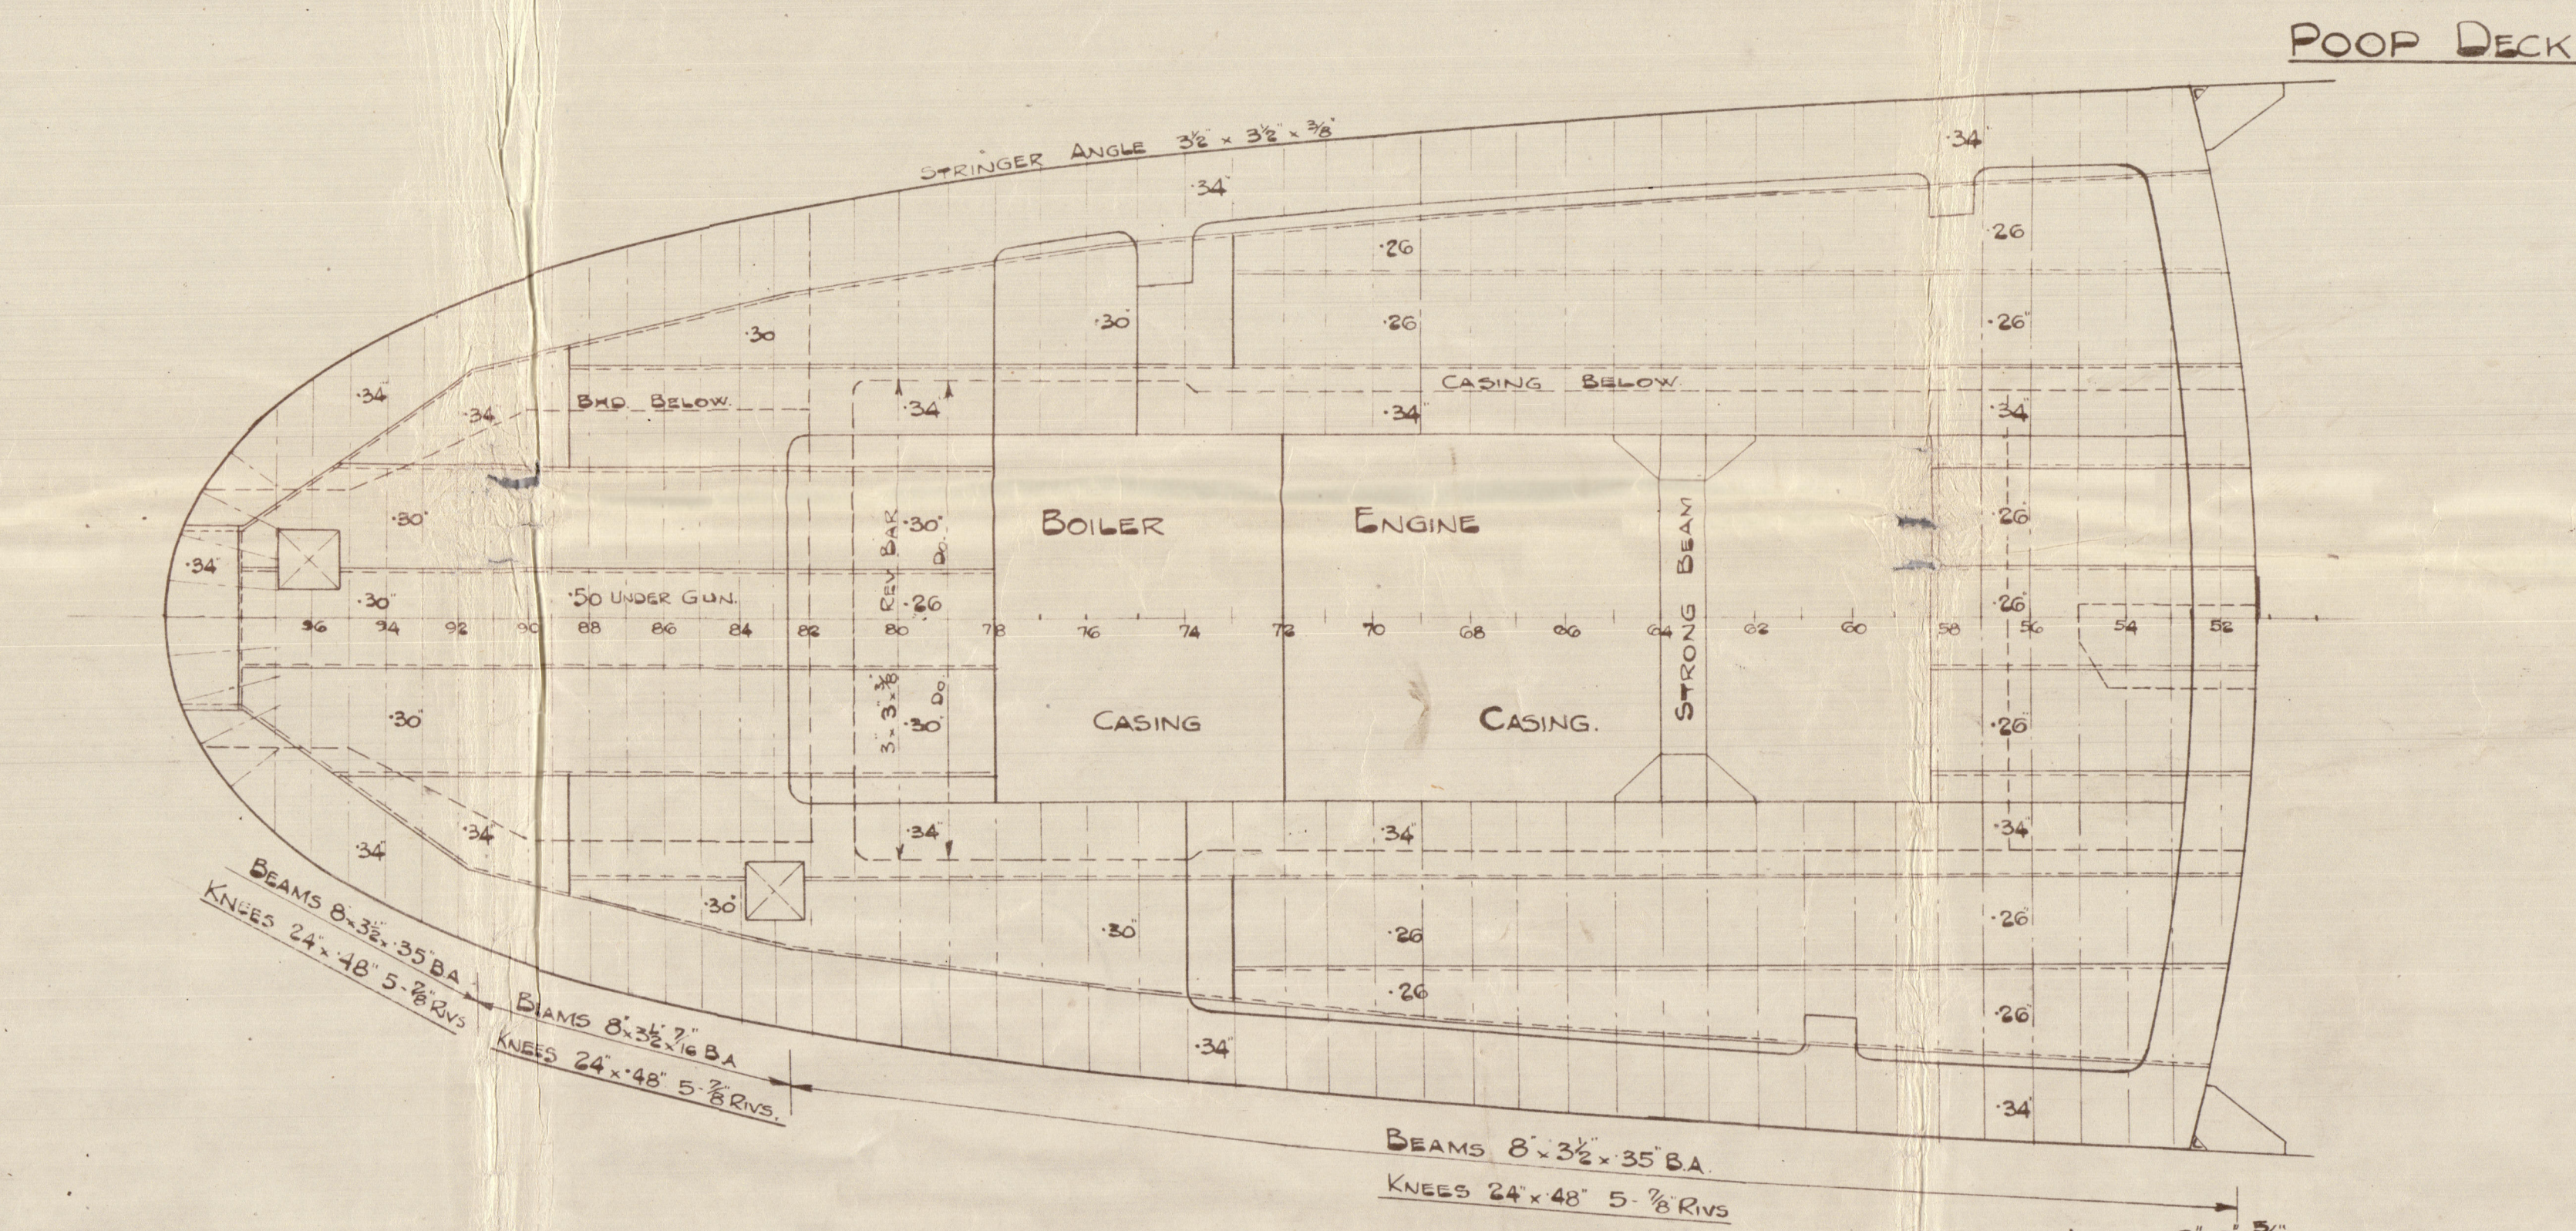

see fly plans
for main deck forward
1194-5 119819

MAIN DECK


W.S.
22.1.42.
Lloyds
4.7.

See page 100
for main details
1194-5 1198-9

HARLAND & WOLFF LTD.
BELFAST

No. 1173 1194 1195
TITLE Steel Deck

DATE APPROVED 22-1-42

1173 Belfast Report No. 13536 - "Nanica" 

Capt. G. S. M.

1194

20

13626 - Nomsca

13662 - Nassarius

1195

Look through
1246



© 2020

Lloyd's Register
Foundation