

177 NOV 1951

Rpt. C. 11 (Contd.)

Index No.




Lloyd's Register of Shipping.

Ship's Name M.V. "FREETOWN"

Official No. 149667

Memorandum of alterations reported since ship was surveyed for assignment of Load Lines in

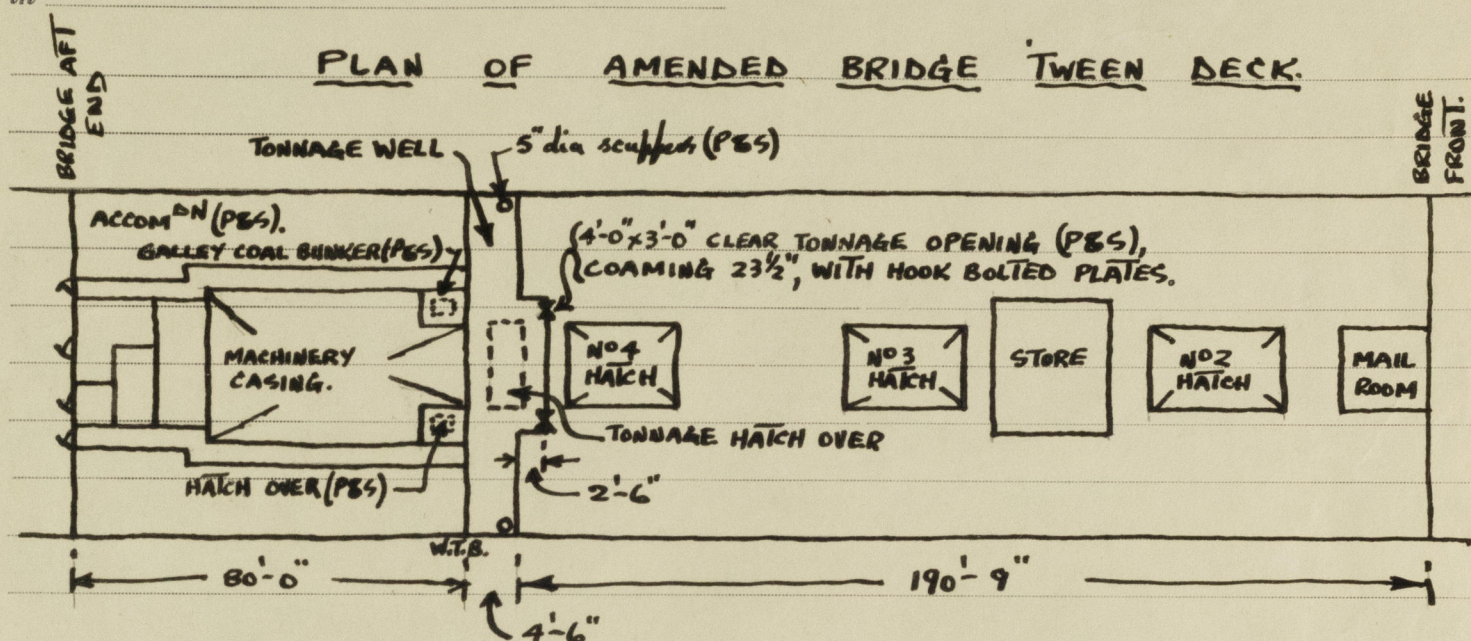

The coamings, doors and covers of Nos 2, 3 and 4 freeboard deck hatchways remain as originally reported.

Bridge Deck: Tonnage hatch fitted, 18'-2" x 4'-6", coaming 9" bulb plate E.W. to deck, hatch fitted with efficient temporary wood covers secured by lashings.

2 hatchways fitted (I.P.&S.), giving access to galley coal bunkers, hatchways 24" x 24", coamings 24" high x 3/8" thick, with steel watertight covers 1/2" thick, secured by 2 hinges and 4 toggles. Sectional area of deck plating maintained by fitting doubling plates.

In Bridge Space: 2 - 5" dia scuppers (I.P.&S.) now fitted in tonnage well, with S.D. automatic N.R. valves operated from the bridge deck and fitted with indicators to show if valve is open or shut. 6 side scuttles (P&S) in bridge space amidships now removed and shell openings blanked with welded steel plates.

22 - 12" dia. side scuttles (I.P.&S.) now fitted in way of accommodation abreast machinery casing, all with permanently attached deadlights of substantial construction.

Sanitary Discharges: Port side amidships, 1-1 1/2" dia, 1-2" dia, and 1-4" dia storm valves removed and shell openings blanked.

2 - 3" dia storm valves (I.P.&S.) fitted in lieu of above.

From new accommodation in bridge space abreast machinery casing

Port side:- 1-4" dia, and 2-2" dia storm valves fitted.

Starboard side:- 1-4" dia, 1-3" dia, 2-2" dia storm valves fitted.

Storm valves of brass, substantially constructed, fitted to shell below upper deck.

Aft end Bridge: Openings - (from port to starboard).

① Port outboard 4'-6" x 2'-3", coaming 23". ② Port inboard 4'-10" x 2'-6", coaming 19 1/2".

③ Starboard inboard 4'-9" x 2'-10", coaming 21 1/2". ④ Starboard outboard 4'-6" x 2'-3", coaming 23".

Nos 1, 3, 4 - hinged wood doors, operated from both sides, of substantial construction.

No 2 - hinged steel door, operated from both sides.

Port Front: Opening, port side, to carpenter's workshop 4'-6" x 2'-3", coaming 21". Steel hinged door, opening forward, operated from both sides.

Plans of above placed on board.