



# SMITHS DOCK LAKE VESSELS

SCALE 1 IN. = 1 FT

Refused to take - 1/27/27  
6/1/27

6-1-27

8 JAN. 1927

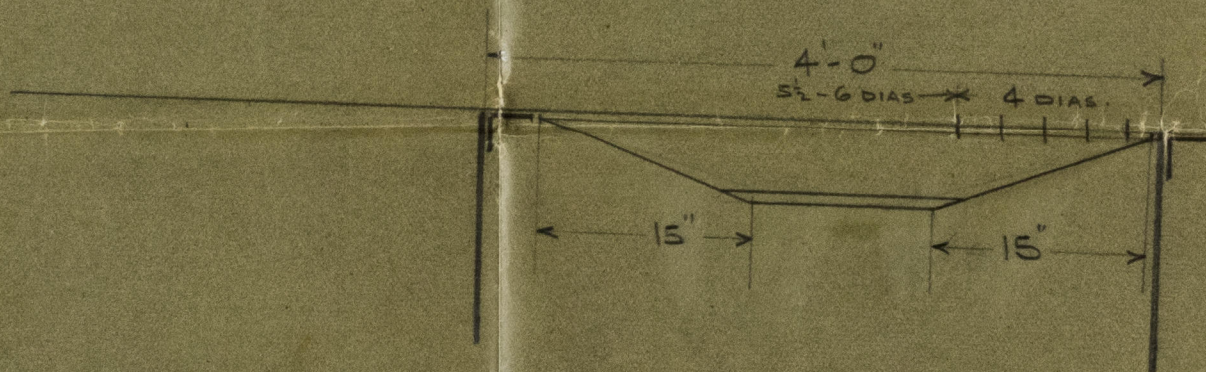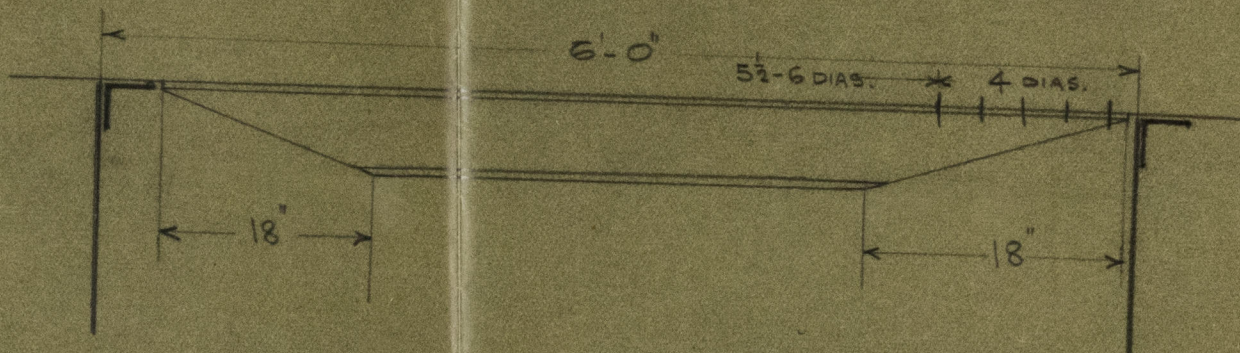

See letter from N/C

18/1/27



© 2020

Lloyd's Register  
Foundation


9600-500200-167200



SMITHS DOCK LAKE STRS

SNIPING AT ENDS OF F & A

STIFFENERS ON D.B.

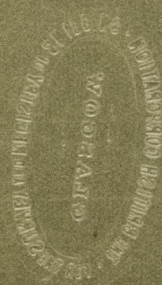

NOT A B



2.22  
10.00  
12.22



© 2020

Lloyd's Register  
Foundation