


S. S. N° 143.

PLAN OF RUDDER.

TO BRITISH CORPORATION.

SCALE: 1" = 1 FOOT.

SPEED 10 KNOTS.

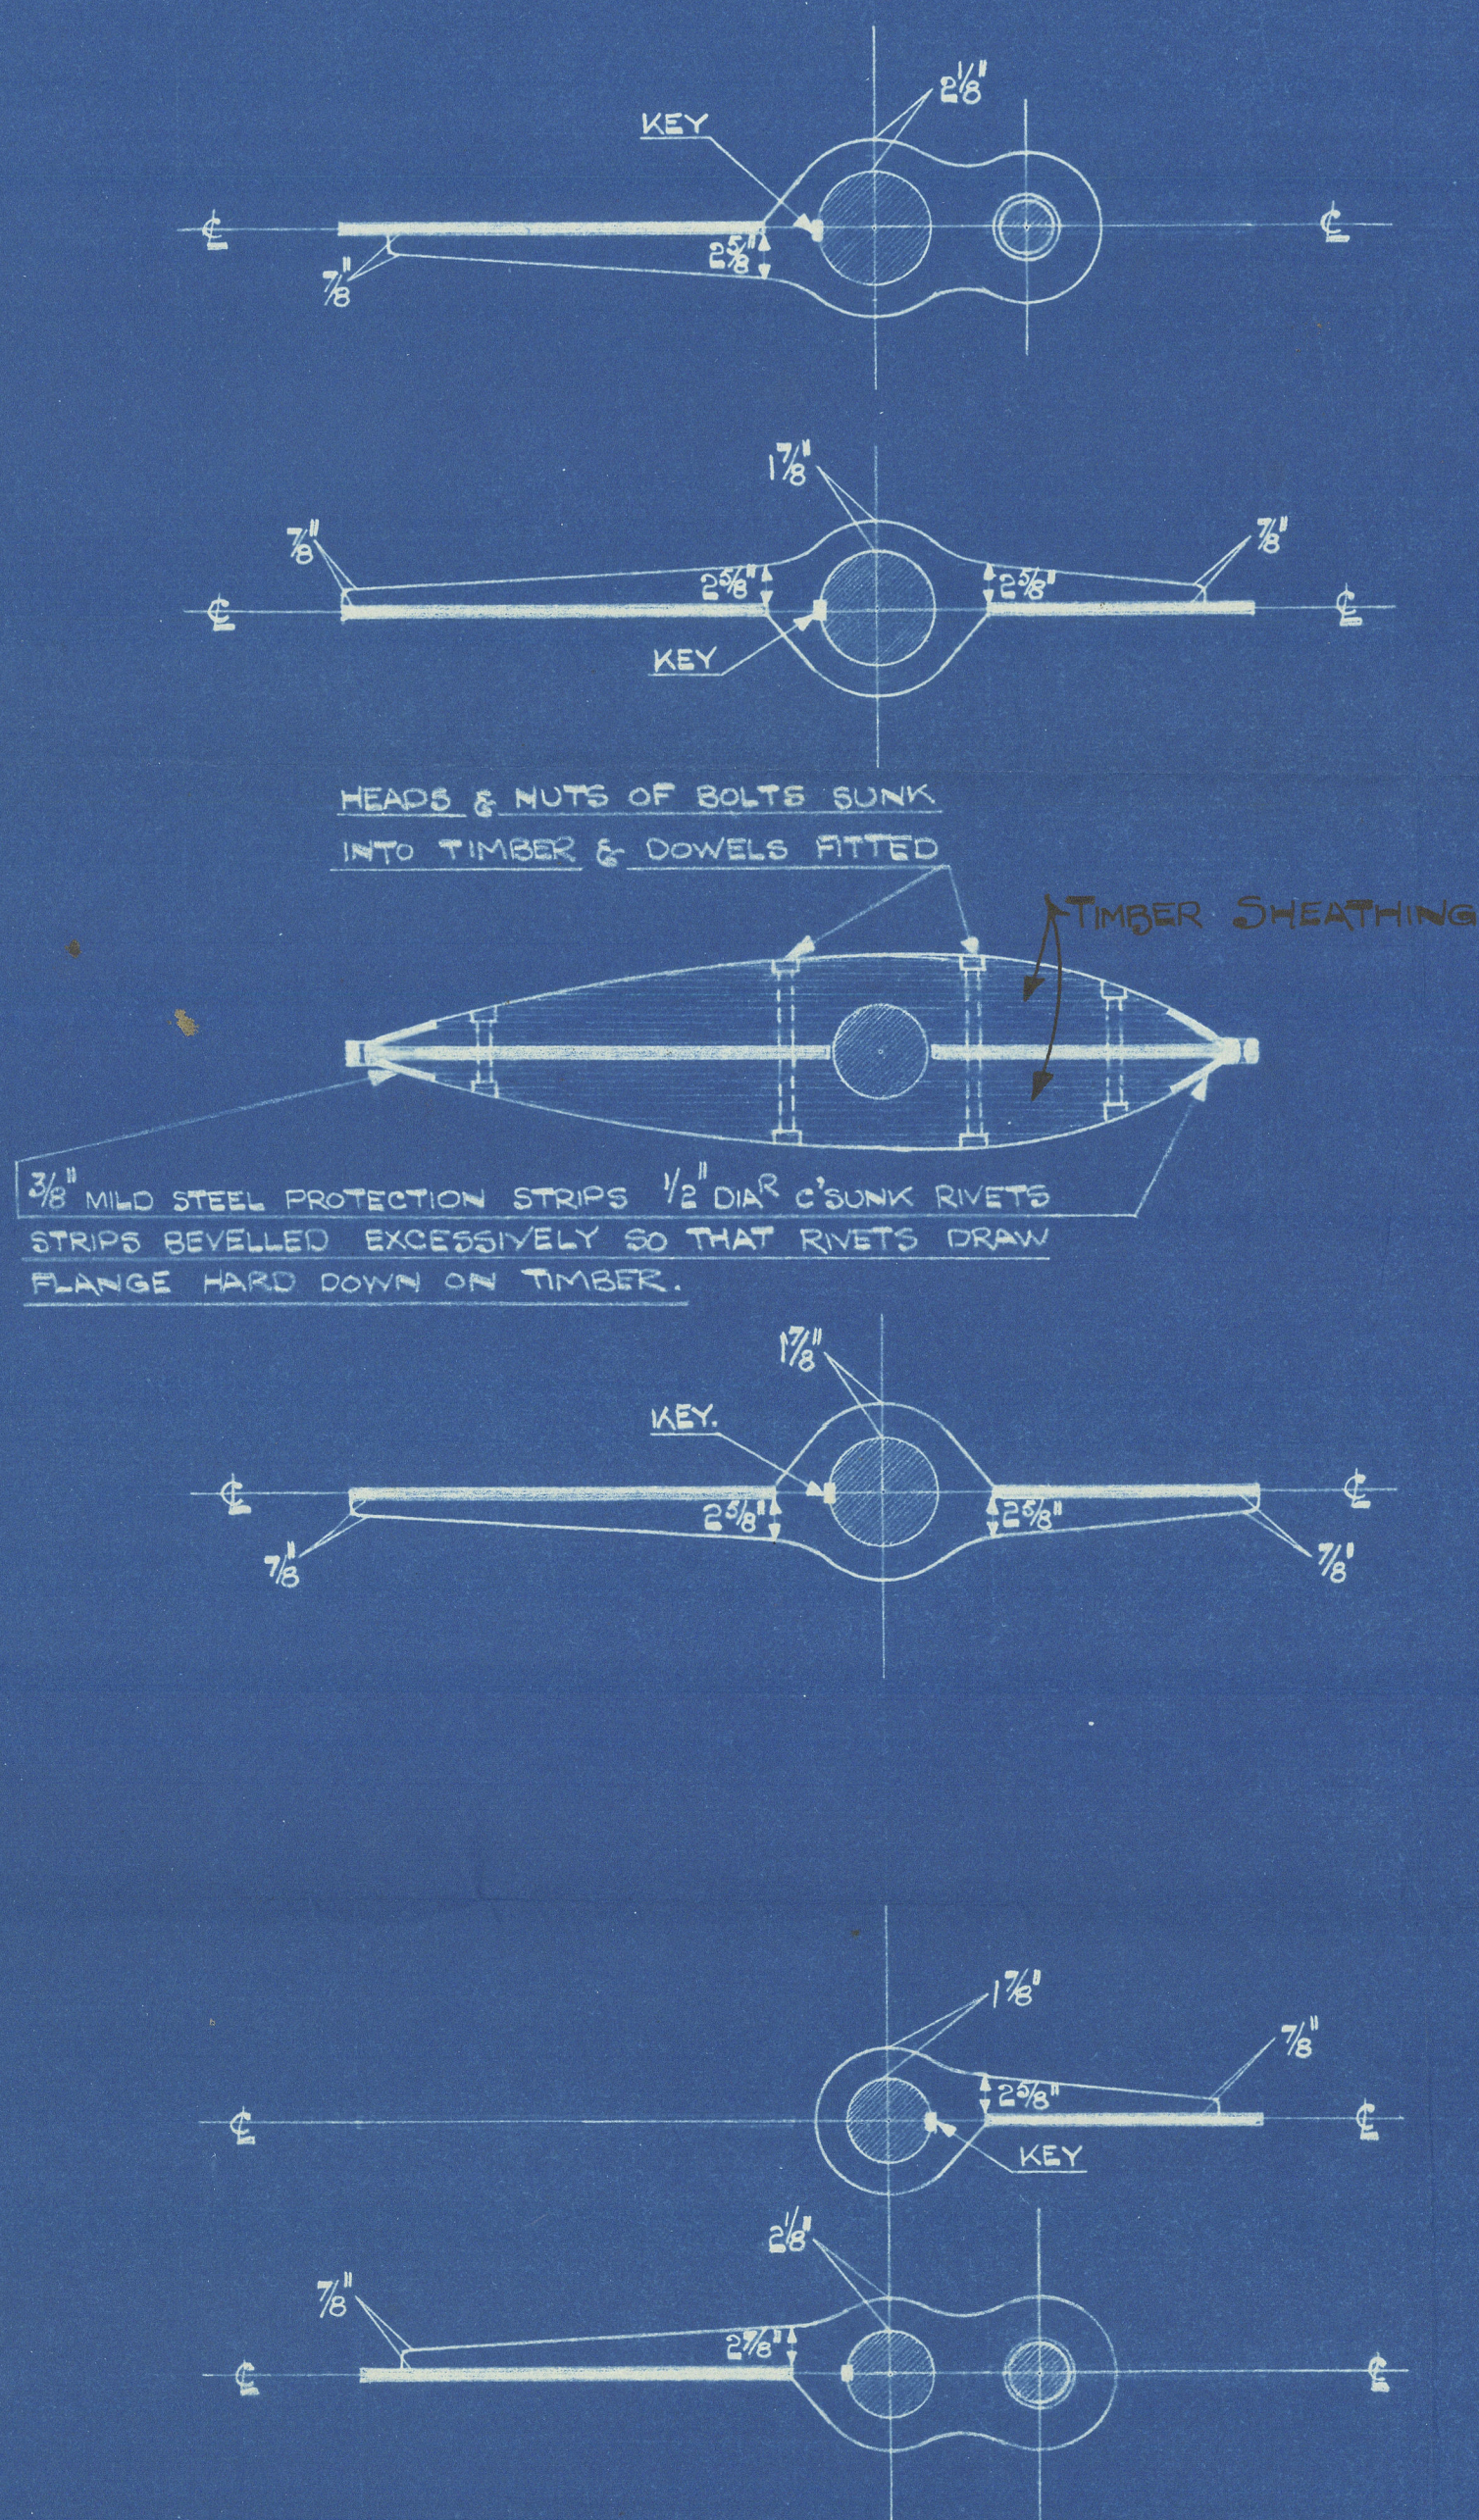

NOTE: NUMBER OF RIVETS IN ALL ARMS
AS INDICATED ON PLAN.

22

Rudder Stan


J Lewis Sons.

No. 143.

22.12.26.

GLEN FARG.

Call me on 119

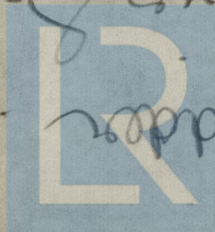

© 2020

Lloyd's Register
Foundation

002947-603005-0197