



NOV 1 1926

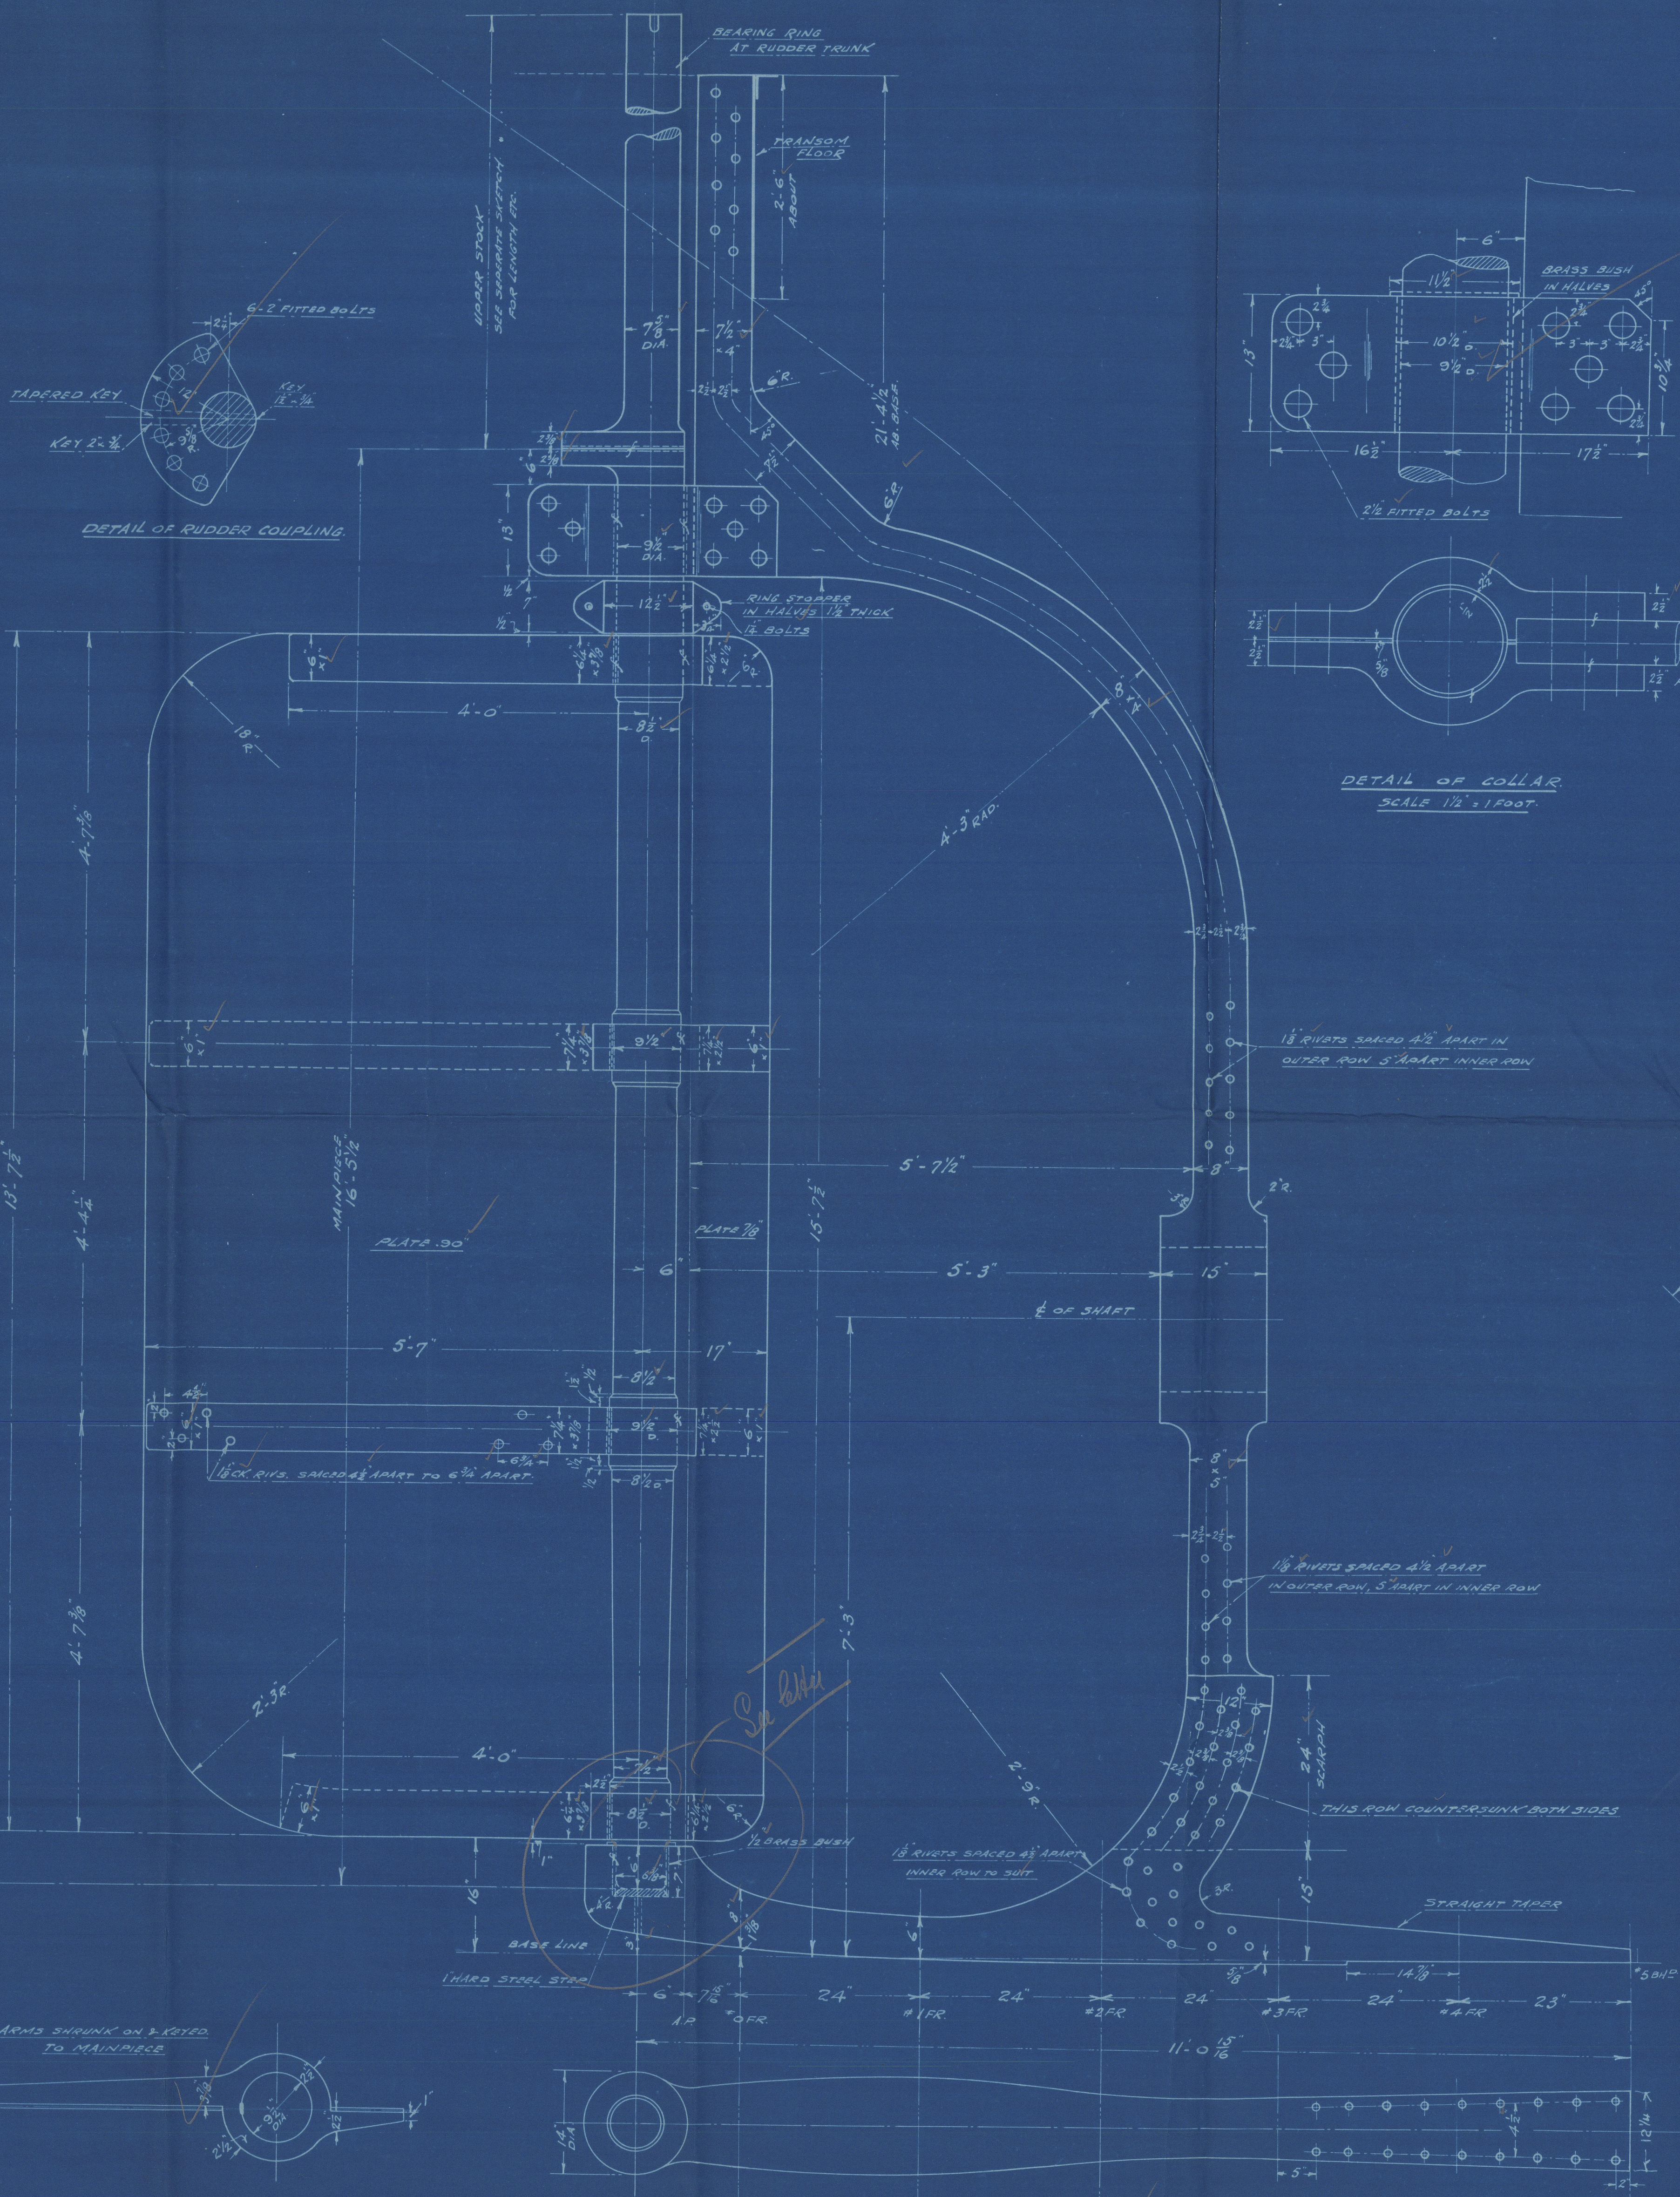

Bay.

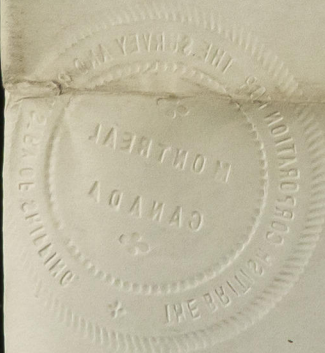

© 2021

Lloyd's Register
Foundation

11.

Rudder & Sternpost

Midland

18 & 19.

6 - 11 - 26

"City of Hamilton"

"City of Montreal"

003006-003012-0078



© 2021

Lloyd's Register
Foundation