

(As built.)  
R.Q.D. COASTER No 375 S.S. "CLARA MONKS."

LONGITUDINAL SECTION AND DECK PLAN.

LENGTH B.P. 170'-0", BREADTH M<sup>D</sup> 26'-0", DEPTH M<sup>D</sup> TO UPPER D<sup>K</sup> 13'-0".

TO QUARTER D<sup>K</sup> 16'-7"

SCALE: 1/4" = 1 FOOT.

LLOYD'S NUMERALS.


UPPER D<sup>K</sup>. QUARTER D<sup>K</sup>.

TRANSVERSE No. 39

LONGITUDINAL No. 6630

L/D 13-07 10-25

d 11-54 15-12

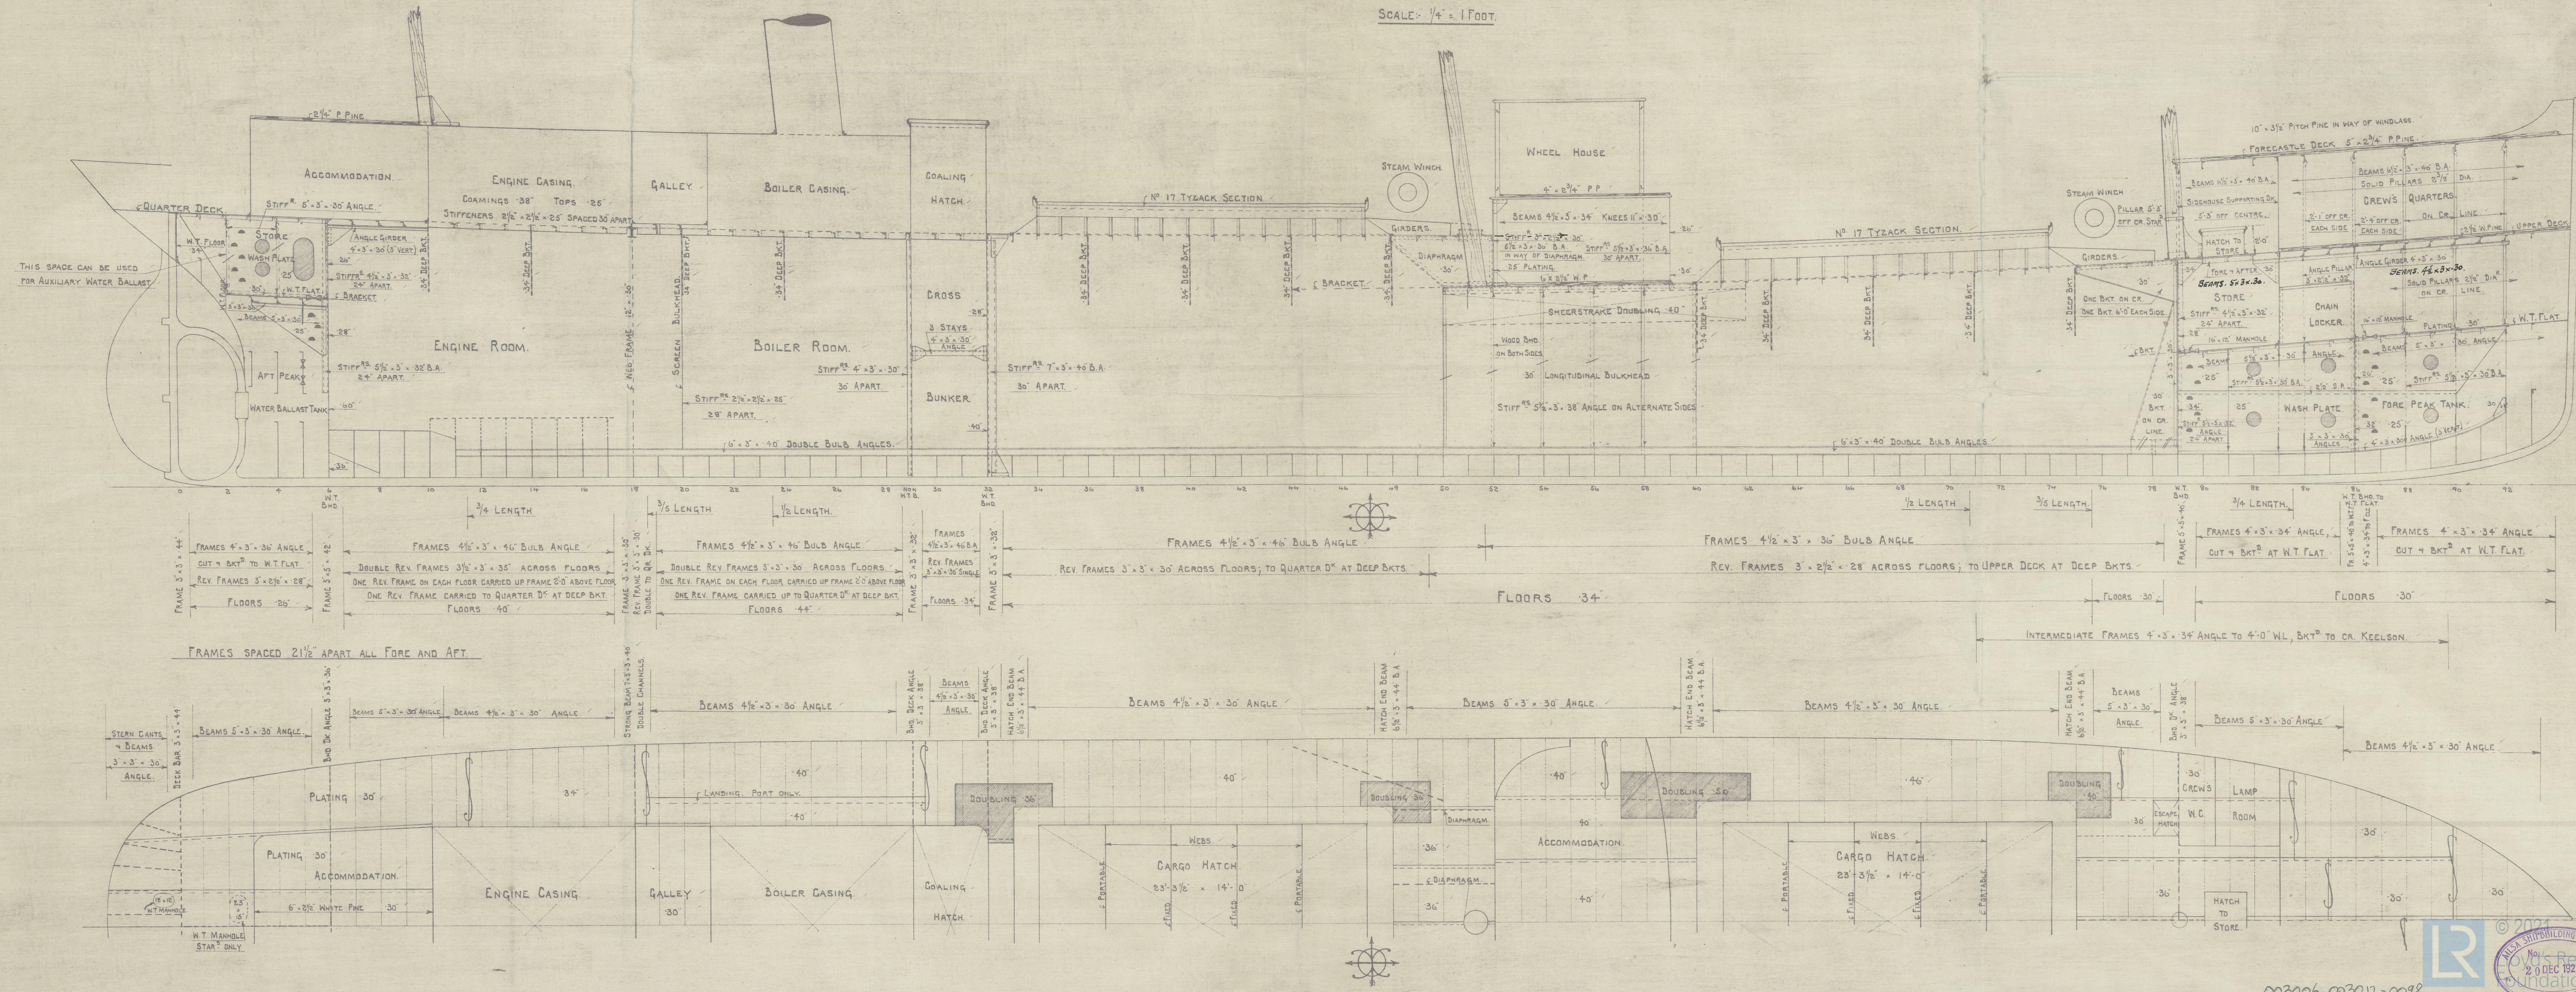

003006-003012-0098



Aelsa Bo.

No. 375.

S/S. "CLARA MONKS."

Profile.

(As built.)

GLASGOW REPORT NO. 40715.

003006-003012-0098



© 2021

Lloyd's Register  
Foundation