
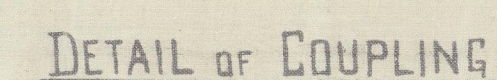


PINTLES TO BE SUPPLIED BY RUDDER SUB-CONTRACTOR.

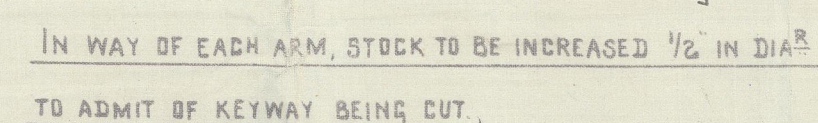

SCALE, 1" = 1 FOOT.

6 BOLTS 1/4" DIA^R. NUTS TO BE IN PROPORTION
TO DIA^R OF BOLTS AND FITTED WITH SPLIT PINS
TO PREVENT TURNING.

DIA^R OF STOCK IS 1/4" IN EXCESS OF
LLOYDS PER OWNERS REQUIREMENTS.

OVERALL LENGTH 22'-7 1/2" APPROX. (CORRECT WEIGHT WILL BE GIVEN LATER).

20'-0 1/2" APPROX. (CORRECT HEIGHT FROM LOFT)

R. Q. D. COASTER, N^o 375.

STERNPOST AND RUDDER.

SCALE 1 INCH = 1 FOOT.

TO BE OF BEST FORGED SCRAP IRON.

TESTED TO THE SATISFACTION OF LLOYD'S SURVEYORS

LONGITUDINAL NUMBER..... = 66 30 ✓

TOTAL AREA OF RUDDER..... = 41.6 SQ. FEET = A

C.G. ABAFT CR. LINE OF PINTLES... = 1.98 FEET = D.

$$A \times D \quad \text{---} = 82.36$$

SPEED OF SHIP NOT EXCEEDING 10 KNOTS

RIVETS IN STERN FRAME 1" DIA^R SPACED 5" APART 17/16" DIA^R HOLES

RIVETS ABOVE COUNTER $\frac{3}{4}$ " DIA^R SPACED $3\frac{3}{4}$ " APART $\frac{13}{16}$ " DIA^R HOLES

SECTION OF BOSS

APPROVED
LLOYD'S REGISTER OF SHIPPING

Montgomery 30.9.19

DATE 20.1.11

Alba



© 2021

Lloyd's Register
Foundation

Ailsa Co.

No. 375.

Rudder Skynpame.

S/ Clara Monks

GLASGOW REPORT No. 40715

003006-003012-0099



© 2021

Lloyd's Register
Foundation